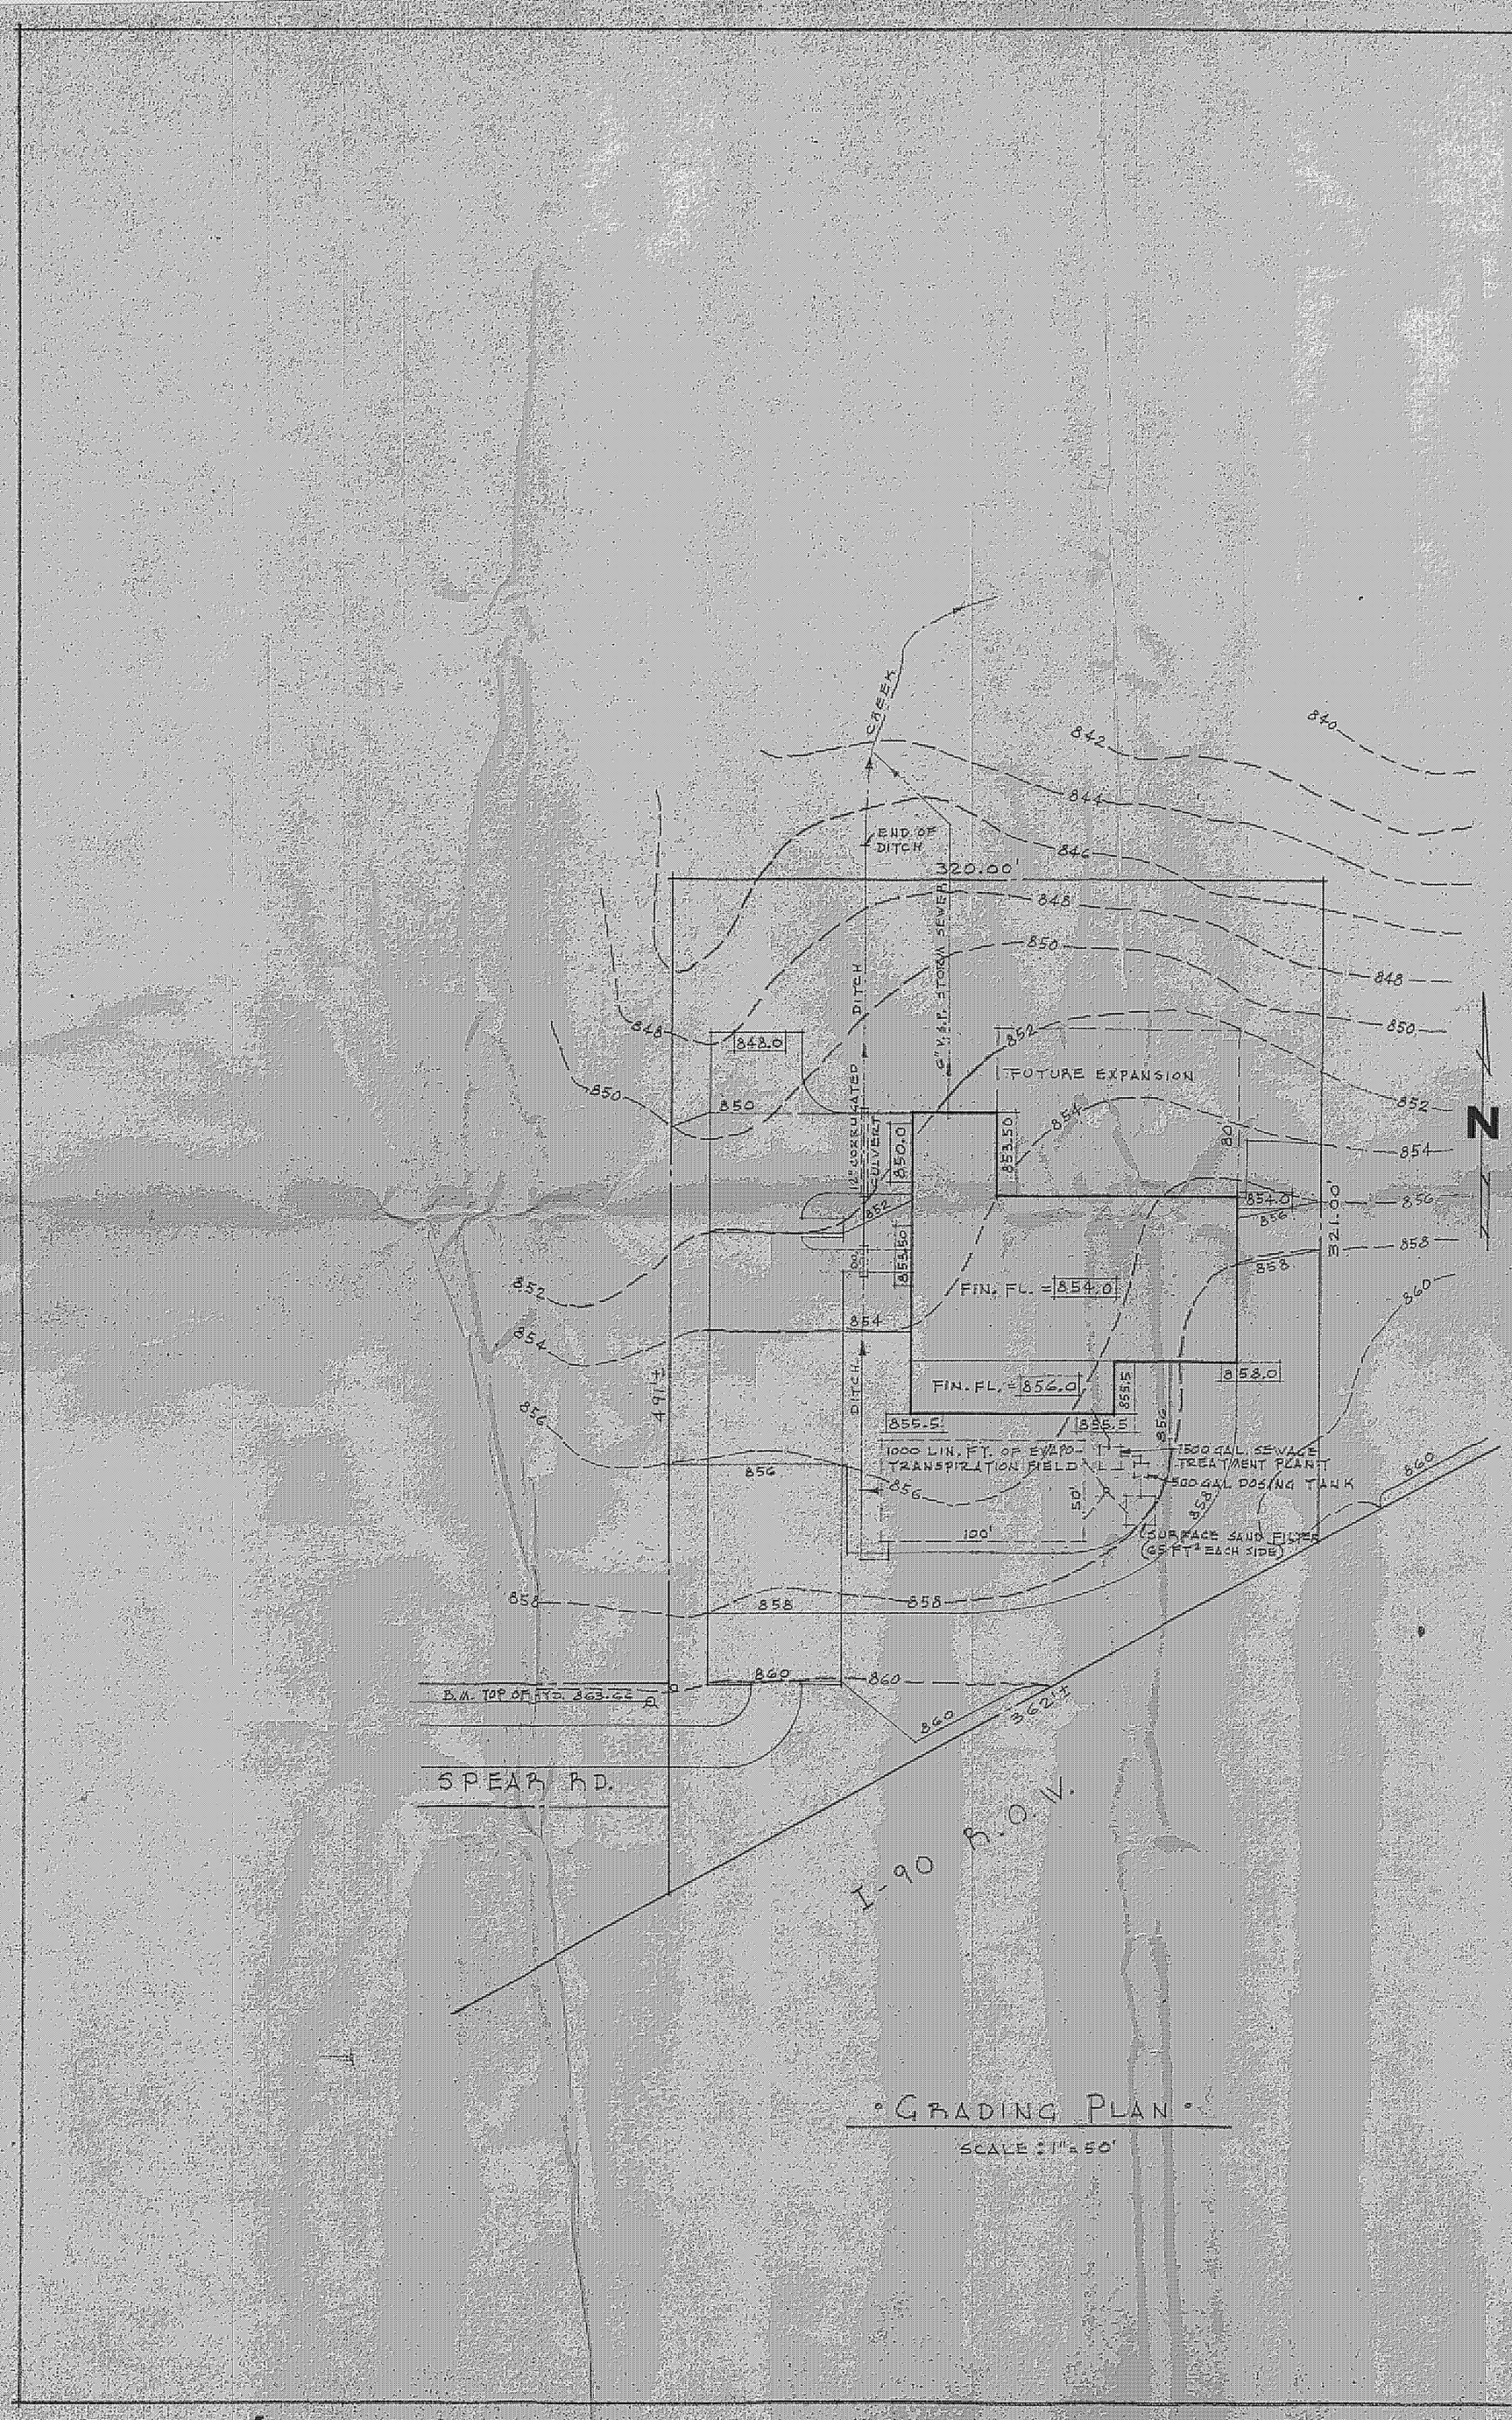

"GRADING PLAN"

SCALE: 1" = 50'

Grading Plan Approved
as shown and/or noted
THOMAS P. GILLES, P.E.
Lake County Engineer
By JWK Date 10-10-23

STATE OF OHIO
MARVIN J. RUKIN
No. 1616
REGISTERED ARCHITECT

REVISIONS

DATE 10-4

SHEET