Grading Plan Approved
as shown and/or noted
THOMAS P. GILLES, P.E.
Lake County Engineer
By JWK Date 8-28-73

Zoning Permit #2556
issued - 8-27-73
[illegible]

NOTE:
ALL UTILITIES SHOWN ARE SUBJECT TO AS-BUILT CONDITION.

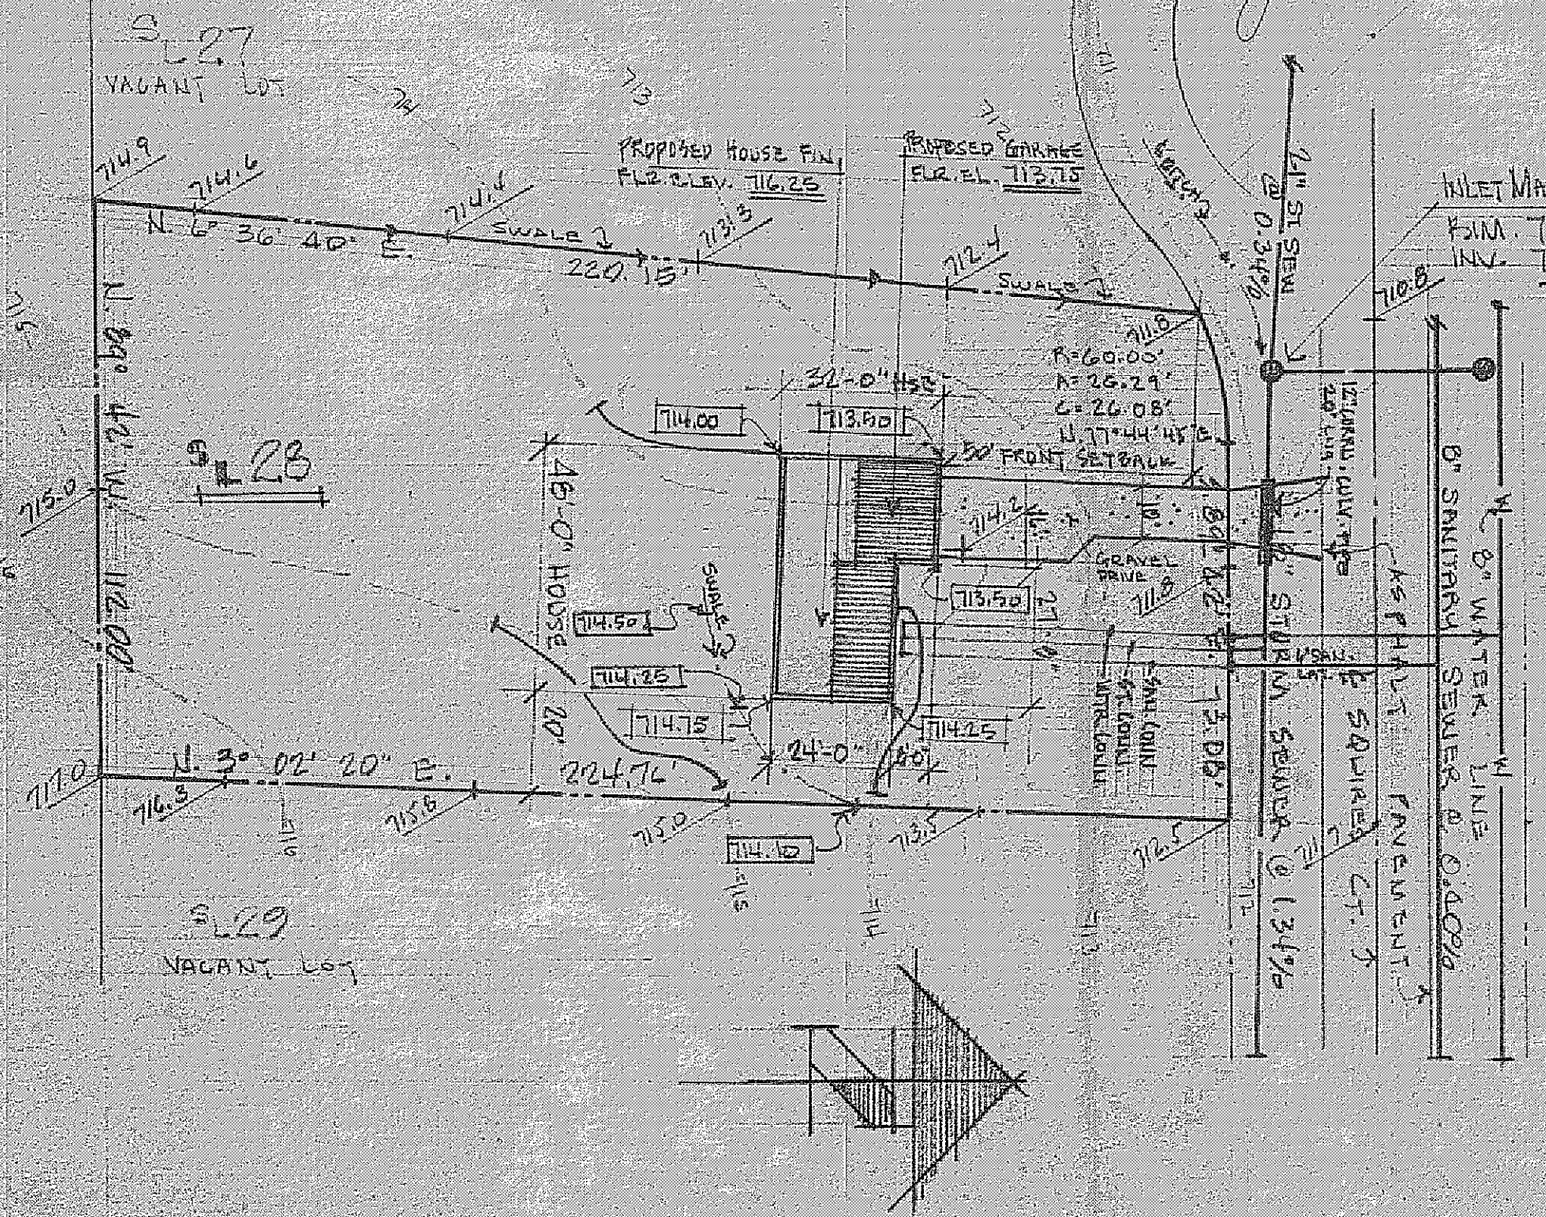

SITE & DRAINAGE PLAN FOR:

RYAN HOMES, INC.
7660 CHIPPEWA ROAD
BRECKSVILLE, OHIO.

BEING SUBLOT NO. 28 IN REVERVE WOODS SUBD. NO. 2 IN CONCORD TWP., OHIO.

PREPARED BY:

WM. R. GRAY ASSOC., INC.
CIVIL ENGINEERS & SURVEYORS
7547 MENTOR AVENUE
MENTOR, OHIO 44060
DATE: AUG. 16, 1973 SCALE: 1"=30' DRAWN BY: [illegible]

CERTIFICATION:

I HEREBY CERTIFY THAT THIS PLAT IS CORRECT TO THE BEST OF MY KNOWLEDGE
BY: Wm. R. Gray
WM. R. GRAY, P.E. #2421, R.S. #2752