SITE & DRAINAGE PLANS FOR:

RYAN HOMES, INC.
7660 CHIPPEWA ROAD
BRECKSVILLE, OHIO.

~~SITE & DRAINAGE PLANS FOR:~~
~~SUBLOT 23~~
SUBLOT 22
SUBLOT 24, ALL IN RIVERS WOODS SUBDIVISION NO. 2 IN LEVERETT TWP., OHIO.

PREPARED BY:

WM. R. GRAY ASSOCIATES, INC.
CIVIL ENGINEERS
SURVEYORS
7547 MENTOR AVENUE
MENTOR, OHIO 44060

DATE: AUG. 22, 1973 SCALE: 1"=30' DRWN. BY:

CERTIFICATION:

I HEREBY CERTIFY THAT THIS PLAT IS CORRECT TO THE BEST OF MY KNOWLEDGE.

BY: Wm. R. Gray
WM. R. GRAY, P.E. #6421, R.S. 2752

NOTE: UTILITIES SHOWN ARE SUBJECT TO AS-BUILT CONDITION

Grading Plan Approved as shown and/or noted
THOMAS P. GILLES, P.E.
Lake County Engineer
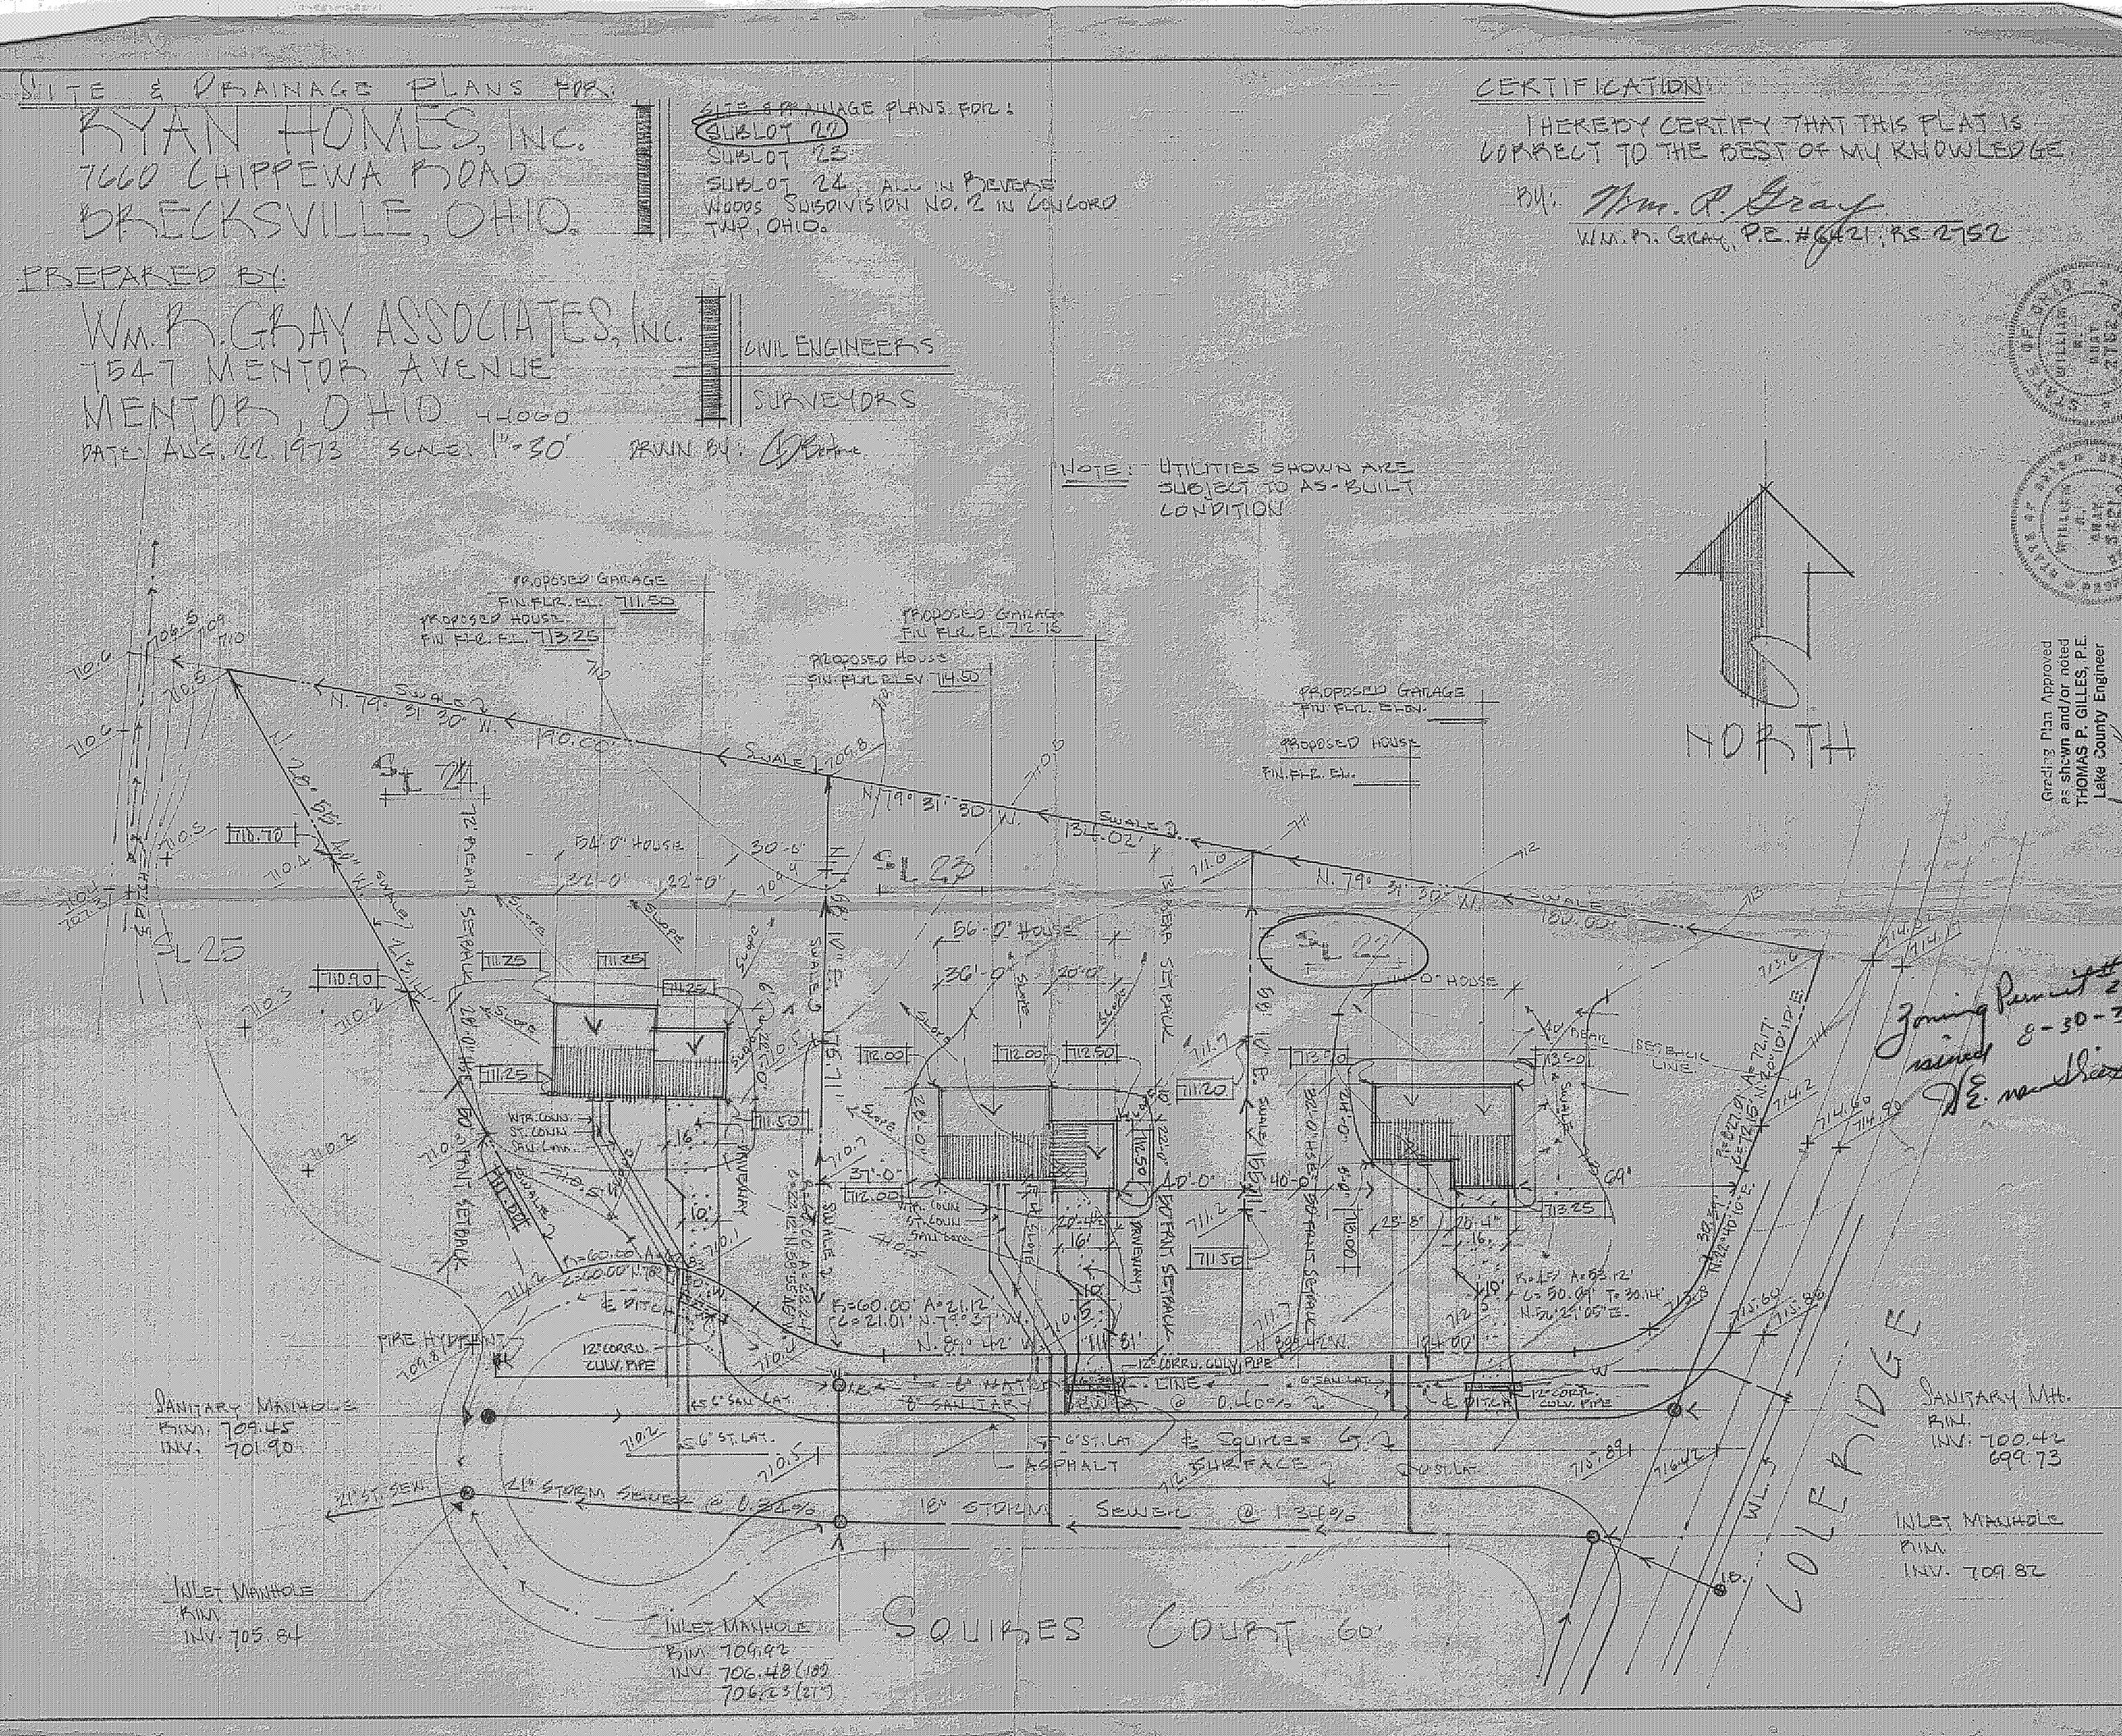
Zoning Permit issued 8-30-73 DE. mackie