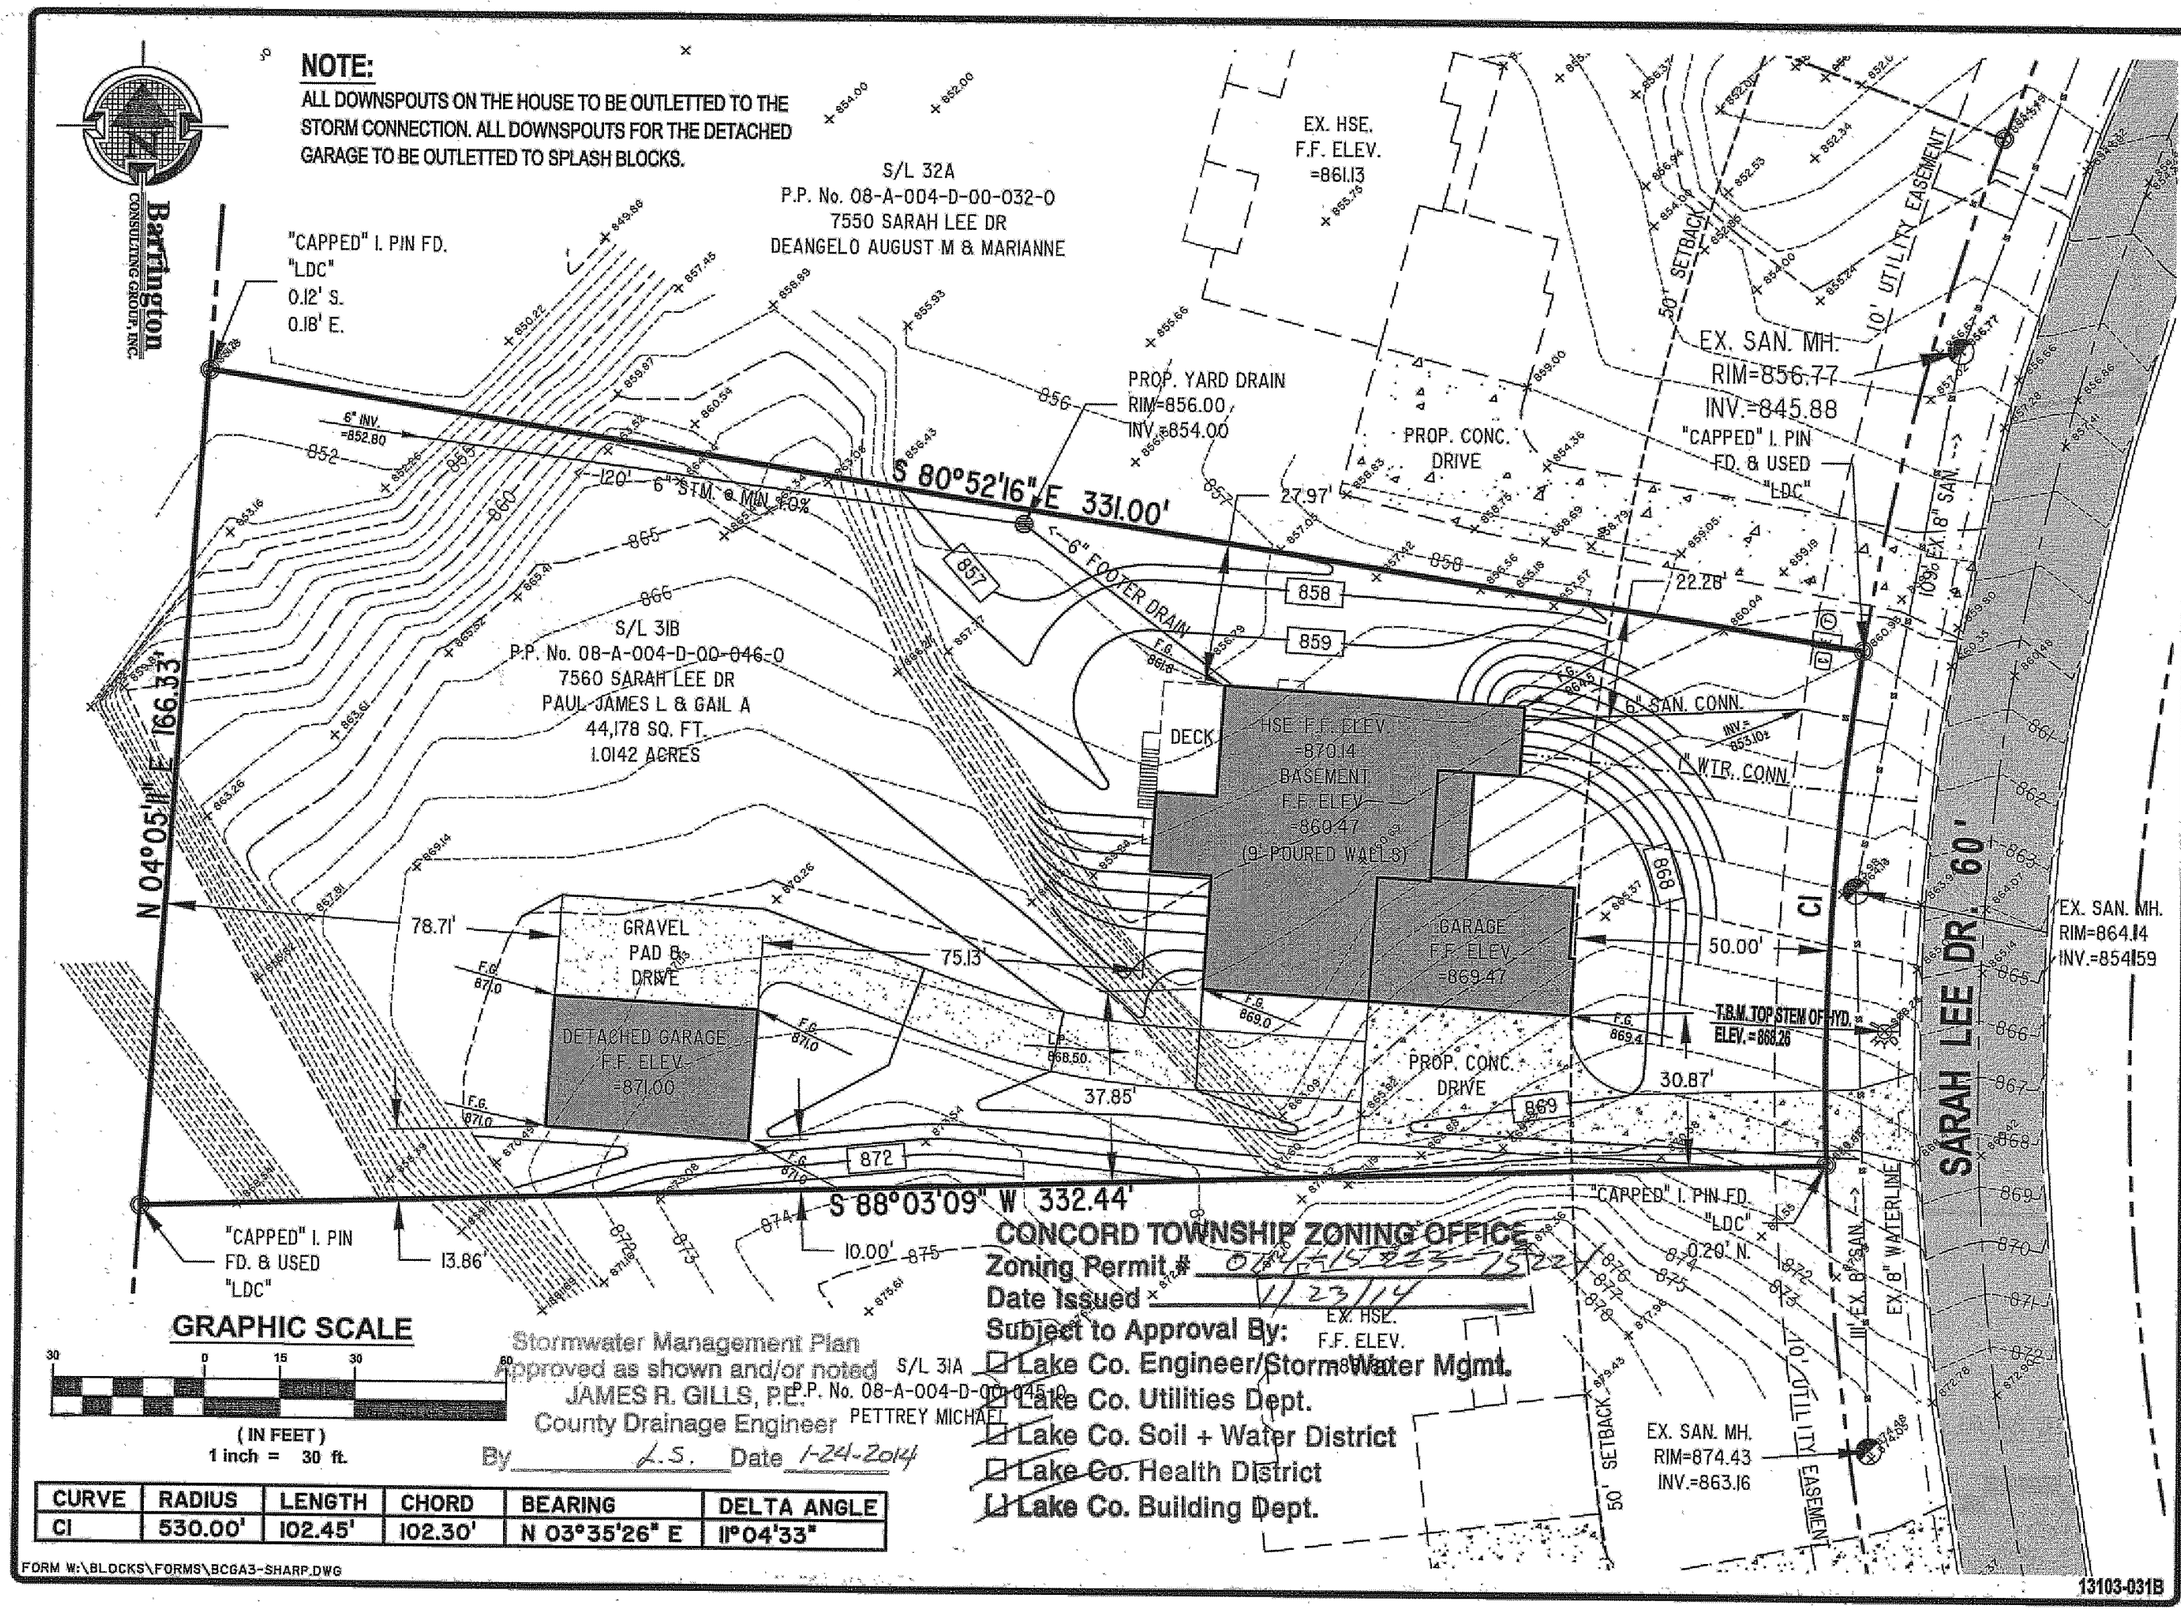

Stormwater Management Plan
Approved as shown and/or noted
JAMES R. GILLS, P.E.
County Drainage Engineer
By L.S. Date 1-24-2014

CONCORD TOWNSHIP ZONING OFFICE
Zoning Permit # 0114-15223-15224
Date Issued 1/23/14
Subject to Approval By:
☐ Lake Co. Engineer/Storm Water Mgmt.
☐ Lake Co. Utilities Dept.
☐ Lake Co. Soil + Water District
☐ Lake Co. Health District
☐ Lake Co. Building Dept.

CURVE	RADIUS	LENGTH	CHORD	BEARING	DELTA ANGLE
CI	530.00'	102.45'	102.30'	N 03°35'26" E	11°04'33"

FORM W:\BLOCKS\FORMS\BCGA3-SHARP.DWG

13103-031B

REVISIONS	BY

Barrington CONSULTING GROUP, INC.
9114 TYLER BLVD., MENTOR, OHIO 44060
PHONE 440.205.1260 FAX 440.205.1262
www.BarringtonCGI.com

STATE OF OHIO
DAVID W. NOVAK
S-7507
REGISTERED SURVEYOR

SITE PLAN

7560 SARAH LEE DR., CONCORD TWP., OHIO 44077
S/L 31B CALI WOODS No. 2 VOL. 31 PG. 4

PROBUILT HOMES, INC.

DRAWN WSO
CHECKED DWN
DATE DEC. 11, 2013
SCALE 1" = 30'
JOB NO. 13103-031B
SHEET 1/3 OF SHEETS

W:\2013\13103\SL 31B\13103-31B 20131216.dwg, 12/23/2013 10:00:52 AM, Copyright Barrington Consulting Group