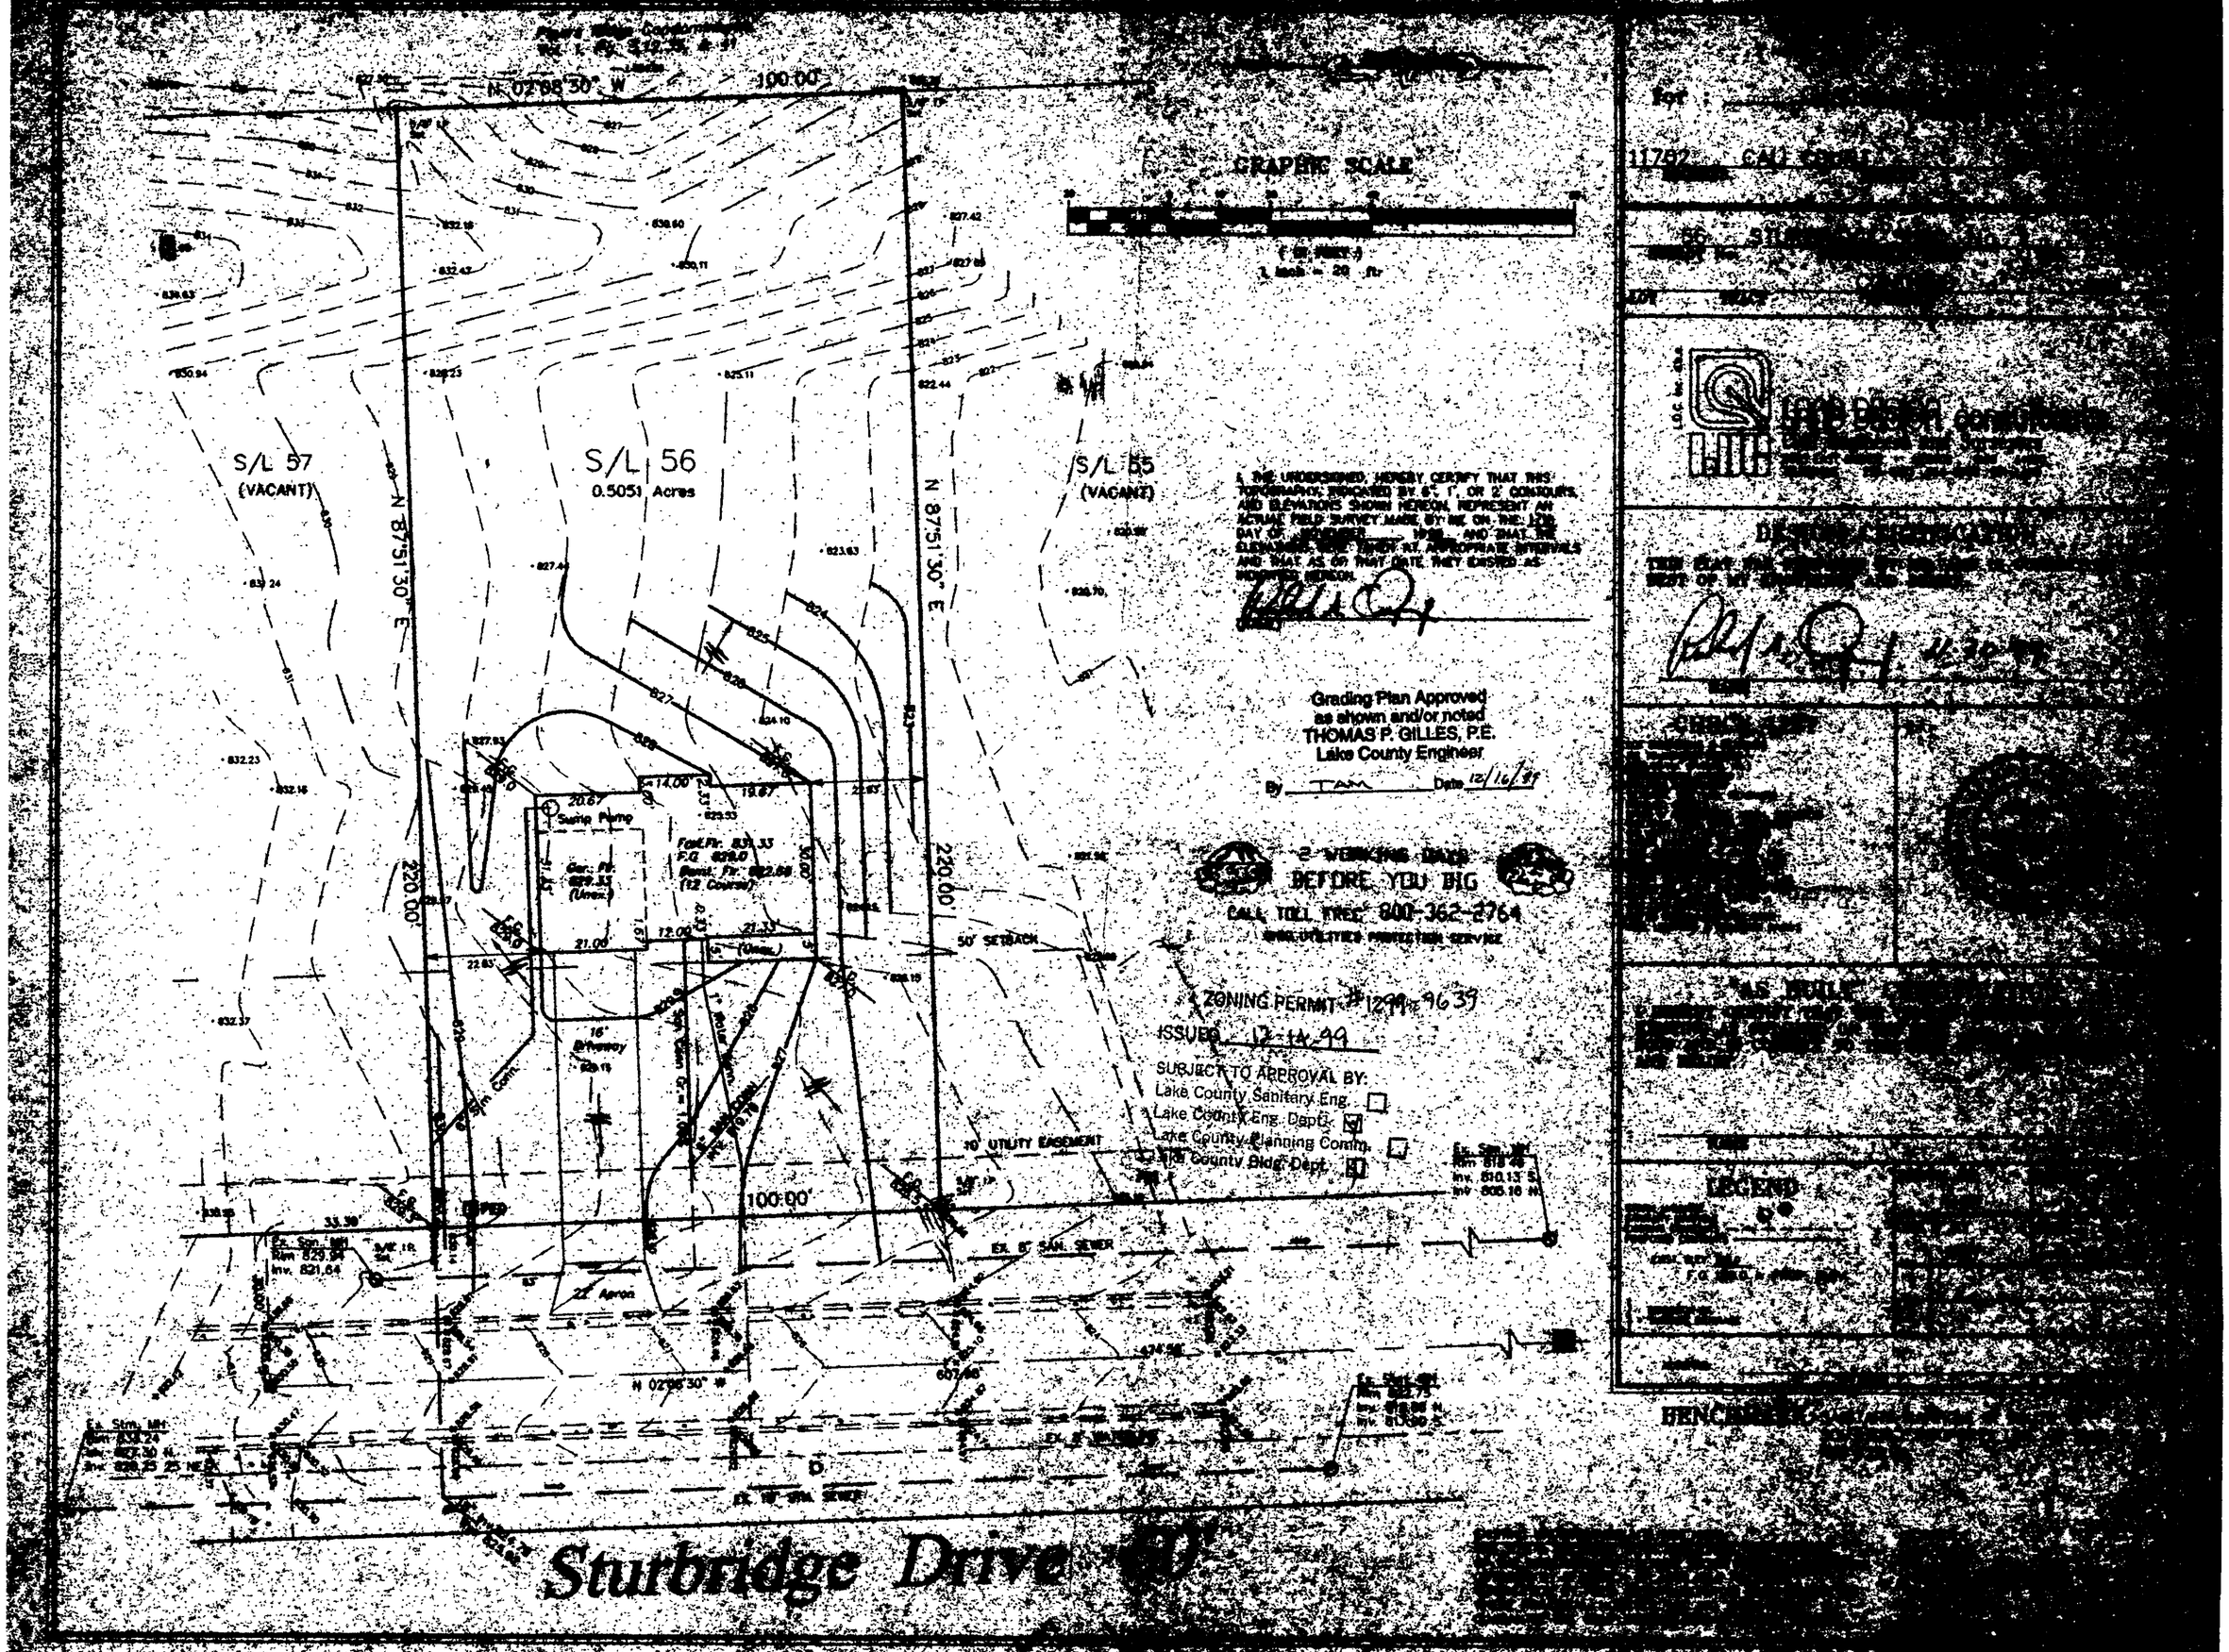

N 02°08'30" W
100.00'
GRAPHIC SCALE
1 inch = 20 ft
S/L 57
(VACANT)
S/L 56
0.5051 Acres
S/L 55
(VACANT)
N 87°51'30" E
220.00'
Sump Pump
50' SETBACK
16' Driveway
10' UTILITY EASEMENT
100.00'
EX. 8" SAN. SEWER
22' Apron
N 02°08'30" W
Grading Plan Approved
as shown and/or noted
THOMAS P. GILLES, P.E.
Lake County Engineer
By TAM Date 12/16/99
2 WORKING DAYS
BEFORE YOU DIG
CALL TOLL FREE 800-362-2764
ZONING PERMIT #1299-9639
ISSUED 12-14-99
SUBJECT TO APPROVAL BY:
Lake County Sanitary Eng.
Lake County Eng. Dept.
Lake County Planning Comm.
Lake County Bldg. Dept.
LEGEND
Sturbridge Drive