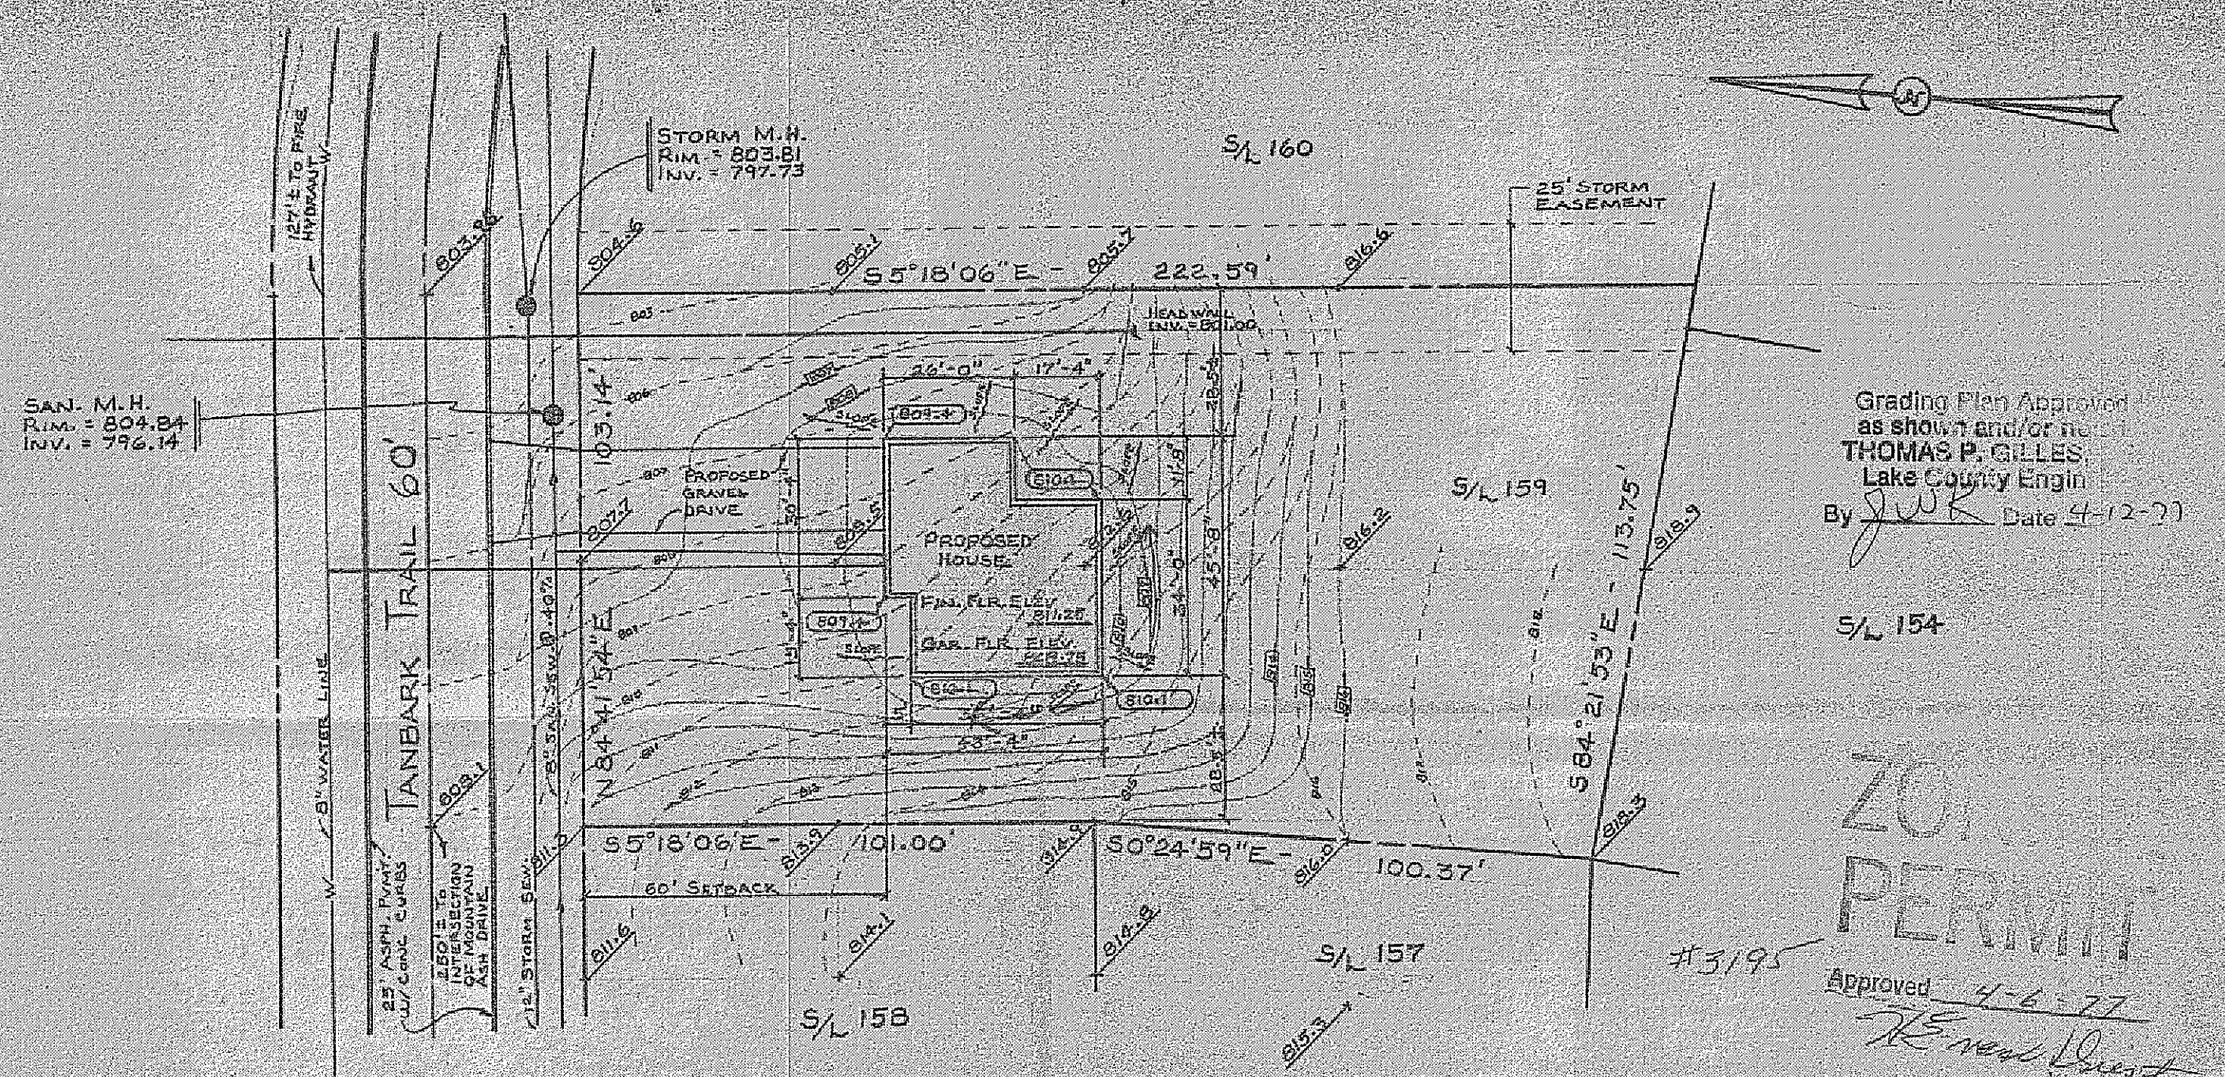

Grading Plan Approved as shown and/or note
THOMAS P. GILLES,
Lake County Engin
By _____ Date 4-12-77

ZONING PERMIT
#3195
Approved 4-6-77

SITE PLAN FOR:

SHANDLE CONST.
8353 MENTOR AVENUE
MENTOR, OHIO
BEING SUBLOT NUMBER 159
IN THE MORLEY HILLS ESTATES
SUBDIVISION NO. 3 IN CONCORD
TOWNSHIP, LAKE COUNTY, OHIO

PREPARED BY:

WM. R. GRAY ASSOC. INC.
7457 MENTOR AVENUE
MENTOR, OHIO

SCALE: 1" = 30'
DATE: MARCH 31, 1977

CERTIFICATION:

I HEREBY CERTIFY THAT
THIS PLAT IS CORRECT TO
THE BEST OF MY KNOWLEDGE:

BY: Wm. R. Gray
WM. R. GRAY REG. SURV. #2752