SITE PLAN FOR:

SHANDLE CONST.
8353 MENTOR AVENUE
MENTOR, OHIO
BEING SUBLOT NUMBER
160 IN THE MORLEY HILLS
ESTATES SUBDIVISION NUMBER
3 IN CONCORD, OHIO

PREPARED BY

WM. R GRAY ASSOC INC.
7547 MENTOR AVE
MENTOR, OHIO
DATE: JUNE 8, 1977
SCALE: 1" = 30'

CERTIFICATION:

I HEREBY CERTIFY THAT
THIS PLAT IS CORRECT TO
THE BEST OF MY KNOWLEDGE
BY: Terrence Gerson

STATE OF OHIO
TERRENCE GLENN GERSON
038598
REGISTERED
PROFESSIONAL ENGINEER

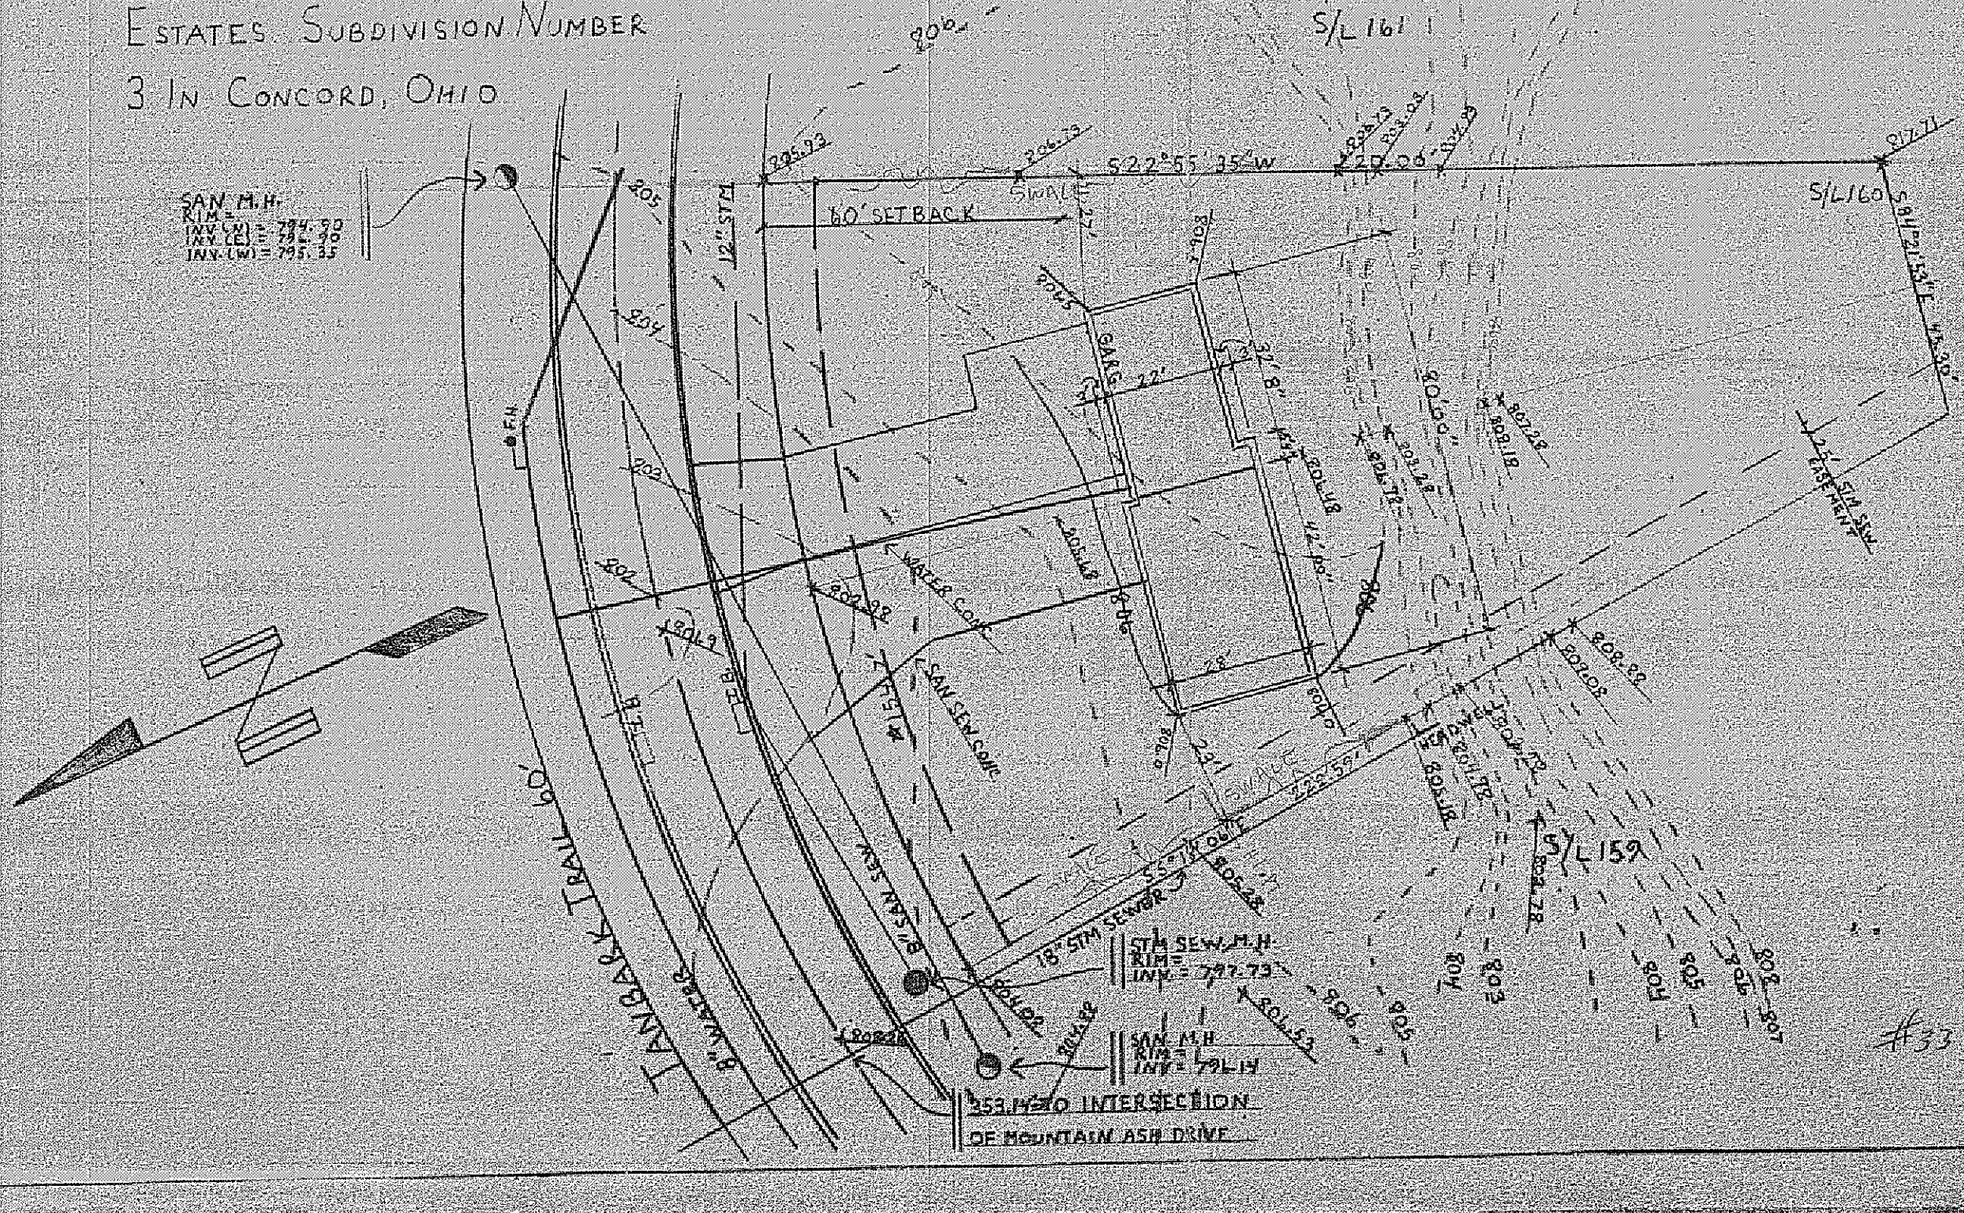

Grading Plan Approved
as shown and/or noted
THOMAS P. O'NEILL, P.E.
Lake County Engineer
By: D.T.L. Date 6/27/77

★CURVE DATA
Δ = 28°13'41"
RAD = 314.02'
ARC = 154.71'
CH = 153.15'
TAN = 78.96'

ZONING PERMIT
#3302
Approved 6-27-77