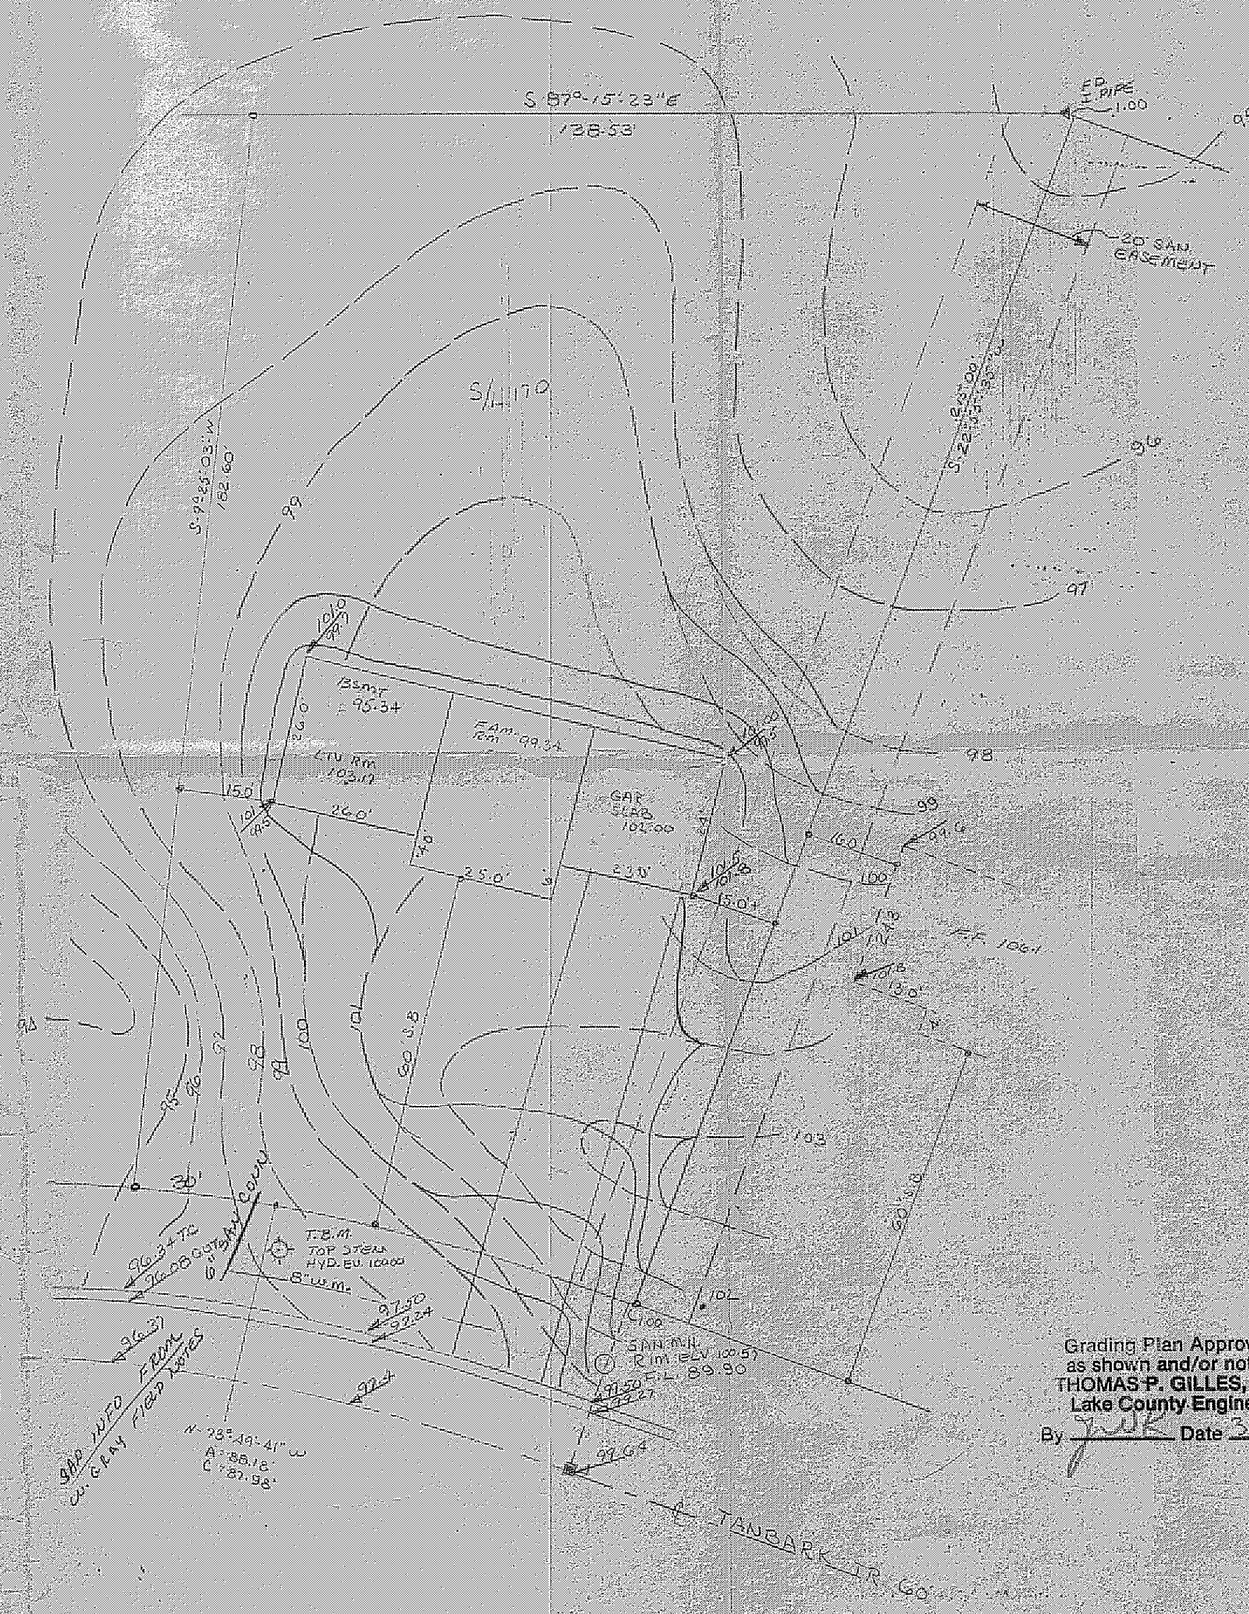

Grading Plan Approved
as shown and/or noted
THOMAS P. GILLES, P.E.
Lake County Engineer
By _____ Date 3-24-77

N

SURVEY AND SITE PLAN FOR
ROY E. SLAYTON BEING SUBLOT
170 IN MORLEY HILLS SUBDIVISION
NO. 3, AS SURVEYED BY
JOHN C. SKONIECZNY
S-6356
25 MAR 77

PROPOSED GRADE
EXISTG GRADE
PROPOSED CONTOURS
EXISTG CONTOURS
SCALE 1" = 20'
352 7742

STATE OF OHIO
JOHN CLOUD SKONIECZNY
S-6356
REGISTERED SURVEYOR

ZONING PERMIT

3188

Approved 3-23-77