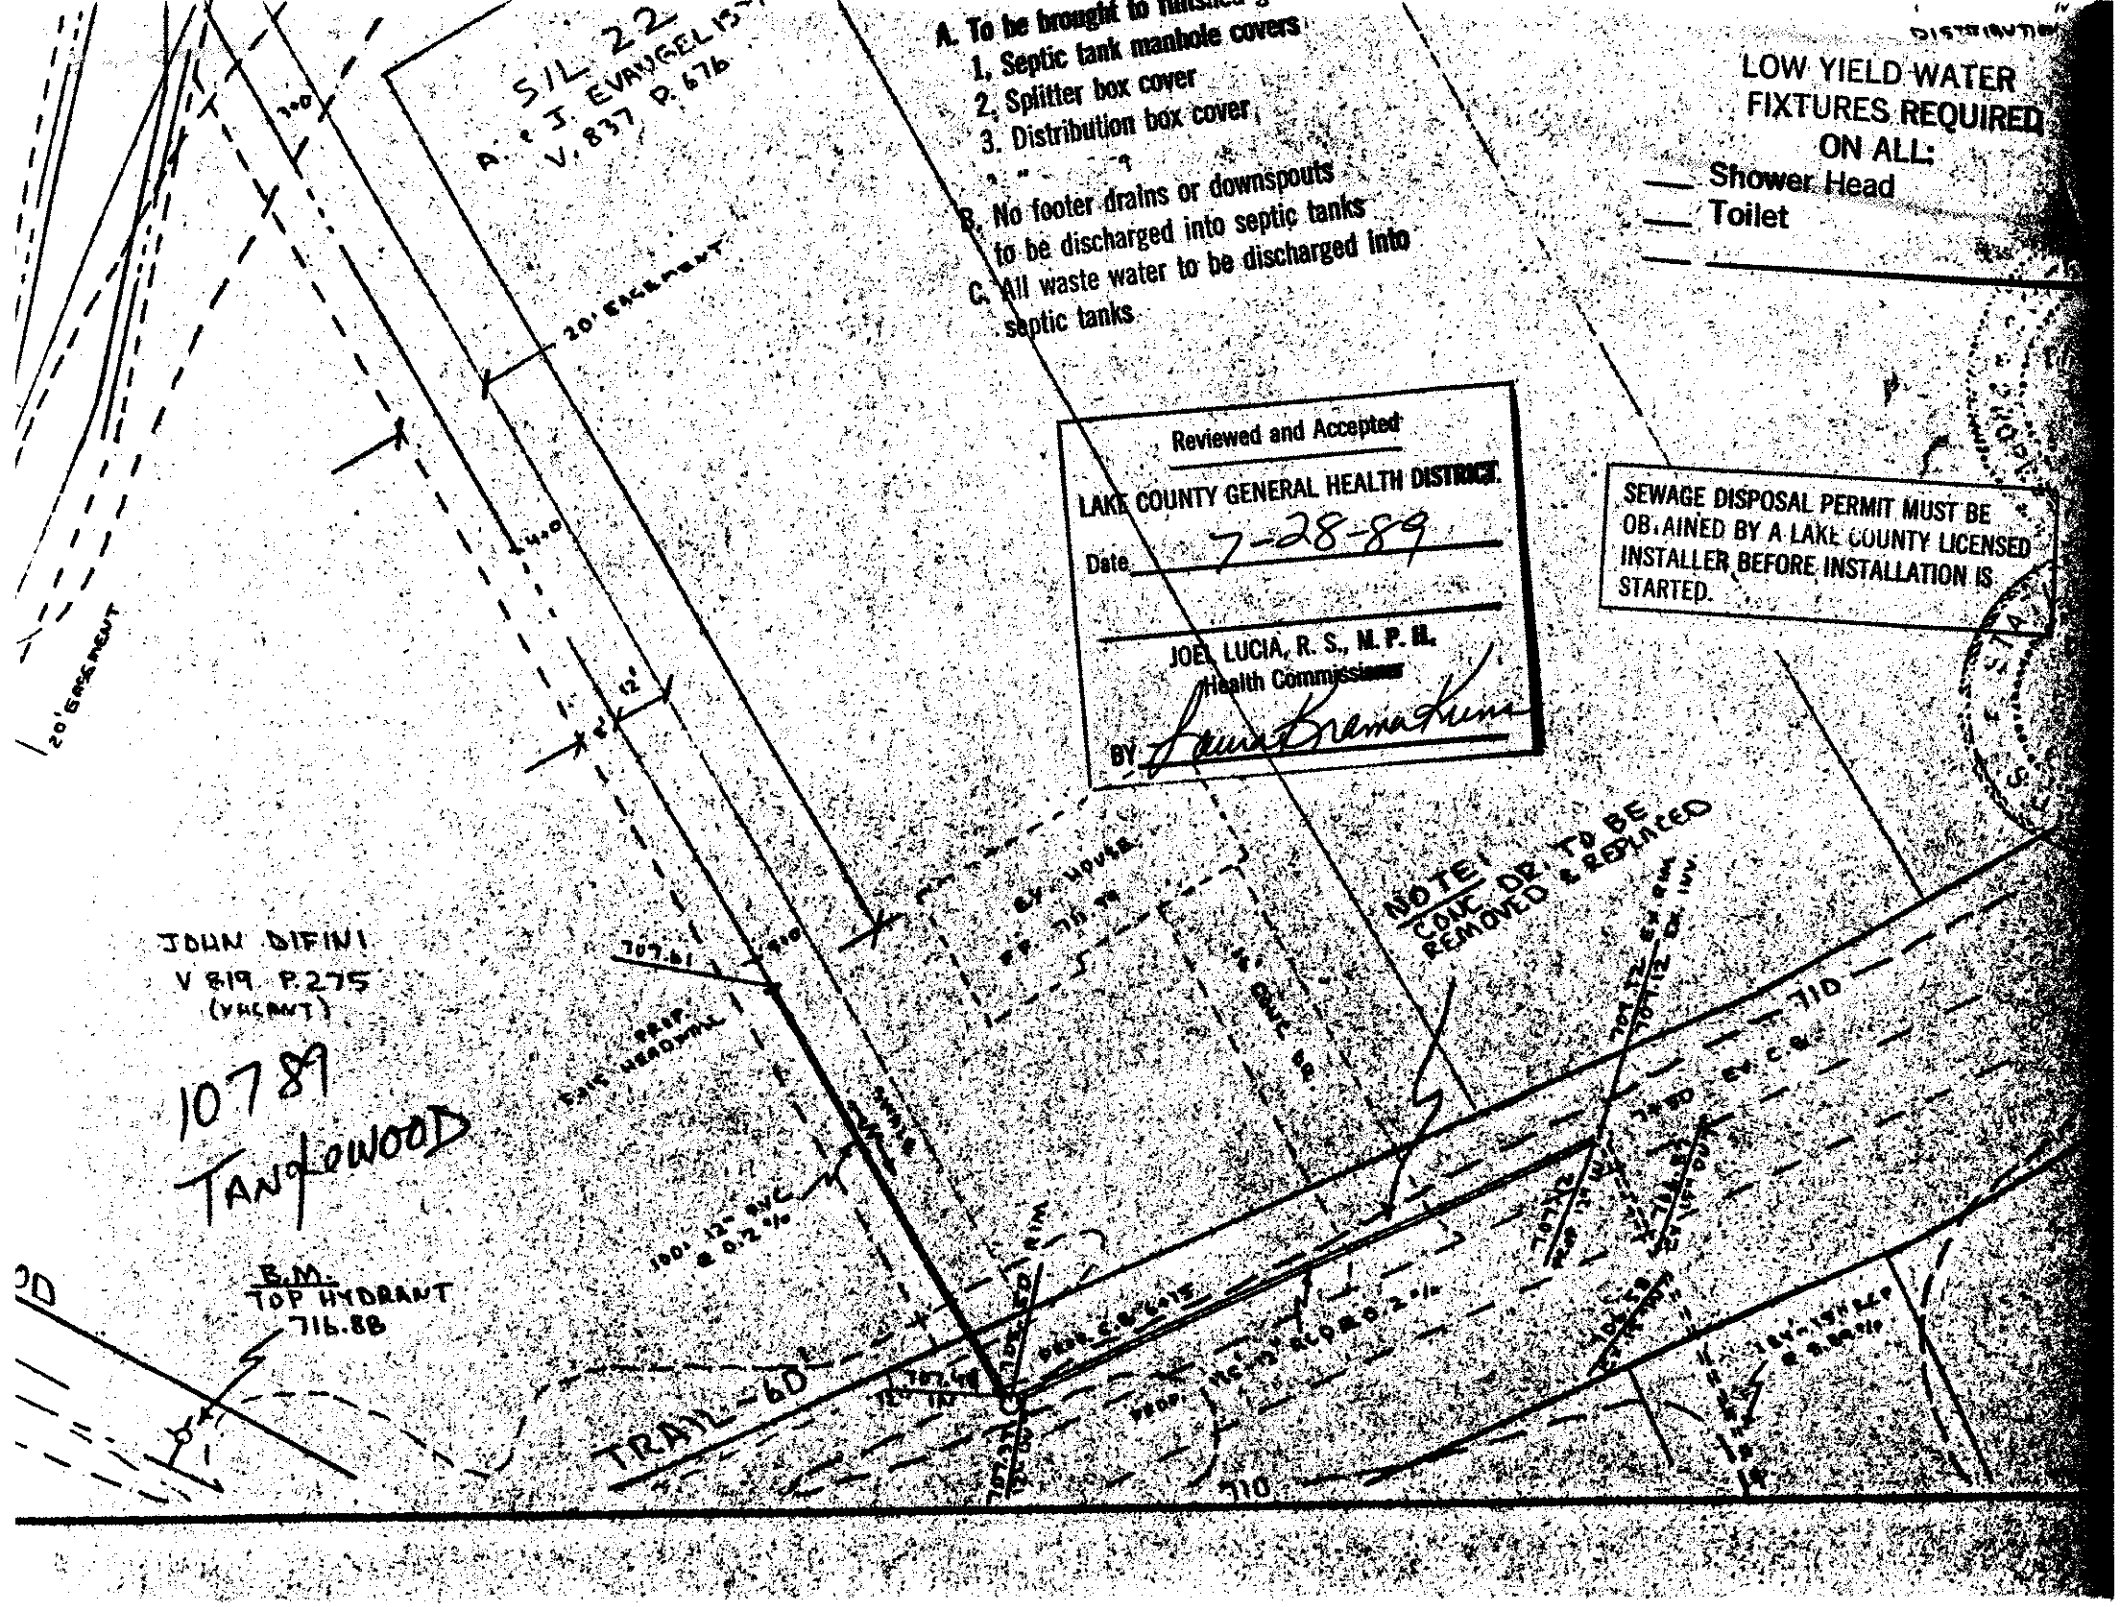

A. To be brought to finished g
1. Septic tank manhole covers
2. Splitter box cover
3. Distribution box cover

B. No footer drains or downspouts to be discharged into septic tanks

C. All waste water to be discharged into septic tanks

Reviewed and Accepted

LAKE COUNTY GENERAL HEALTH DISTRICT

Date 7-28-89

JOEL LUCIA, R. S., M. P. H.
Health Commissioner

BY Laura Brama Kuns

LOW YIELD WATER FIXTURES REQUIRED ON ALL:

___ Shower Head
___ Toilet
___

SEWAGE DISPOSAL PERMIT MUST BE OBTAINED BY A LAKE COUNTY LICENSED INSTALLER BEFORE INSTALLATION IS STARTED.