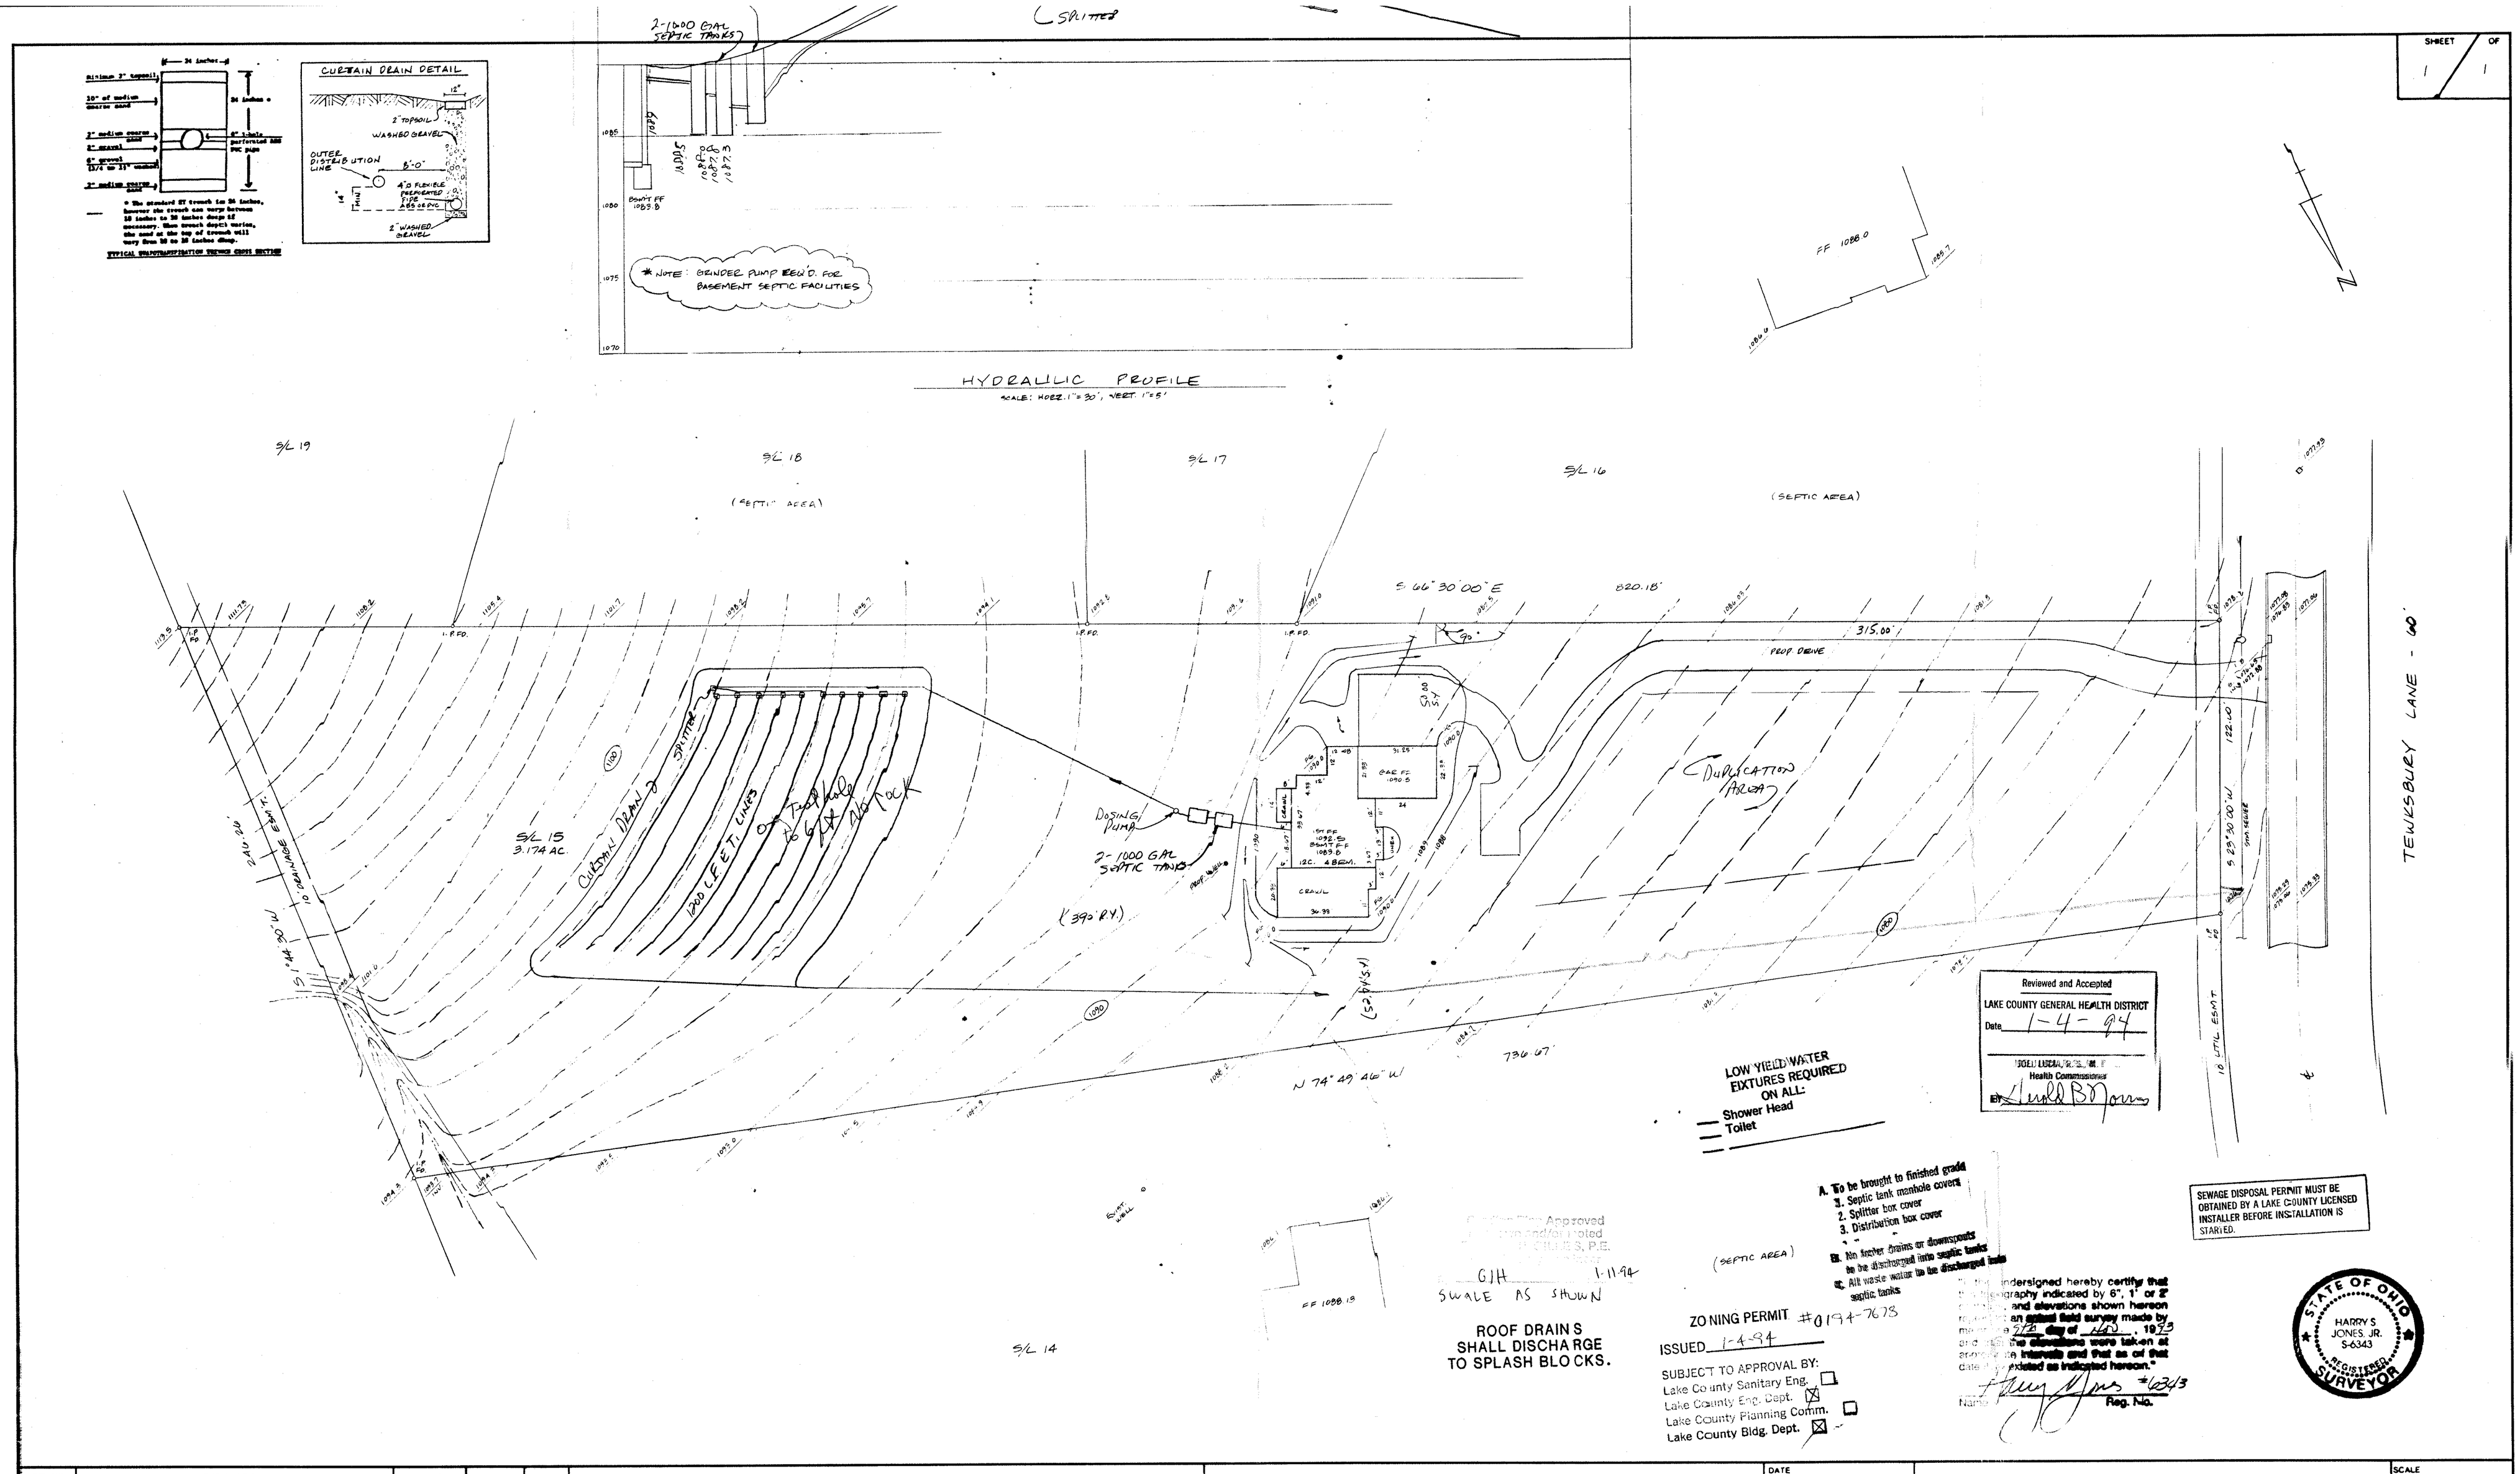

REV NO.	DESCRIPTION	DATE	BY	CHK'D
1	REVERSED SEPTIC & DUPLICATION	11-20-93	HJ	HJ

SITE PLAN FOR KAY HOMES

BABCOCK, JONES AND ASSOCIATES, INC
CIVIL ENGINEERS - SURVEYORS - LAND PLANNERS
PAINESVILLE OHIO 44077

DATE NOVEMBER 10, 1993
DESIGN BY HJ
DRAWN BY
APPROVED BY HJ

S/L 15 - HARWOOD III SUBDIVISION
VOL. 10 - PG. 17
CONCORD TOWNSHIP - LAKE COUNTY - OHIO

SCALE 1"=30'
JOB NO. 88-091-15
SHEET 1 OF 1