SITE PLAN

Concord Township, Lake COUNTY, OHIO

for: Lenton-Hill Building, Inc.
CLIENT OWNER

ADDRESS STREET CITY ZIP

Hawbold III SUBDIVISION 10-17 NAME
17 SUBLOT NO. Tewksbury Lane STREET
LOT TRACT
VOLUME PAGE
PERM. PARCEL NO. STREET

Reviewed and Accepted
LAKE COUNTY GENERAL HEALTH DISTRICT
Date 12-16-88
JOEL LUCIA, R. S., M. P. H.
Health Commissioner
By Jerold B. Lucia

LOW YIELD WATER FIXTURES REQUIRED ON ALL:
— Shower Head
— Toilet
— _____

Grading Plan Approved as shown and/or noted
THOMAS P. GILLES, P.E.
Lake County Engineer
By _____ Date 1/16/89

A. To be brought to finished grade
1. Septic tank manhole covers
2. Splitter box cover
3. Distribution box cover
B. No footer drains or downspouts to be discharged into septic tanks
C. All water to be discharged into septic tanks

SEWAGE DISPOSAL PERMIT MUST BE OBTAINED BY A LAKE COUNTY LICENSED INSTALLER BEFORE INSTALLATION IS STARTED.

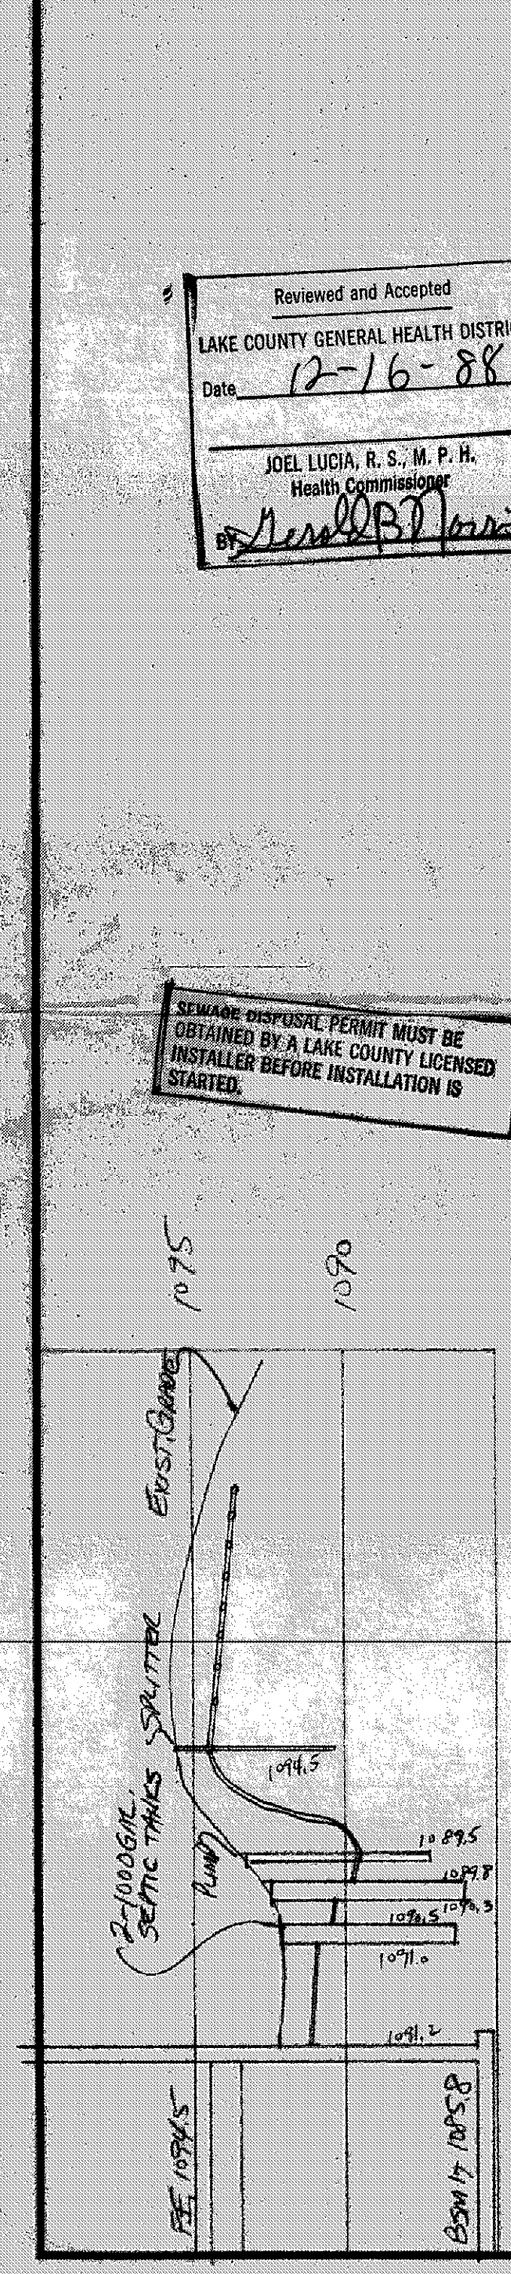
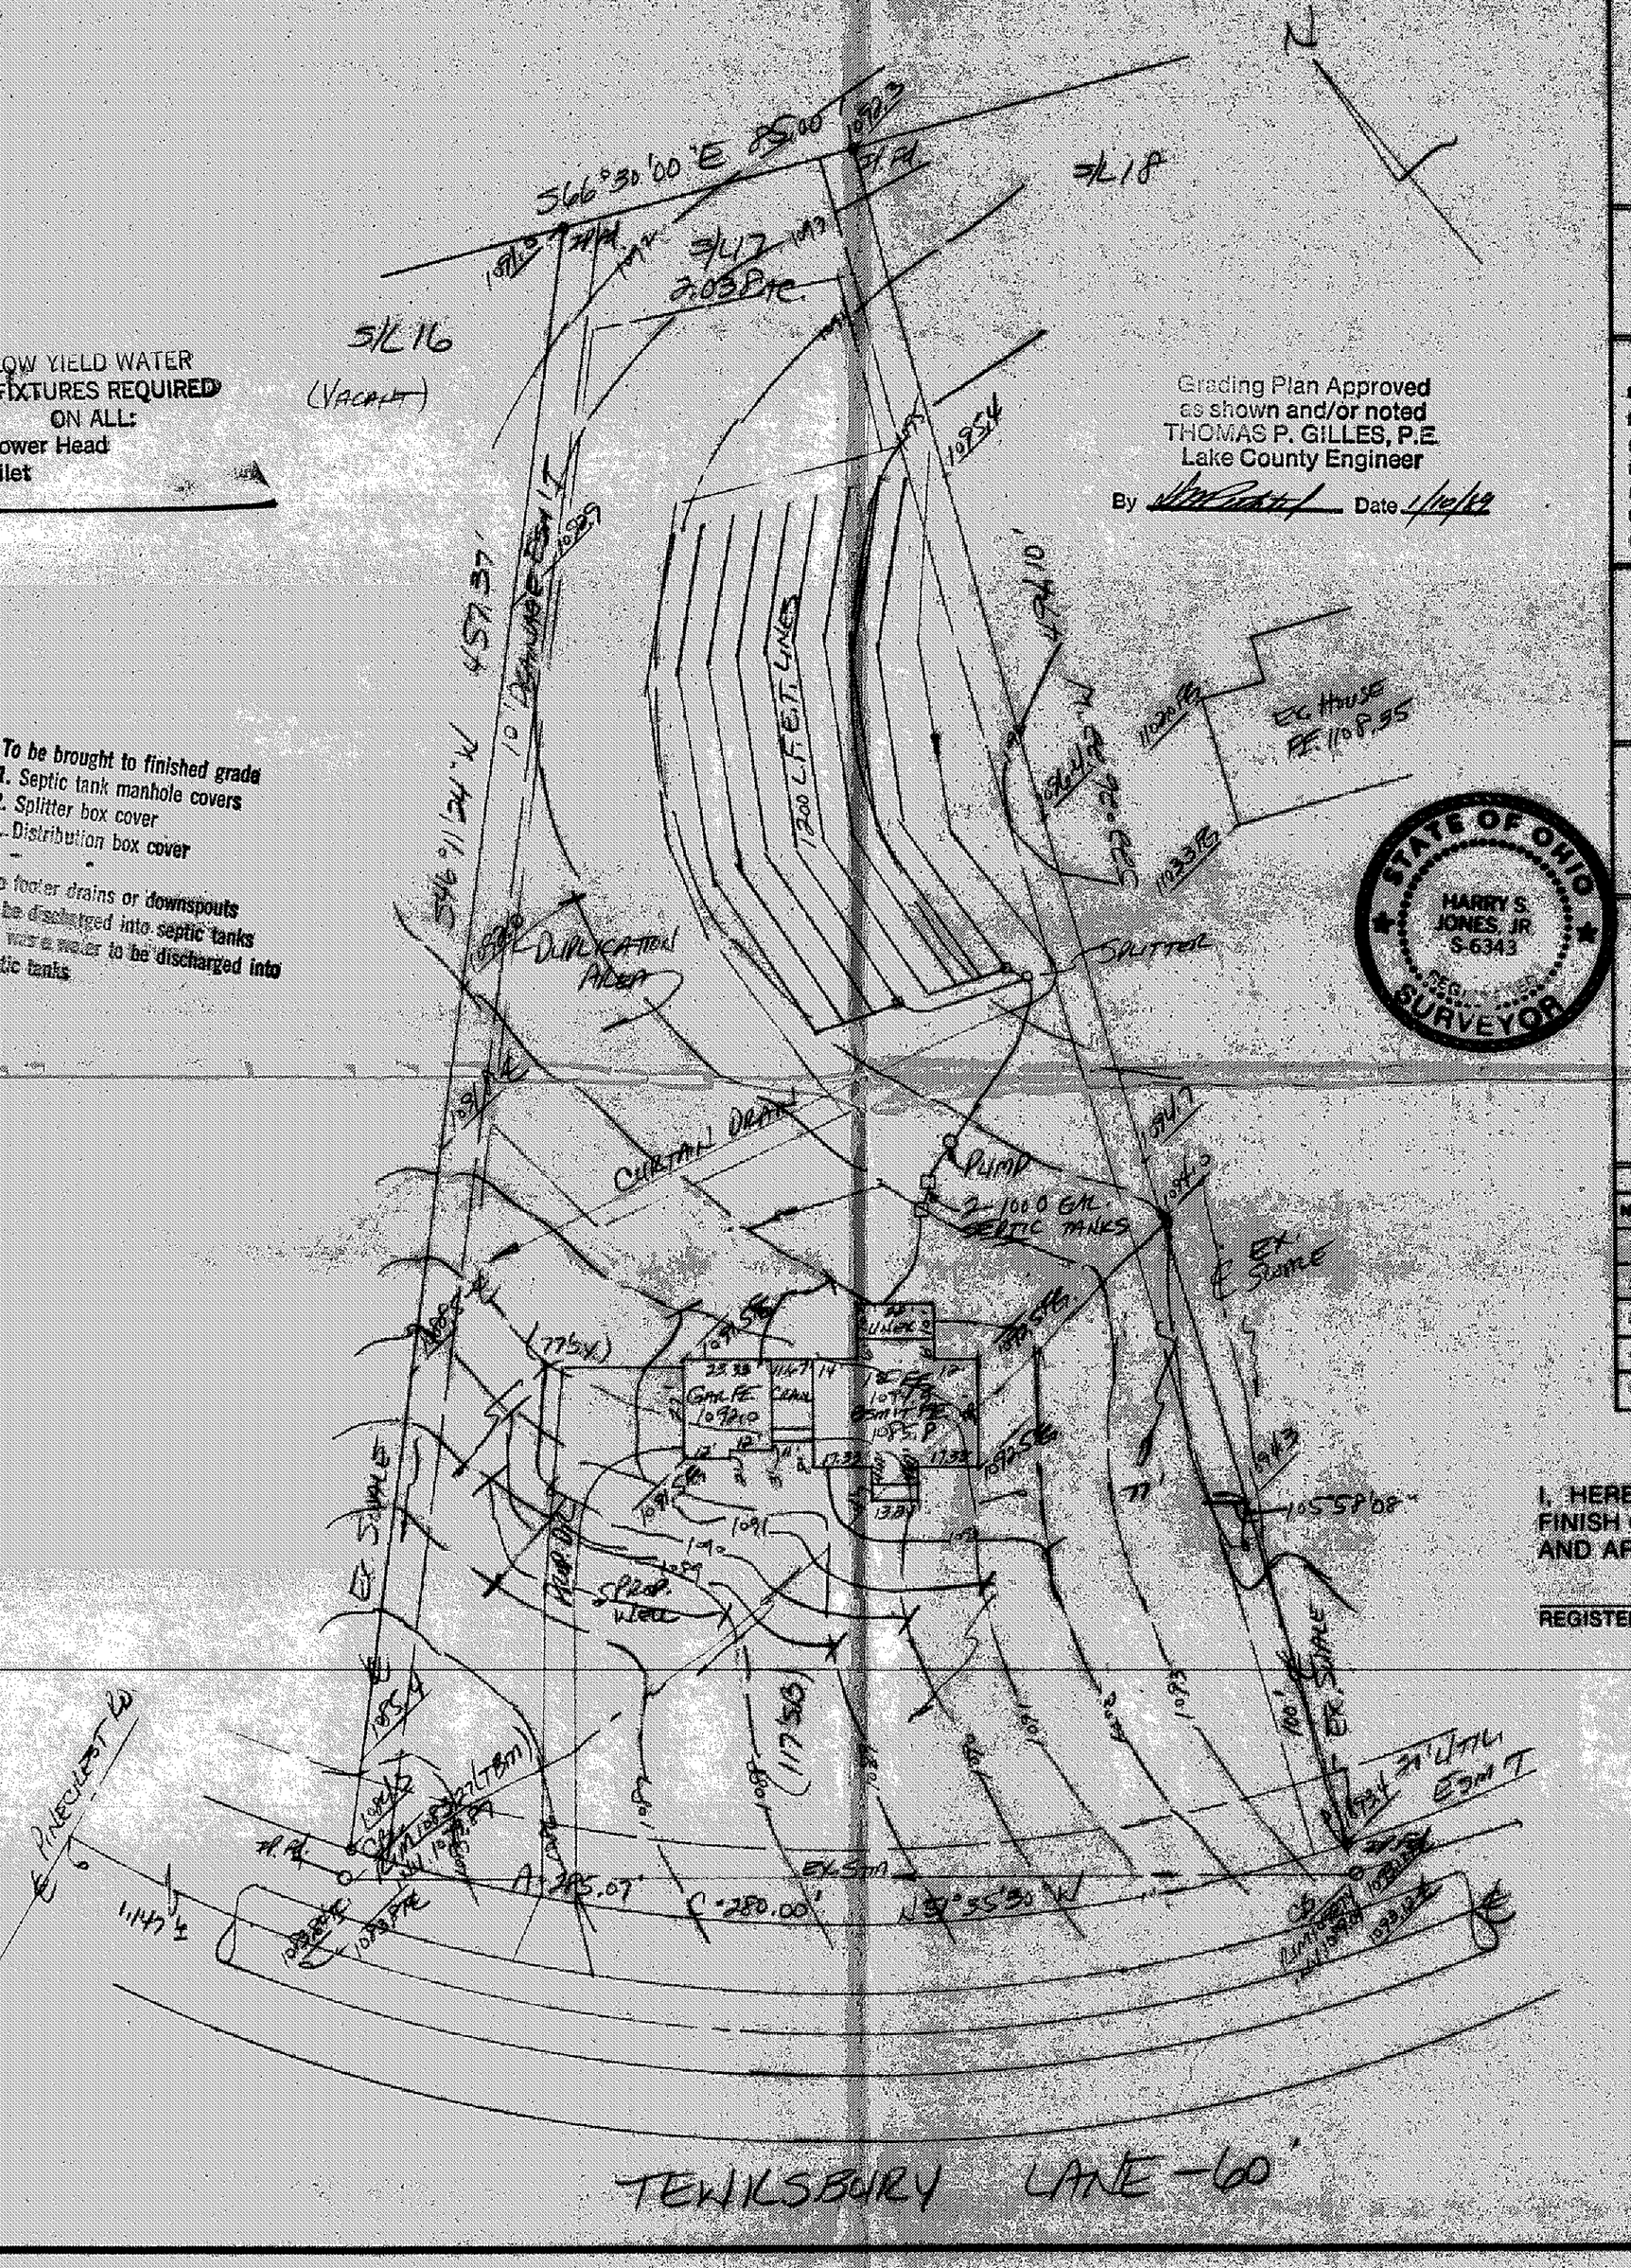
HYDRAULIC PROFILE
SCALE: HOR. 1"=40'
VERT. 1"=5'