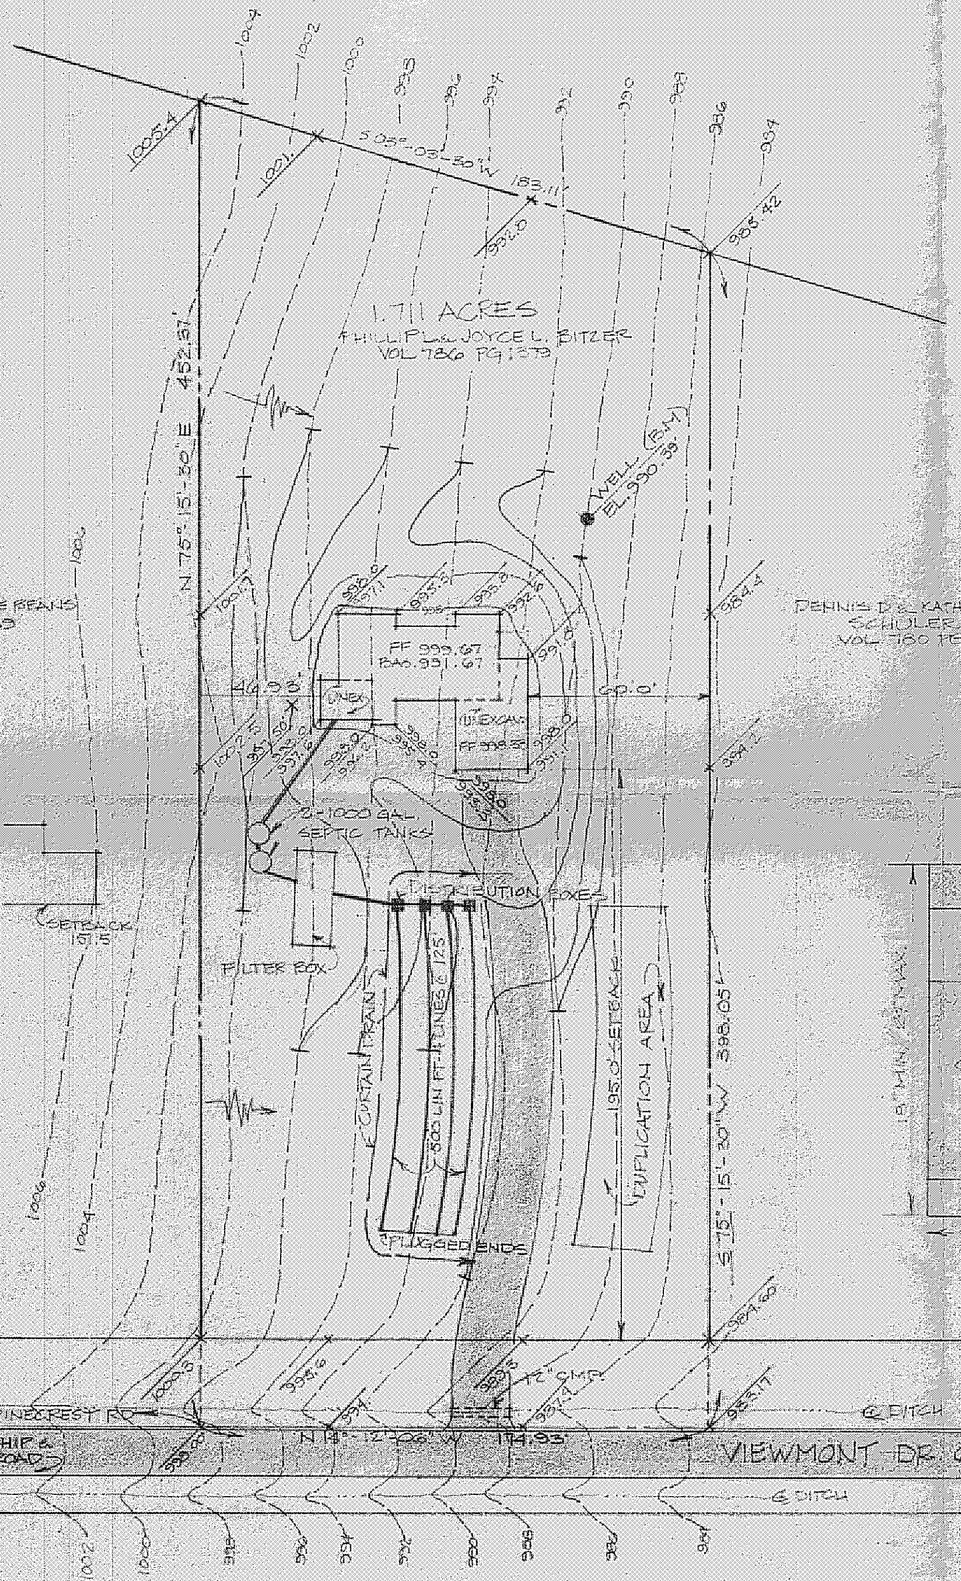

BENCH MARK:
LOCATED AT TOP OF WELL CASING.
ELEV. 990.39'

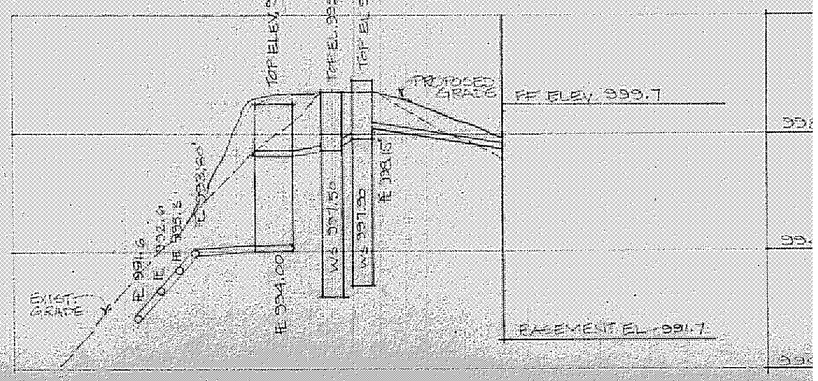

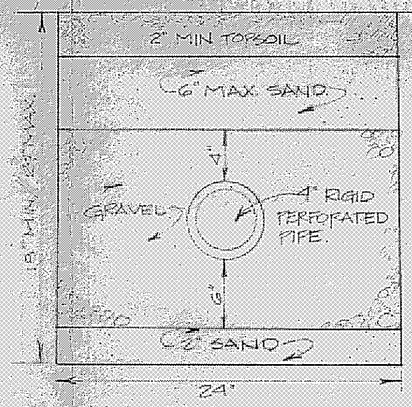

TRENCH DETAIL
NO SCALE

ZP # 4392
CONCORD TWP.
8-17-81

Grading Plan Approved
as shown and/or noted
THOMAS P. GILLES, P.E.
Lake County Engineer
By _____ Date 2-17-81

DESIGN CERTIFICATION	AS BUILT CERTIFICATION
THIS PLAT WAS PREPARED BY ME AND IS CORRECT TO THE BEST OF MY KNOWLEDGE AND BELIEF	I HEREBY CERTIFY THAT THE CIRCLED ARE EXISTING FINISH GRADES CHECKED FIELD ON AND SURVEY IS CORRECT TO THE BEST KNOWLEDGE AND BELIEF
REG. SURVEYOR NO. 4285	REG. SURVEYOR NO.

SITE PLAN FOR J.W. BETTELEY
RESIDENCE FOR ROBERT & SANDY PATTERSON
CONCORD TOWNSHIP, LAKE COUNTY, OHIO

DATE 8-12-81
SCALE 1" = 40'
DRAWN BY RAV
CH'K'D BY JE
F.B.# 412 PG. 37

COLPETZER · WOODS
CONSULTANTS, INC.
MENTOR, OHIO 44060

SHEET 1
CONTRACT 81-