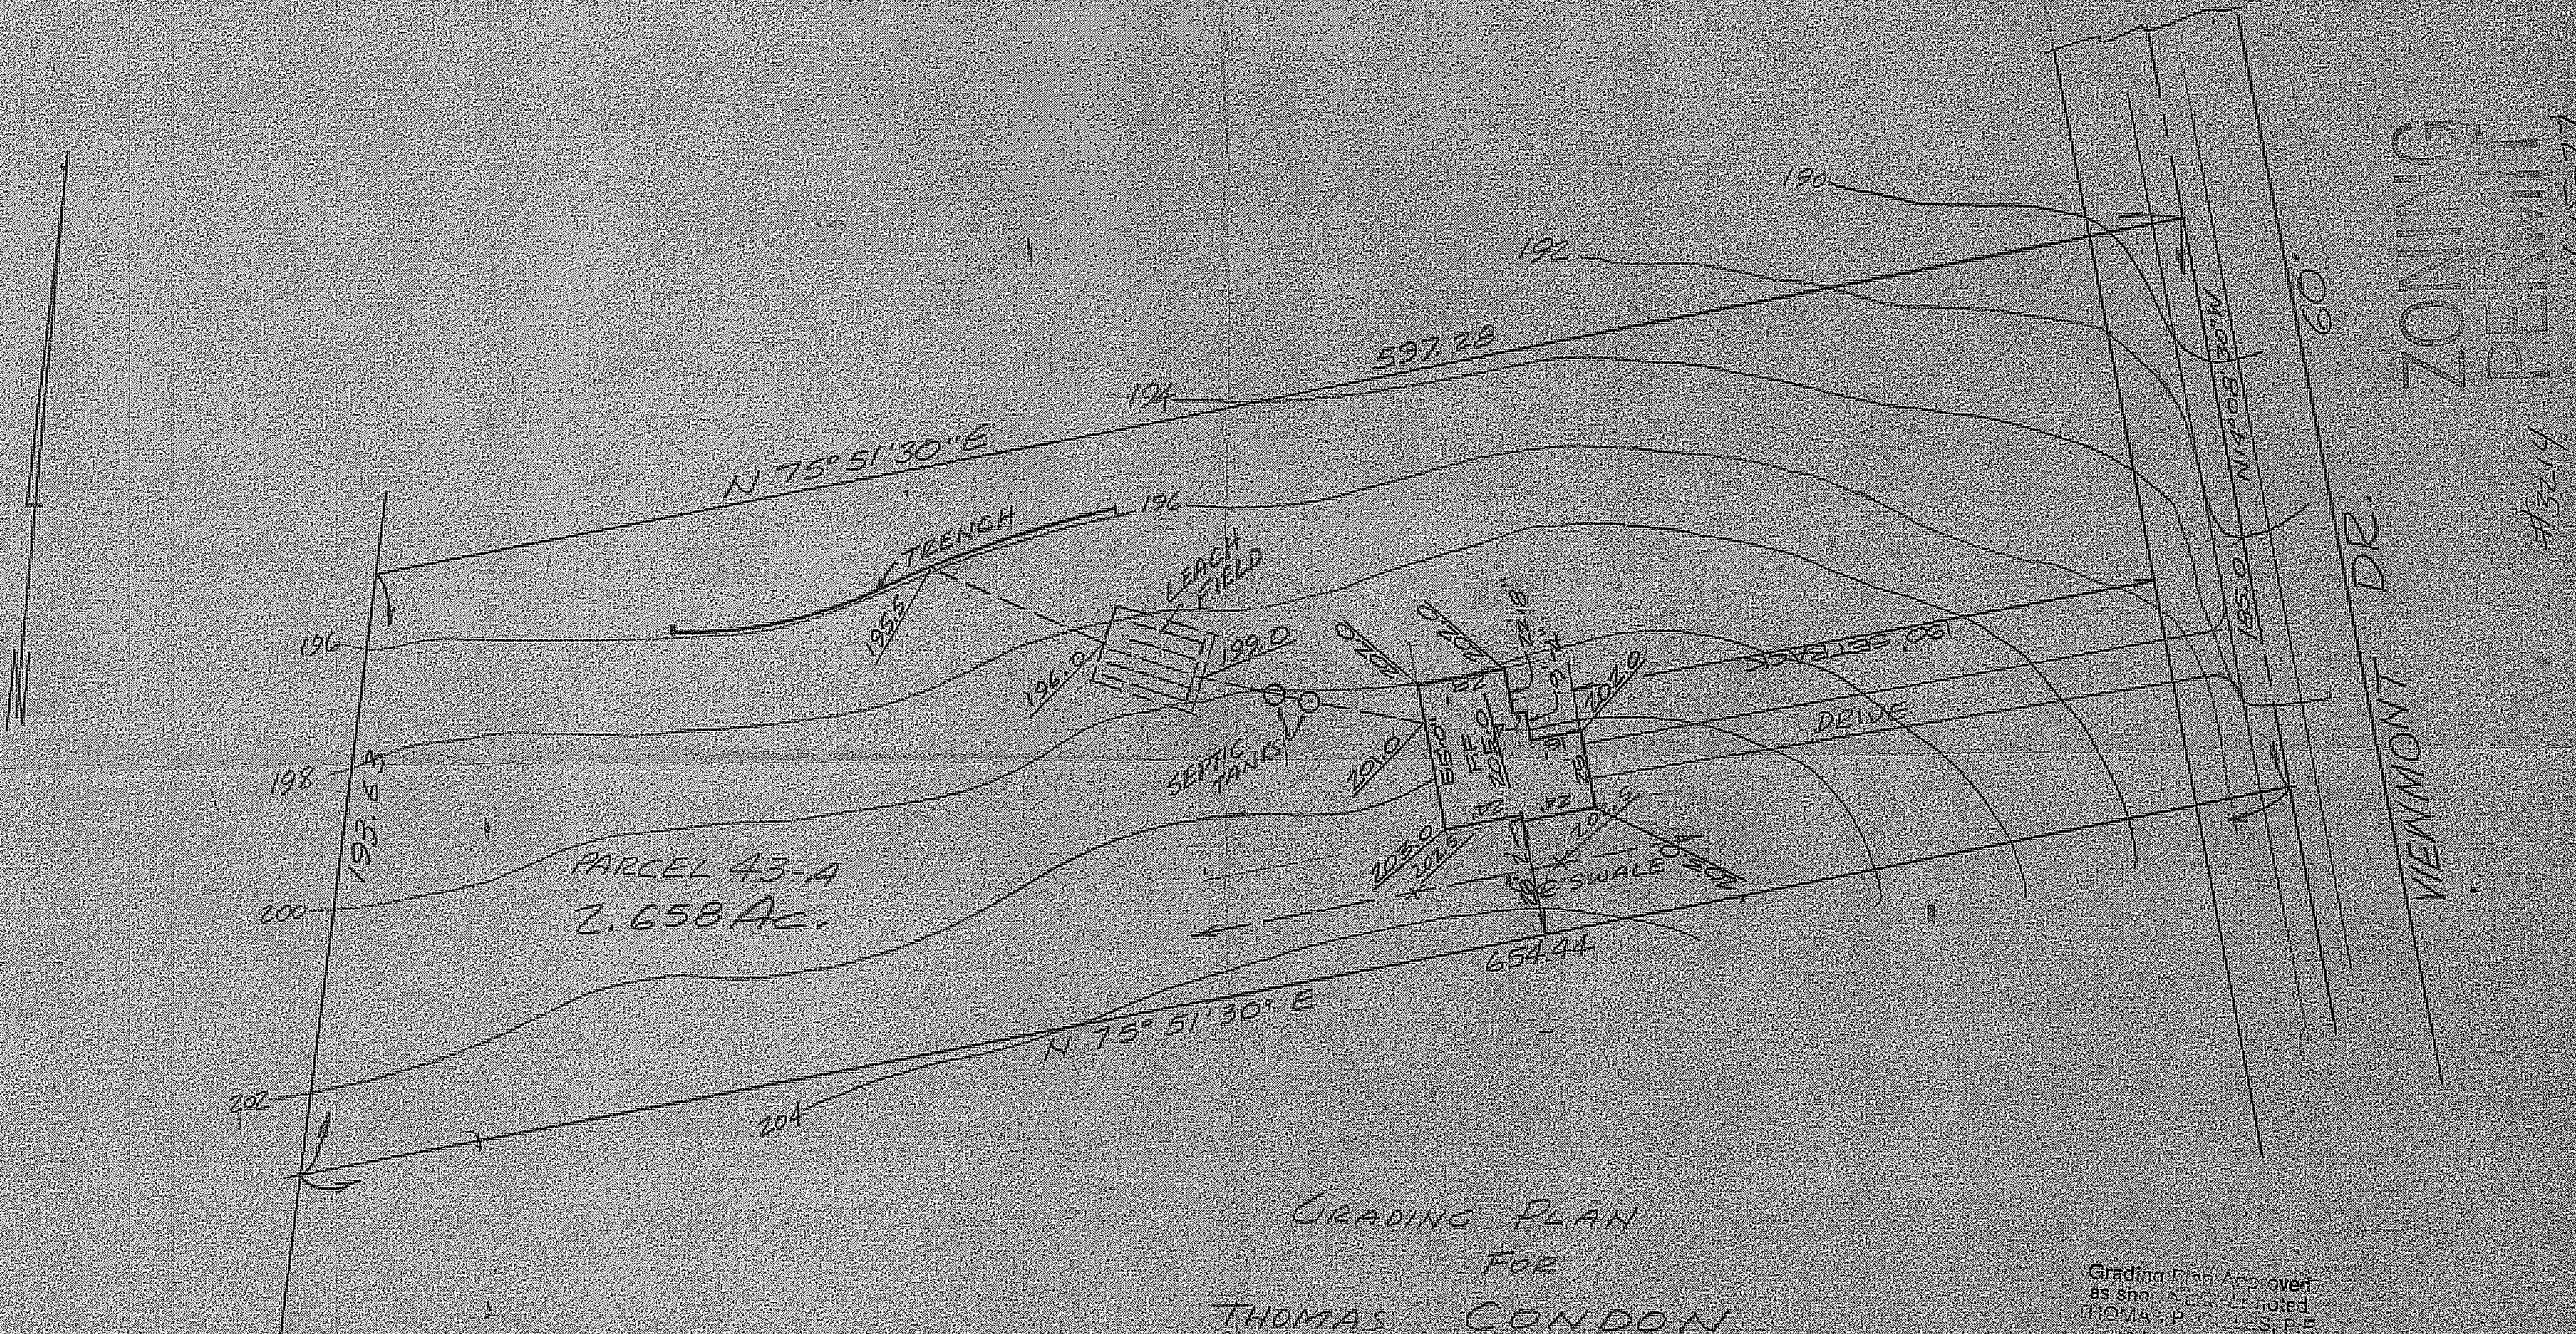


GRADING PLAN
FOR
THOMAS CONDON
CONCORD TWP.- LAKE COUNTY, OHIO
SCALE: 1"=40' JUNE 1973

Grading Plan Approved
as shown except as noted
THOMAS P. ... P.E.
4-18-77

"AS BUILT" CERTIFICATION
I HEREBY CERTIFY THAT THE CIRCLED GRADES ARE EXIST. FINISH GRADES CHECKED IN FIELD ON __________ 197__
SURVEY IS CORRECT TO THE BEST OF MY KNOWLEDGE

__________________________
REG. SURVEYOR No.

FULLERTON-KERR & AS...
REG. ENGINEERS & SUR...
PAINESVILLE, OHI...

8080