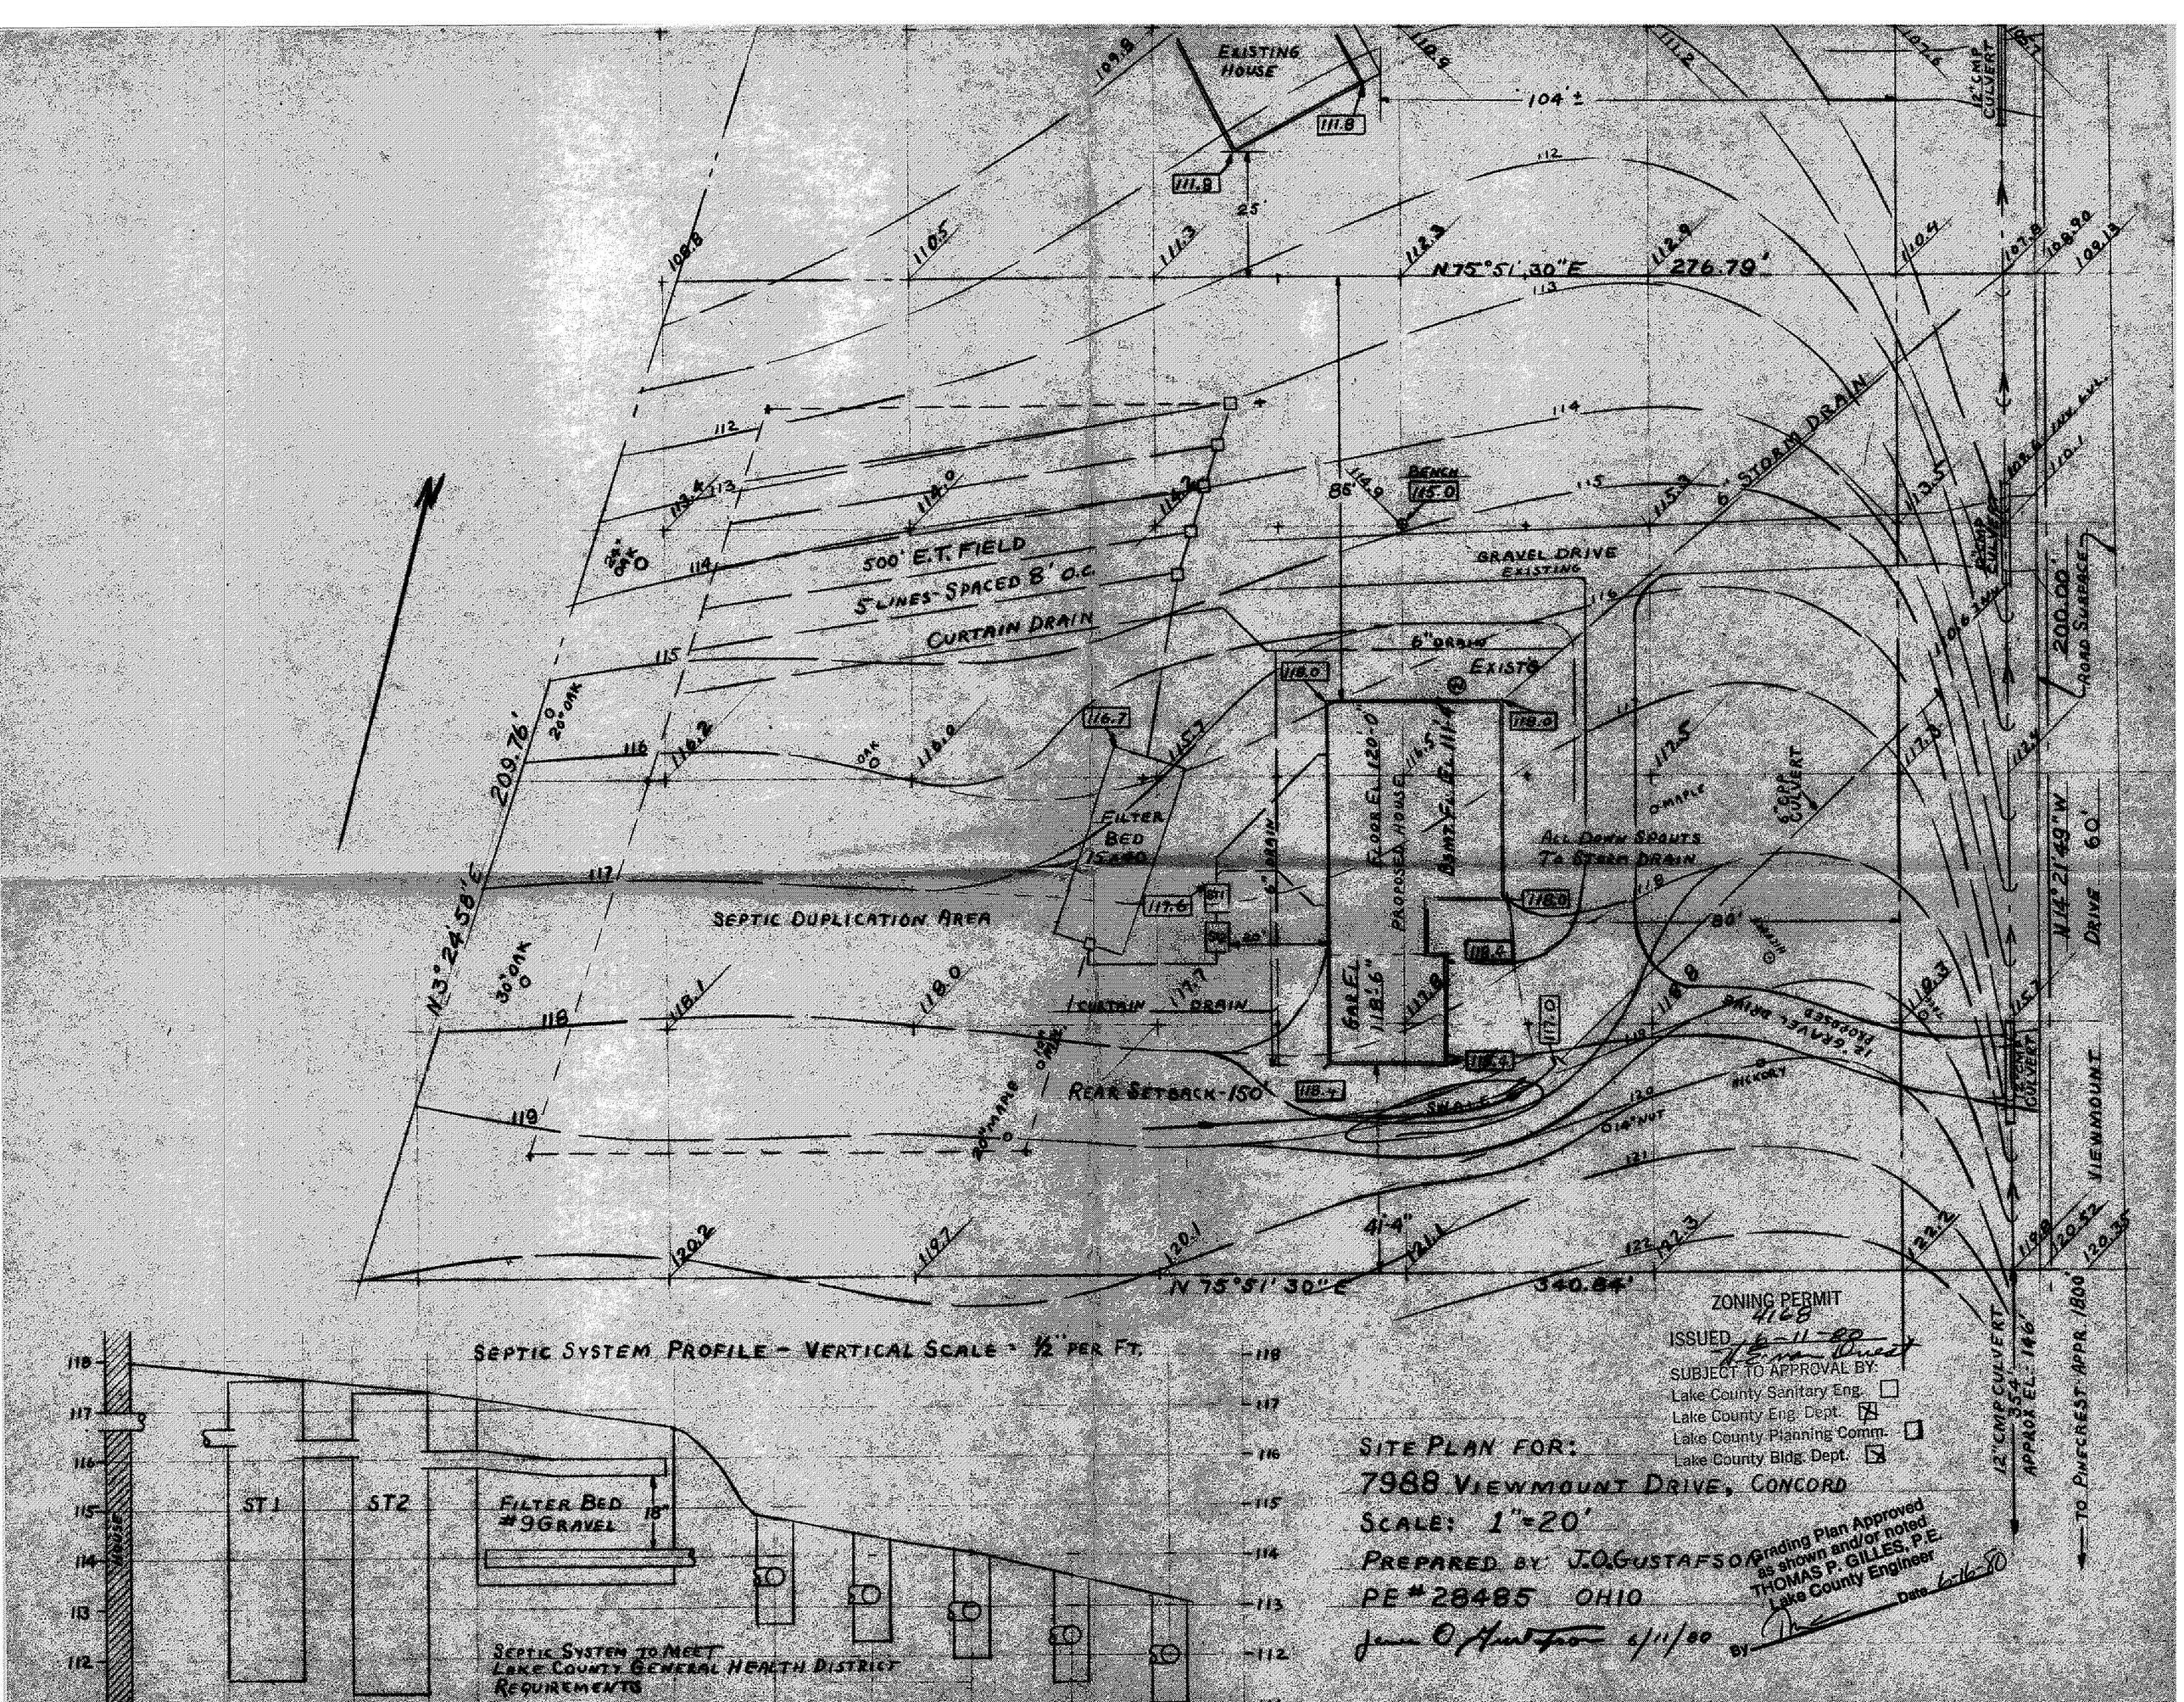
EXISTING HOUSE
104'±
N75°51'30"E 276.79'
500' E.T. FIELD
5 LINES SPACED 8' O.C.
CURTAIN DRAIN
6" STORM DRAIN
GRAVEL DRIVE EXISTING
6" DRAIN EXIST'G
FILTER BED
SEPTIC DUPLICATION AREA
FLOOR EL. 120'-0"
PROPOSED HOUSE
ALL DOWN SPOUTS TO STORM DRAIN
REAR SETBACK-150'
N 75°51' 30"E 340.84'
200.00' ROAD SURFACE
N14°21'49"W 60'
DRIVE
VIEWMOUNT
12" CMP CULVERT
APPROX. EL. 116'
TO PINECREST APPR. 1800'
ZONING PERMIT 4168
ISSUED 6-11-80
SUBJECT TO APPROVAL BY:
Lake County Sanitary Eng. ☐
Lake County Eng. Dept. ☒
Lake County Planning Comm. ☐
Lake County Bldg. Dept. ☒
SITE PLAN FOR:
7988 VIEWMOUNT DRIVE, CONCORD
SCALE: 1"=20'
PREPARED BY: J.O. GUSTAFSON
PE #28485 OHIO
6/11/80
Grading Plan Approved as shown and/or noted
THOMAS P. GILLES, P.E.
Lake County Engineer
Date 6-16-80
SEPTIC SYSTEM PROFILE - VERTICAL SCALE = ½" PER FT.
ST 1
ST 2
FILTER BED #9 GRAVEL
SEPTIC SYSTEM TO MEET LAKE COUNTY GENERAL HEALTH DISTRICT REQUIREMENTS