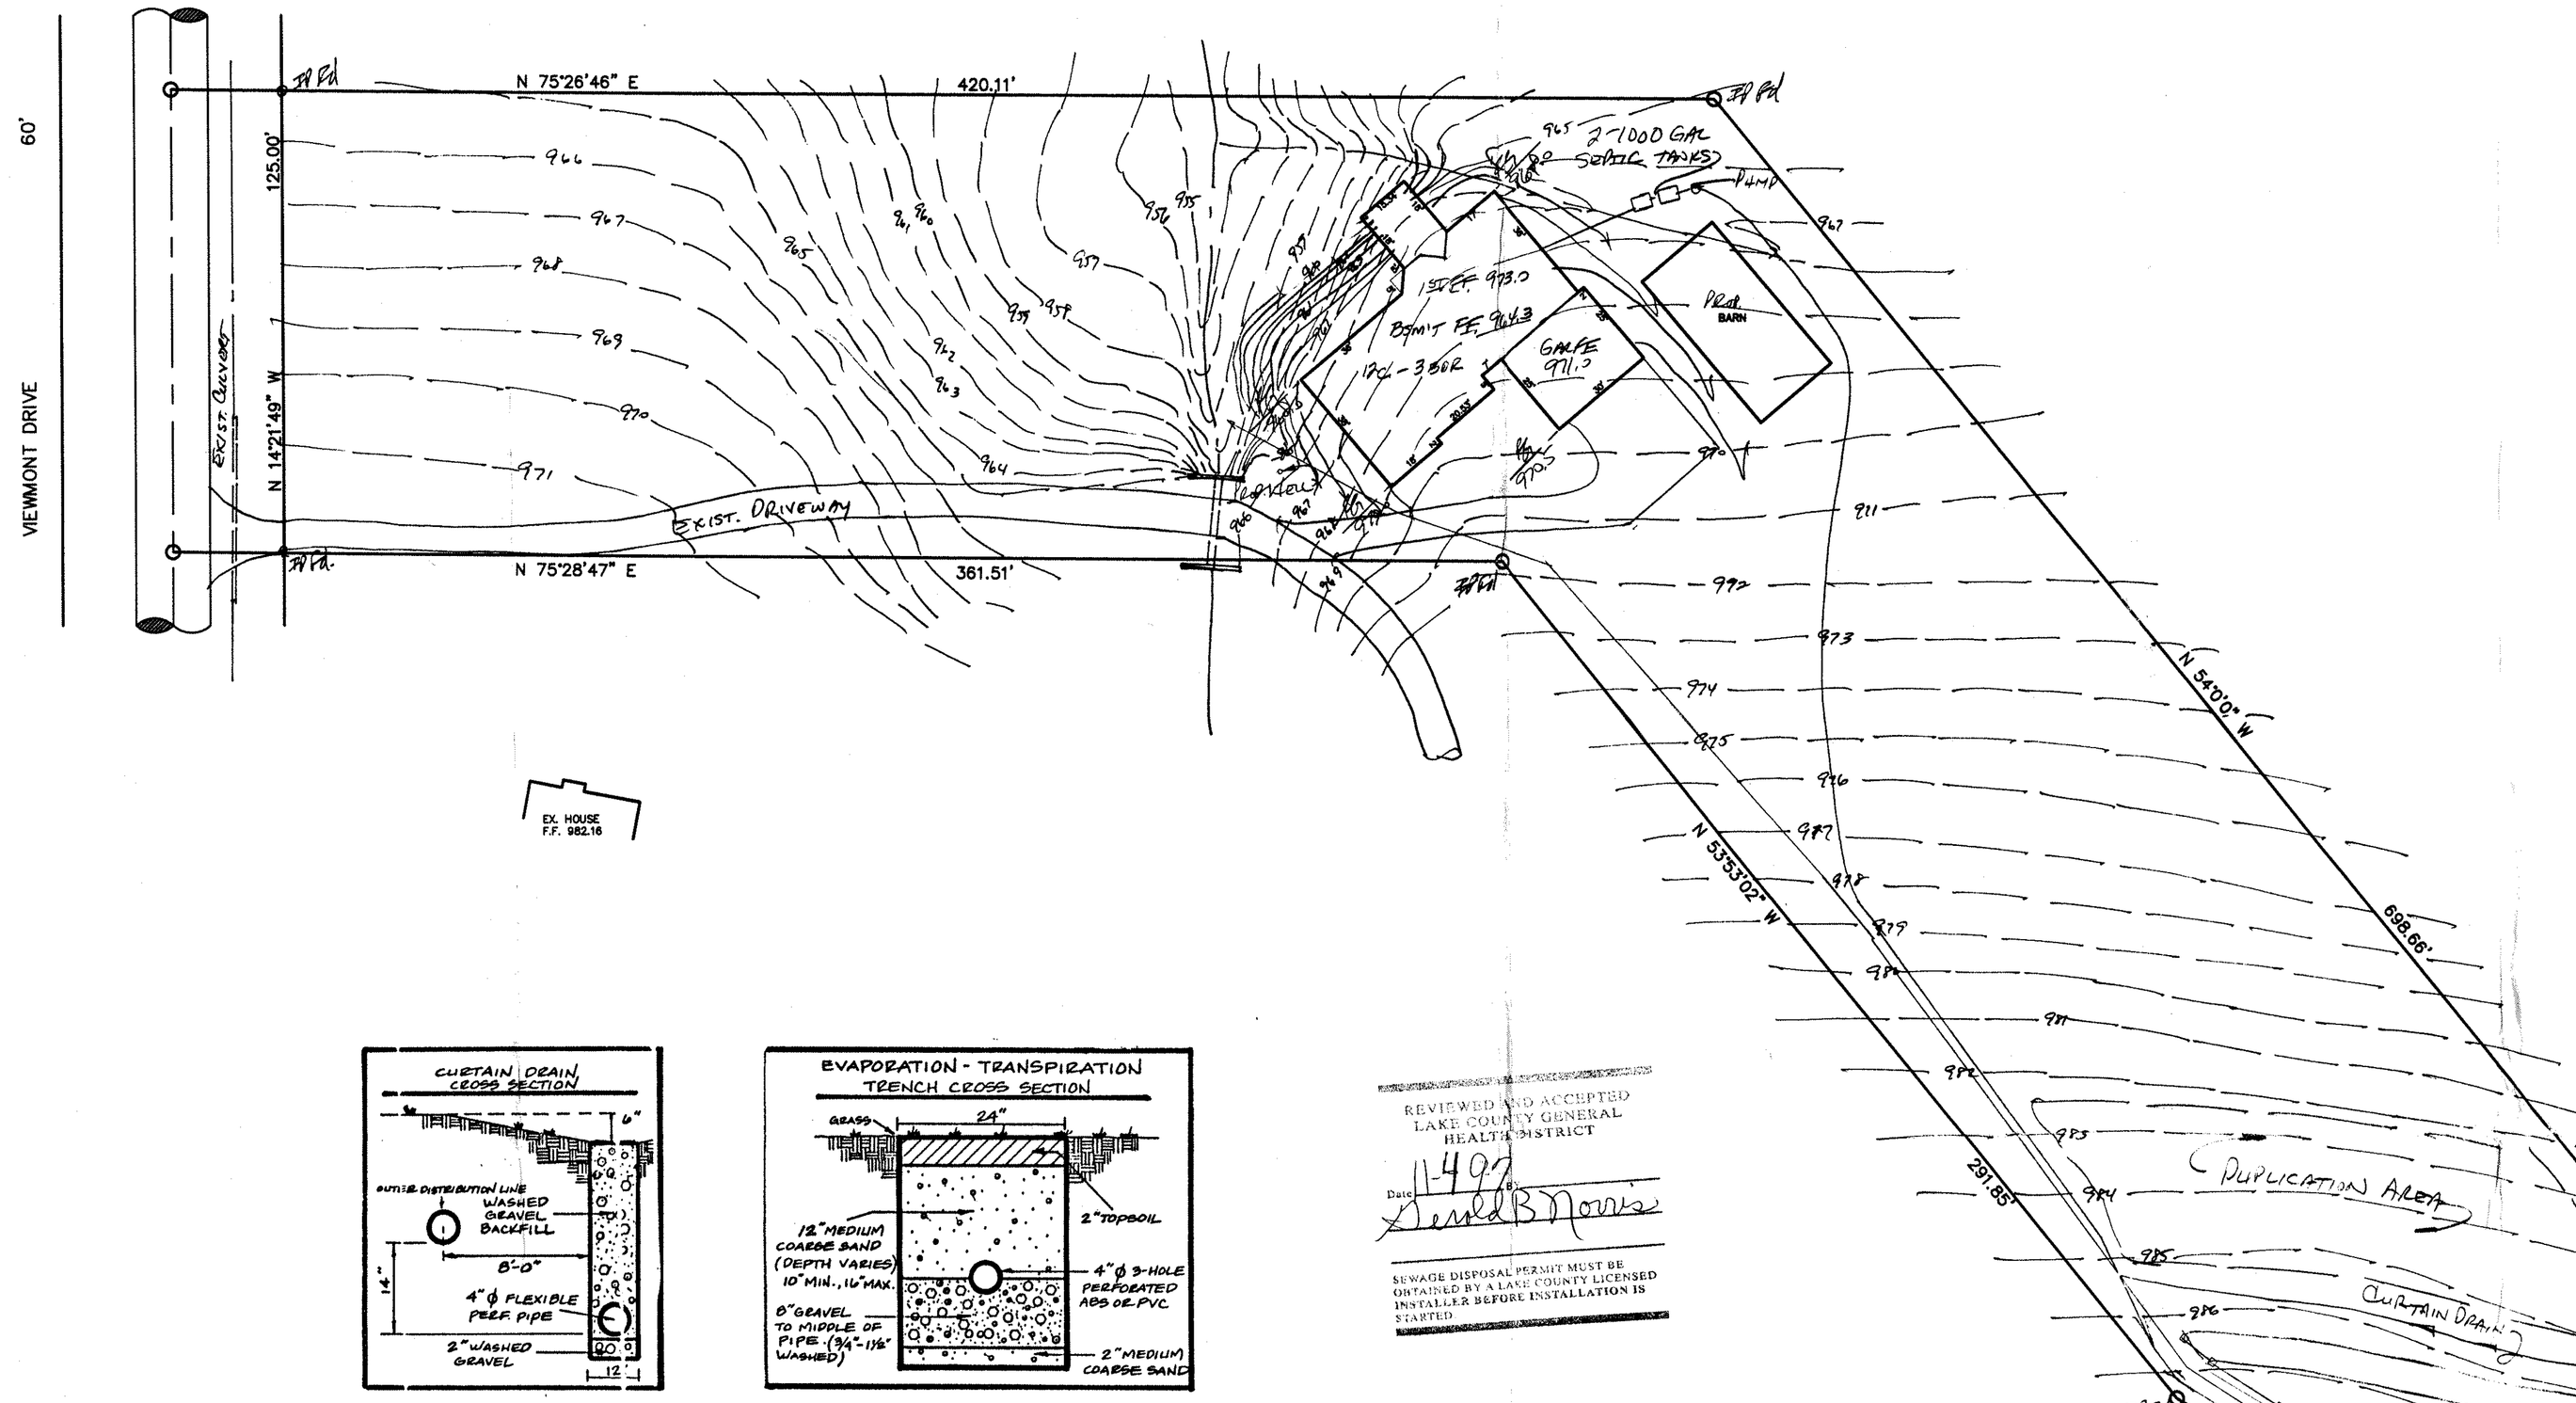

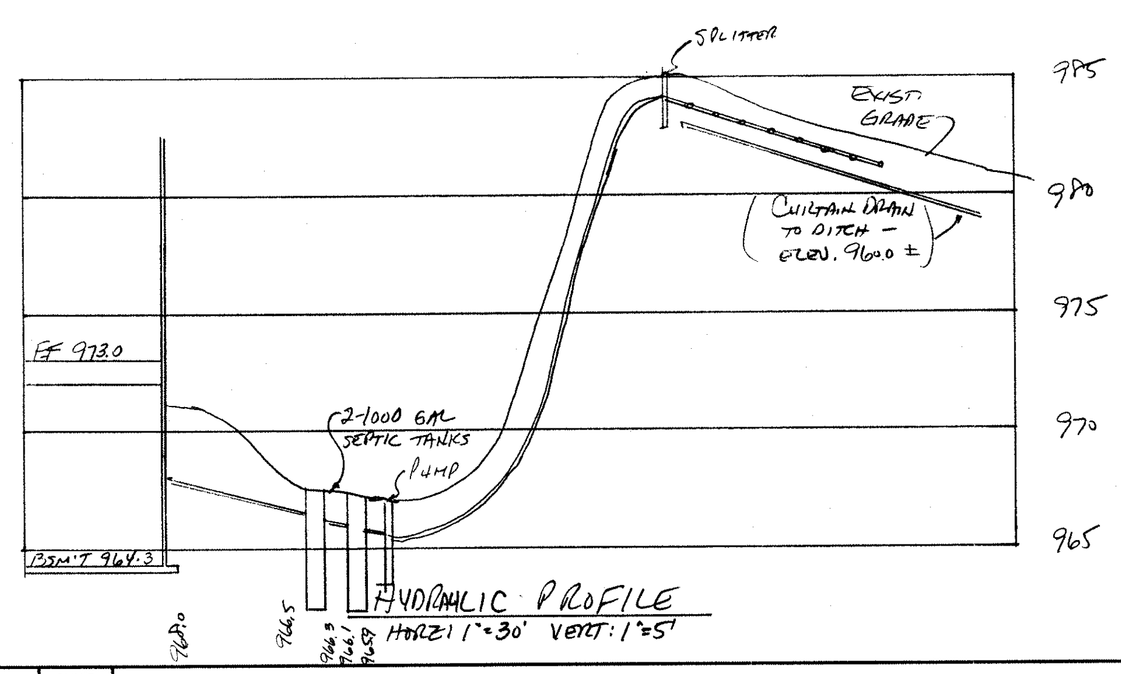

REVIEWED AND ACCEPTED
LAKE COUNTY GENERAL HEALTH DISTRICT
Date 11-4-97
Gerald B. Norris
SEWAGE DISPOSAL PERMIT MUST BE OBTAINED BY A LAKE COUNTY LICENSED INSTALLER BEFORE INSTALLATION IS STARTED

ZONING PERMIT #1297-8935
ISSUED 12/4/97
SUBJECT TO APPROVAL BY:
Lake County Planning Engr. ☐
Lake County Planning Dept. X
Lake County Planning Dept. ☐
Lake County Planning Dept. X

Grading Plan Approved as shown and/or noted
THOMAS P. GILLES, P.E.
Lake County Engineer
By WH Date 12-8-97

"I, the undersigned hereby certify that this topography indicated by 6", 1' or 2' contours, and elevations shown hereon represent an actual field survey made by me on the 16th day of July, 1997 and that the elevations were taken at appropriate intervals and that as of that date they existed as indicated hereon."

Harry S. Jones #6343
Name Reg. No.

STATE OF OHIO
HARRY S. JONES, JR.
S-6343
REGISTERED SURVEYOR

REV NO.	DESCRIPTION	DATE	BY	CHK'D
1	REVISED SEPTIC	10-13-97	HS	HS

BABCOCK, JONES AND ASSOCIATES, INC
CIVIL ENGINEERS – SURVEYORS – LAND PLANNERS
PAINESVILLE OHIO 44077

DATE	7/11/97
DESIGN BY	HS
DRAWN BY	M.S.
APPROVED BY	

SITE PLAN
for
P.P.N.: 08A-024A-00-040
for
PAULETTE LINGAFELTER

SCALE	1":30'
JOB NO	97-160
SHEET	1 OF 1