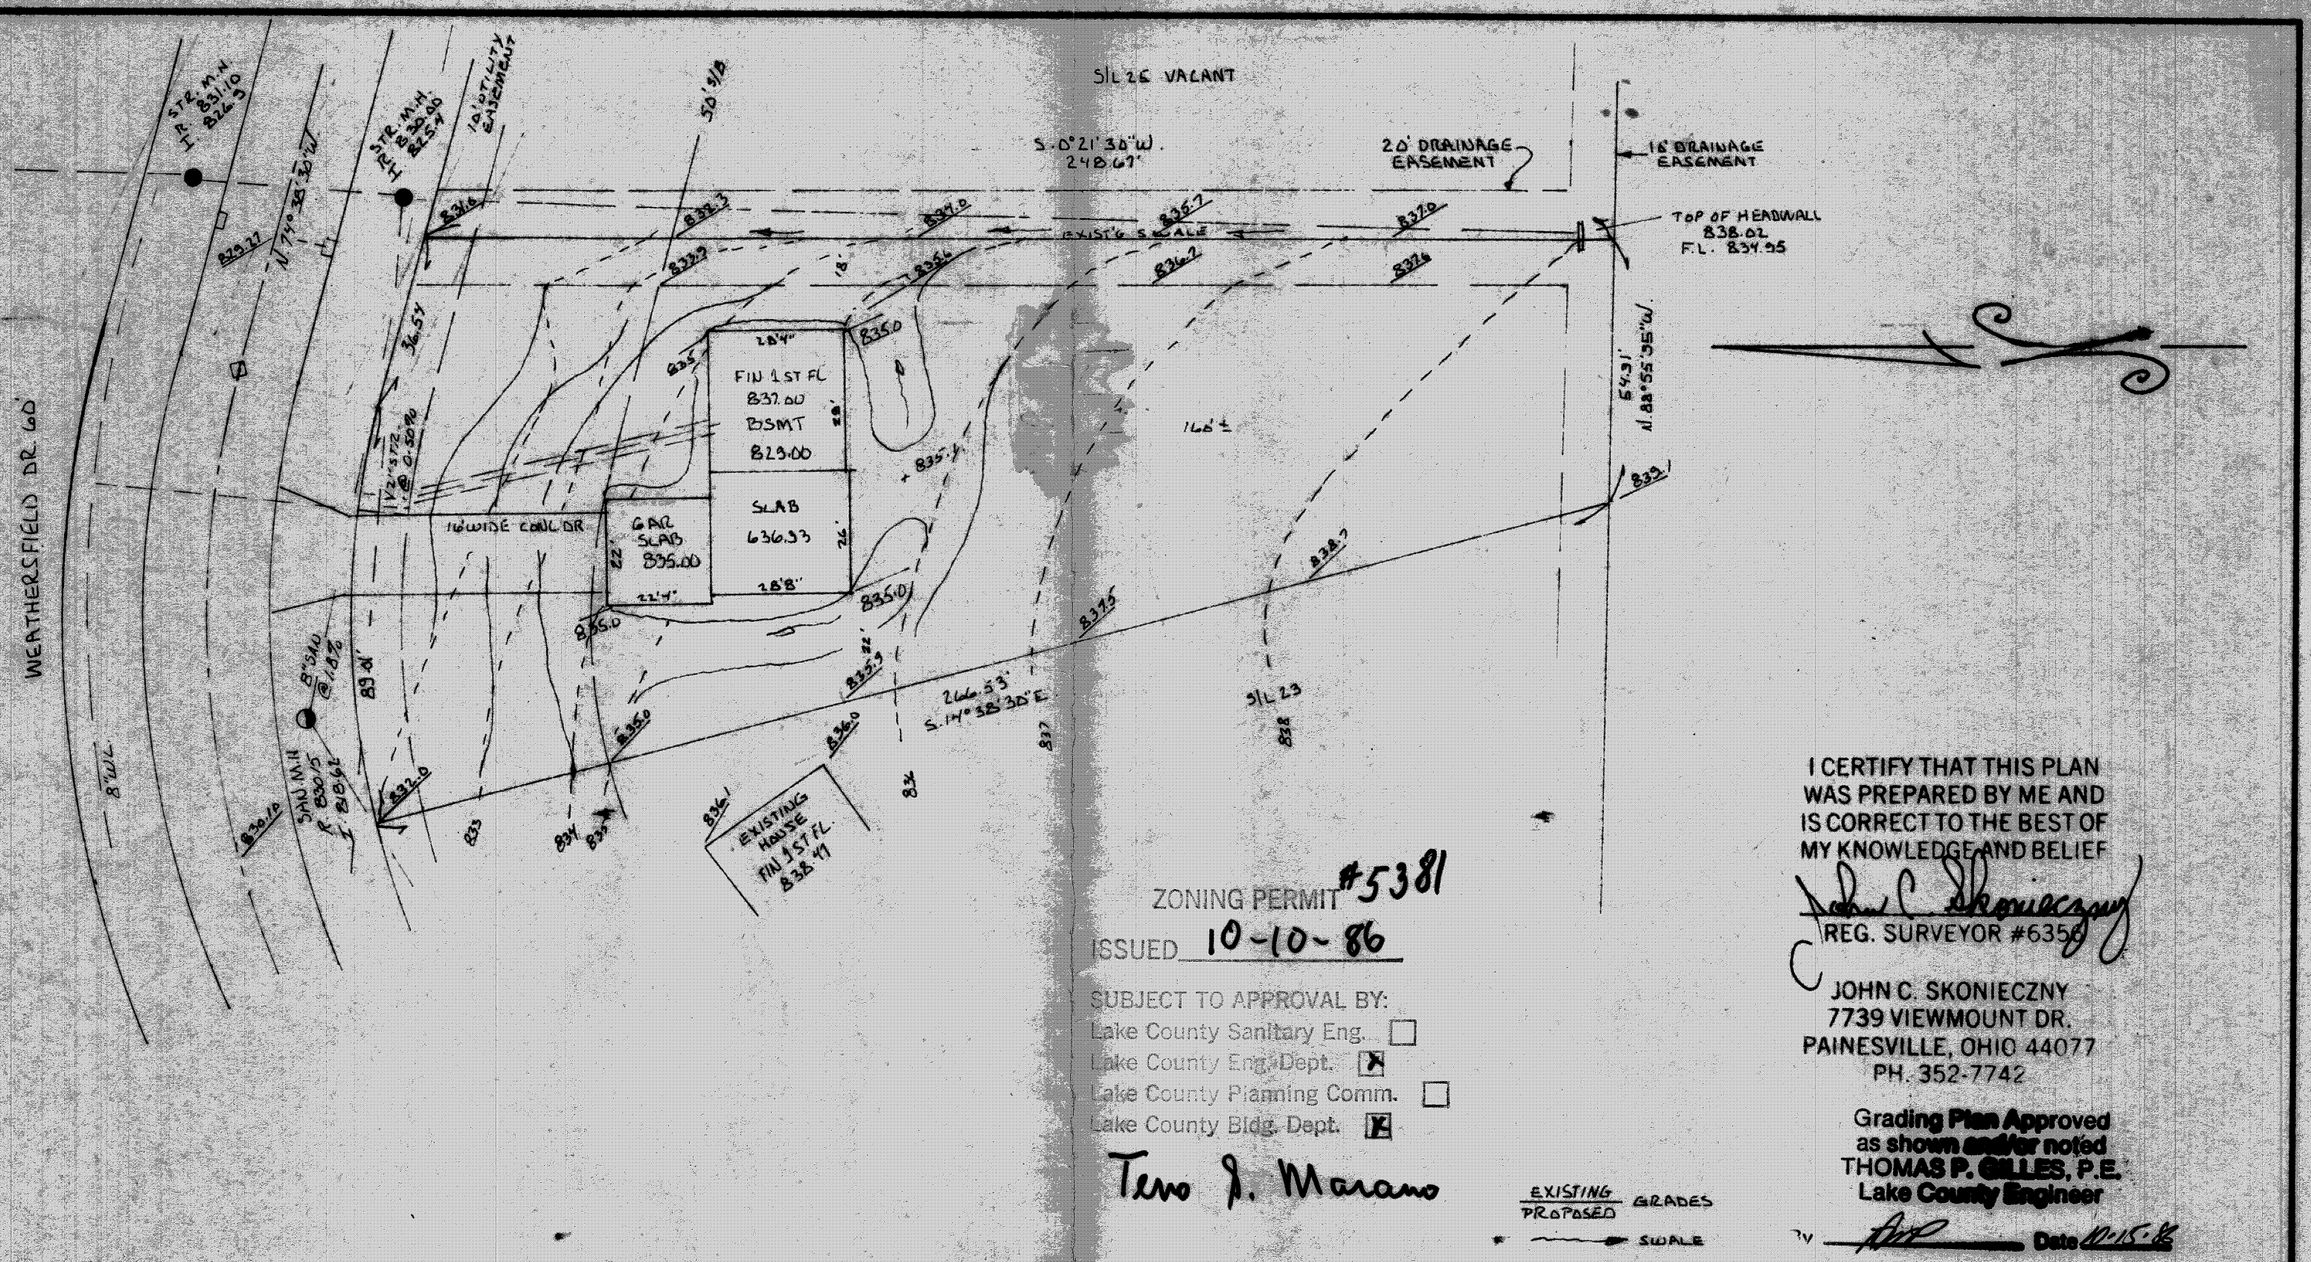

ZONING PERMIT #5381

ISSUED 10-10-86

SUBJECT TO APPROVAL BY:

- Lake County Sanitary Eng. ☐
- Lake County Eng. Dept. ☒
- Lake County Planning Comm. ☐
- Lake County Bldg. Dept. ☒

Terrence J. Marano

EXISTING / PROPOSED GRADES

SWALE

I CERTIFY THAT THIS PLAN WAS PREPARED BY ME AND IS CORRECT TO THE BEST OF MY KNOWLEDGE AND BELIEF

John C. Skonieczny

REG. SURVEYOR #6356

JOHN C. SKONIECZNY
7739 VIEWMOUNT DR.
PAINESVILLE, OHIO 44077
PH. 352-7742

Grading Plan Approved as shown and/or noted
THOMAS P. GILLES, P.E.
Lake County Engineer

By _____ Date 10-15-86

SITE PLAN FOR:
IDEAL AMERICAN HOMES INC.

SCALE: 1" = 30'	APPROVED BY	DRAWN BY J.L.S.
DATE: SEPT 86		

BEING SUBLOT 24 IN THE WEATHERSFIELD SUBDIVISION

LANDARD TOWNSHIP — LAKE COUNTY, OHIO

JOB NO 86-576

DRAWING NUMBER 86-575