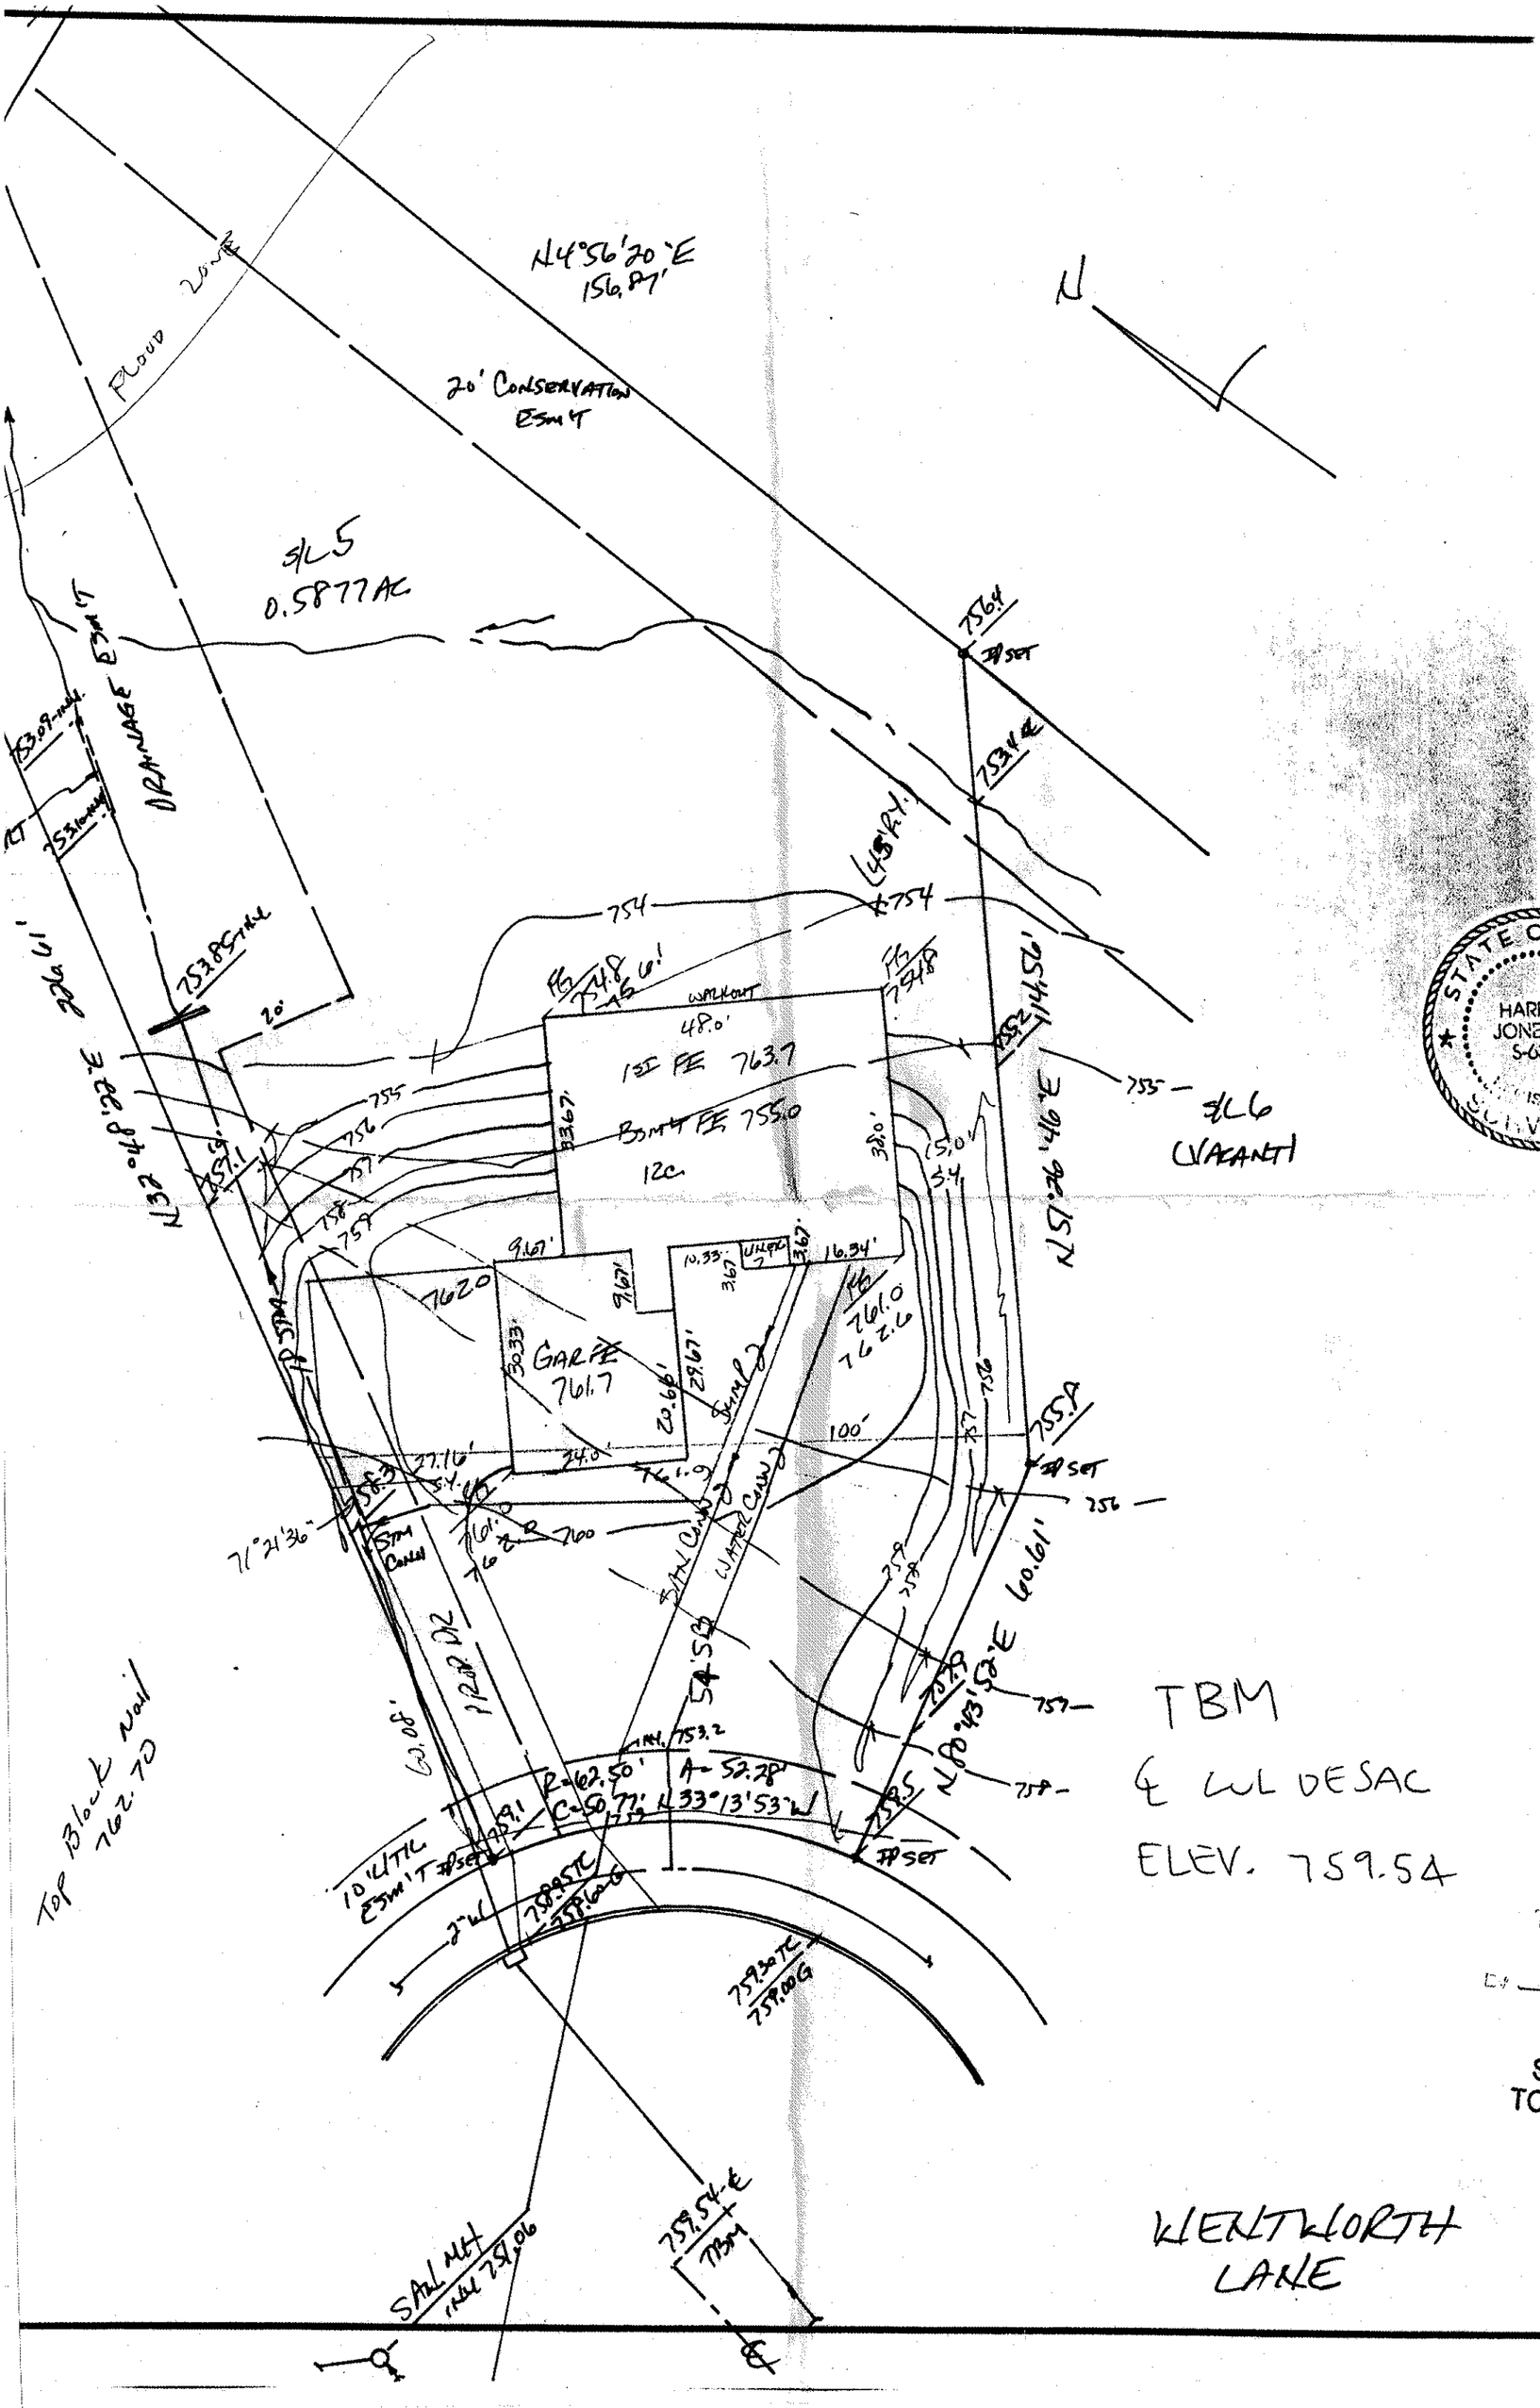
N4°56'20"E
156.87'
N
FLOOD ZONE
20' CONSERVATION ESM'T
S/L 5
0.5877AC
DRAINAGE ESM'T
756.4
753.4
754
754
WALKOUT
48.0'
1ST FE 763.7
BSM'T FE 755.0
12C
755
756
757
758
759
755
S/L 6
(VACANT)
N51°26'46"E
114.56'
N32°48'22"E
226.61'
753.85
762.0
GAR FE
761.7
761.0
762.6
100'
755.8
756
757
758
N80°43'52"E
60.61'
71°21'36"
STM CONN
PROP DR
60.08'
R=62.50'
A=52.28'
C=50.77'
N33°13'53"W
10' UTIL ESM'T
759.30TC
759.00G
759.54 ℄
TBM
SAN MH
INV 751.06
Top Block Nail
762.70
TBM
℄ CUL DESAC
ELEV. 759.54
WENTWORTH
LANE