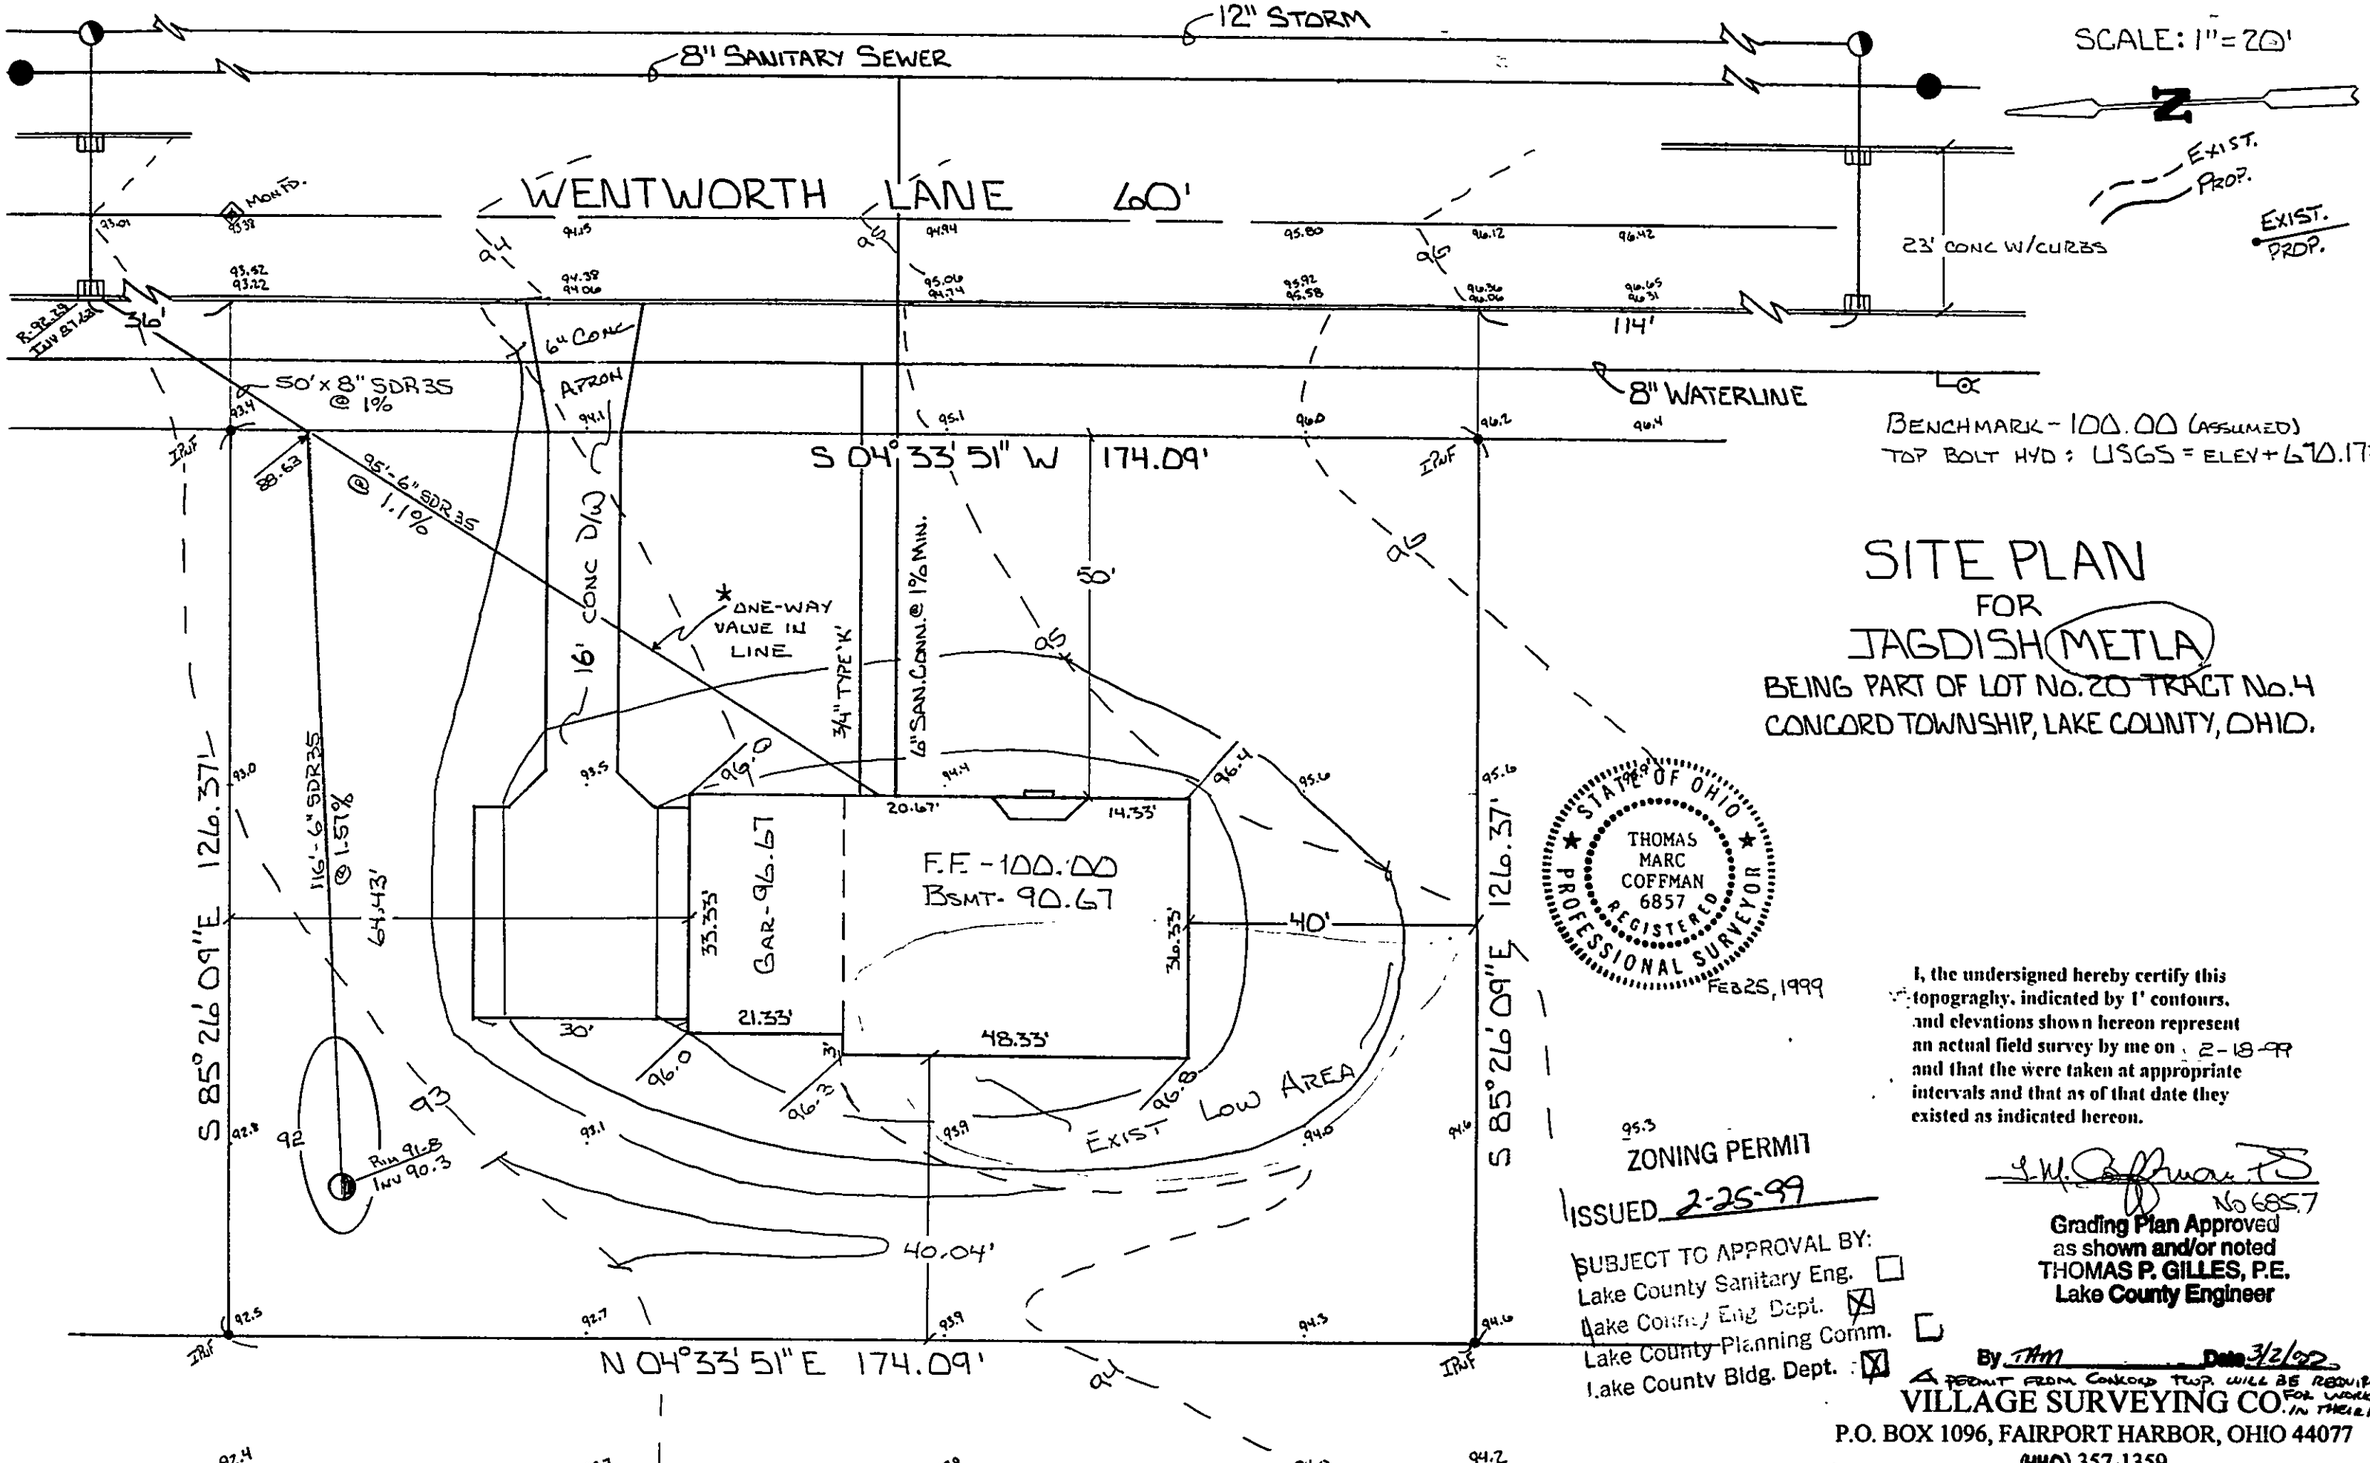

SITE PLAN
FOR
JAGDISH METLA
BEING PART OF LOT No. 20 TRACT No. 4
CONCORD TOWNSHIP, LAKE COUNTY, OHIO.

STATE OF OHIO
THOMAS MARC COFFMAN 6857
REGISTERED PROFESSIONAL SURVEYOR
FEB 25, 1999

I, the undersigned hereby certify this topograghy, indicated by 1' contours, and elevations shown hereon represent an actual field survey by me on 2-18-99 and that the were taken at appropriate intervals and that as of that date they existed as indicated hereon.

T. M. Coffman PS
No 6857

ZONING PERMIT
ISSUED 2-25-99

SUBJECT TO APPROVAL BY:
Lake County Sanitary Eng. ☐
Lake County Eng. Dept. ☒
Lake County Planning Comm. ☐
Lake County Bldg. Dept. ☒

Grading Plan Approved
as shown and/or noted
THOMAS P. GILLES, P.E.
Lake County Engineer

By TPM Date 3/2/99

A PERMIT FROM CONCORD TWP. WILL BE REQUIRED FOR WORK IN THEIR R/W

VILLAGE SURVEYING CO.
P.O. BOX 1096, FAIRPORT HARBOR, OHIO 44077
(440) 357-1359