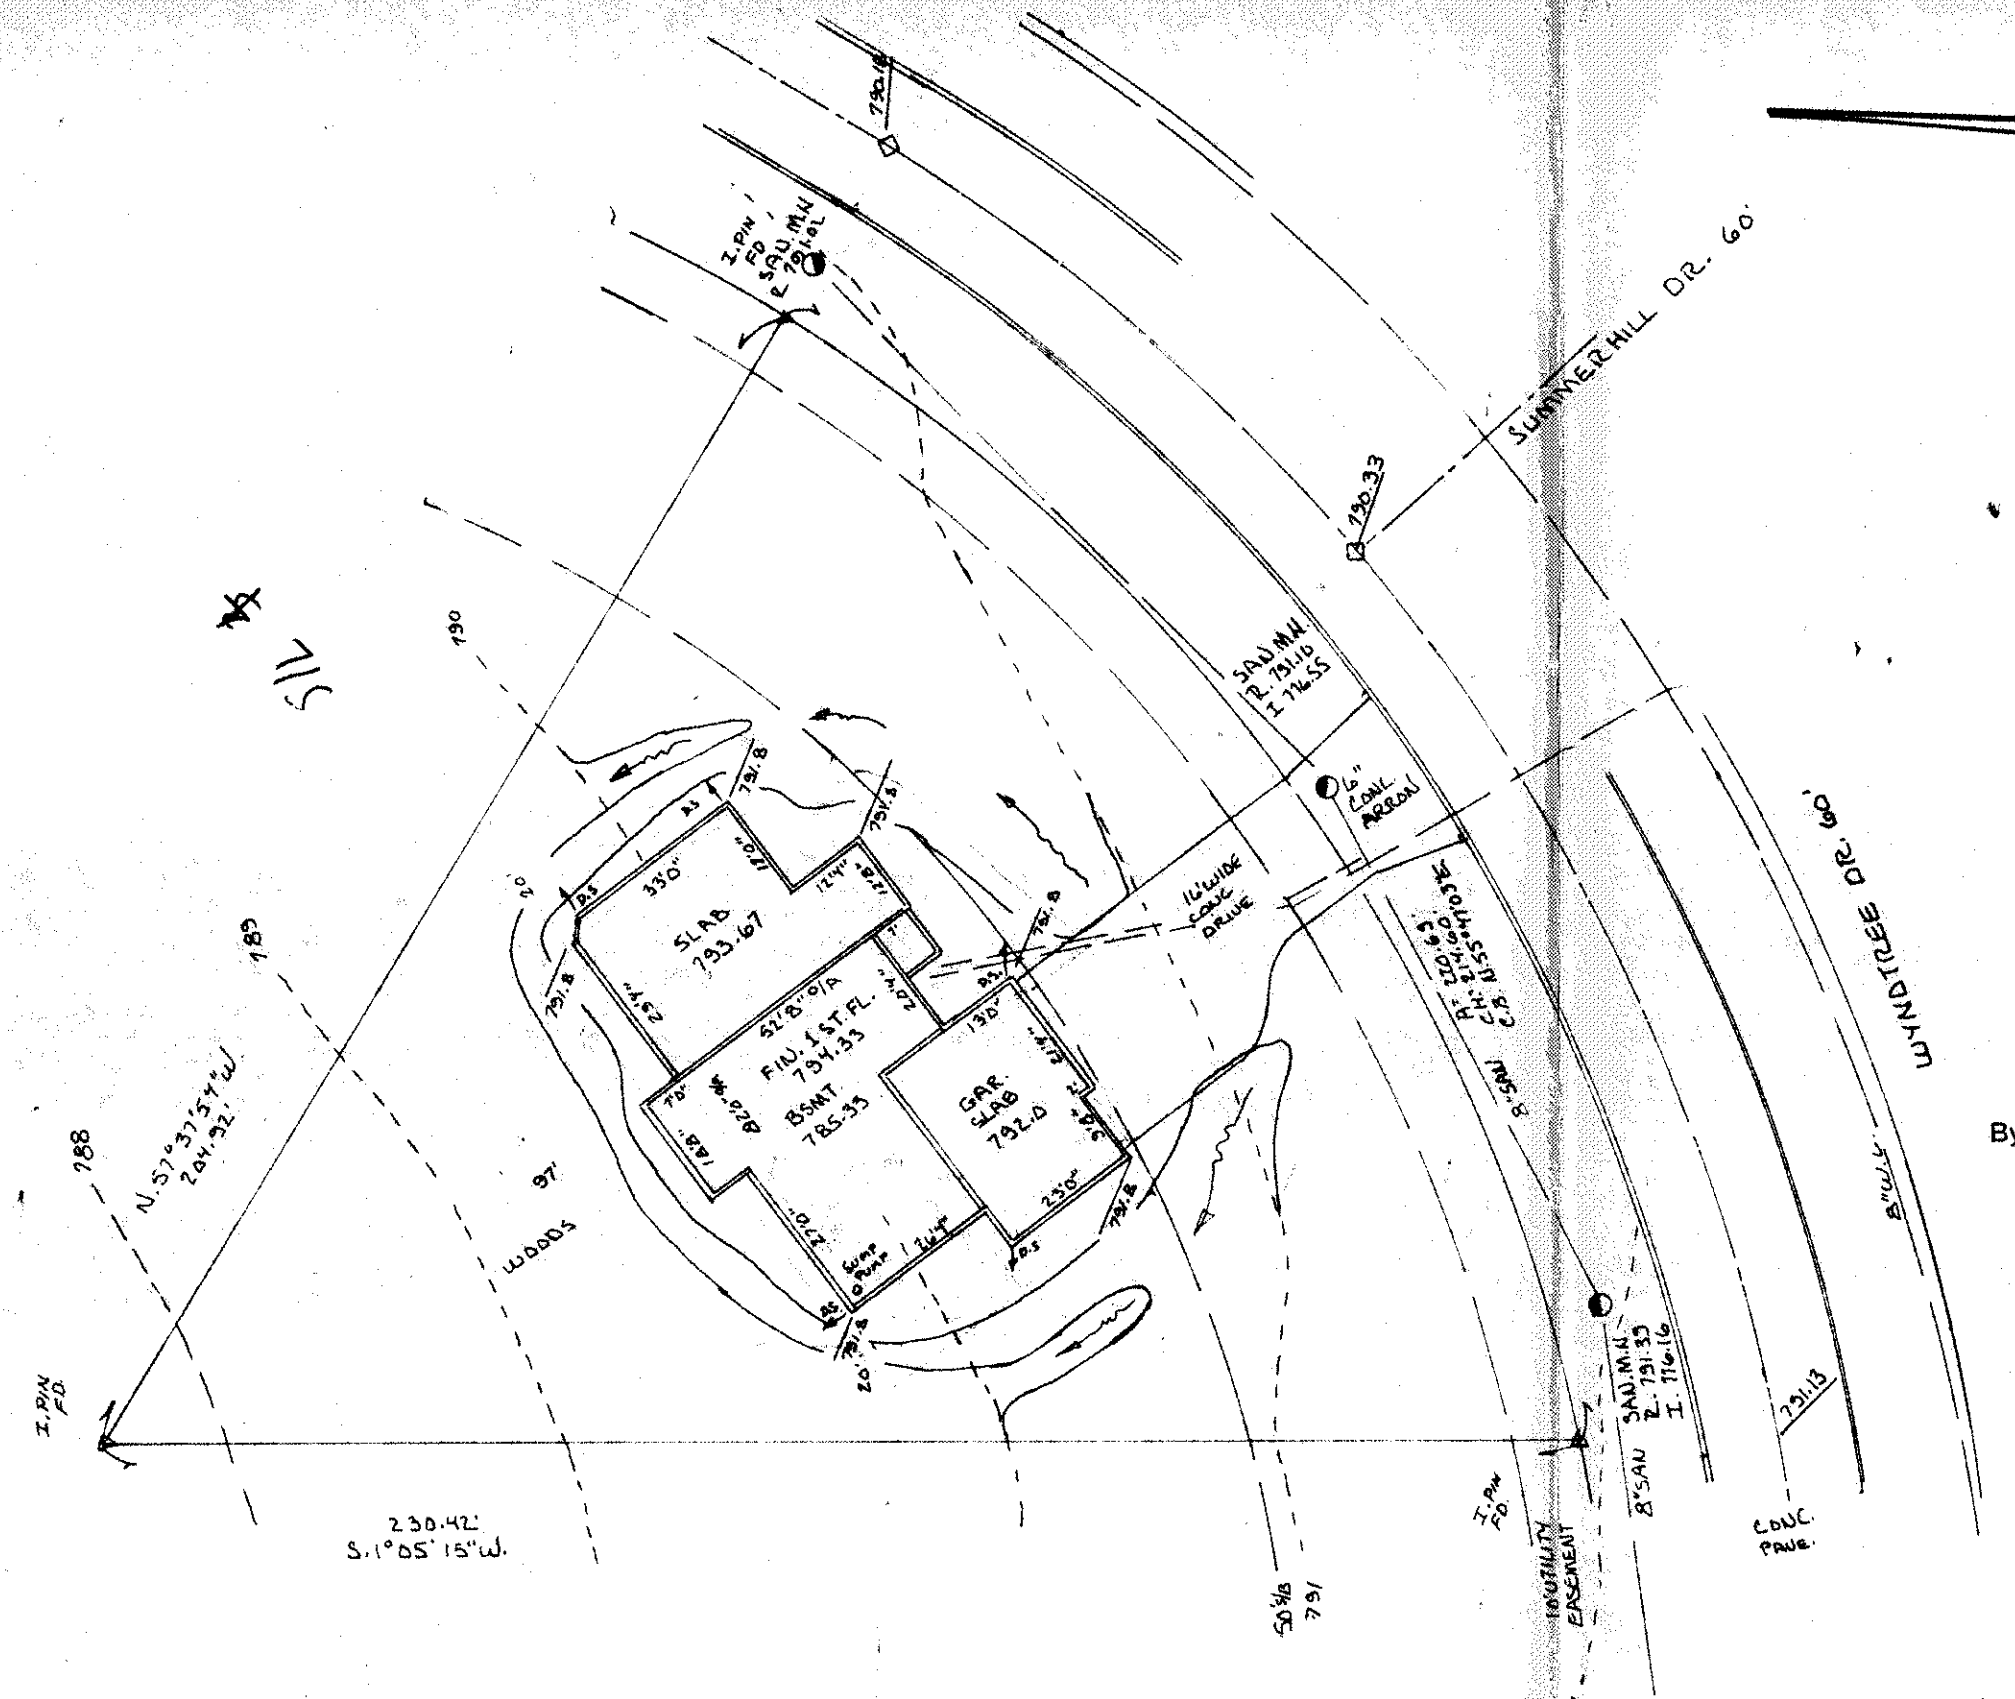

REVISIONS:
△ JULY 14, 1988 CHG. HSE.

ZONING PERMIT #5893
ISSUED 7-27-88
SUBJECT TO APPROVAL BY:
Lake County Sanitary Eng. ☐
Lake County Eng. Dept. ☒
Lake County Planning Comm. ☐
Lake County Bldg. Dept. ☒
Terro S Marano

Grading Plan Approved
as shown and/or noted
THOMAS P. GILLES, P.E.
Lake County Engineer
By _____ Date 7/27/88

STATE OF OHIO
JOHN CLOUD SKONIECZNY
S-6356
REGISTERED SURVEYOR

I CERTIFY THAT THIS PLAN WAS PREPARED BY ME AND IS CORRECT TO THE BEST OF MY KNOWLEDGE AND BELIEF

John C. Skonieczny
REG. SURVEYOR #6356

JOHN C. SKONIECZNY
7739 VIEWMOUNT DR.
PAINESVILLE, OHIO 44077
PH. 352-7742

SITE PLAN FOR:
IDEAL AMERICAN HOMES INC.

SCALE: 1" = 30'	APPROVED BY	DRAWN BY JCS
DATE: JUN 88		

BEING SUBLOT 3 IN THE WYNDTREE SUBDIVISION
TOWNSHIP OF CONCORD COUNTY OF LAKE STATE OF OHIO

JOB # 88-771 | DRAWING NUMBER 88-671