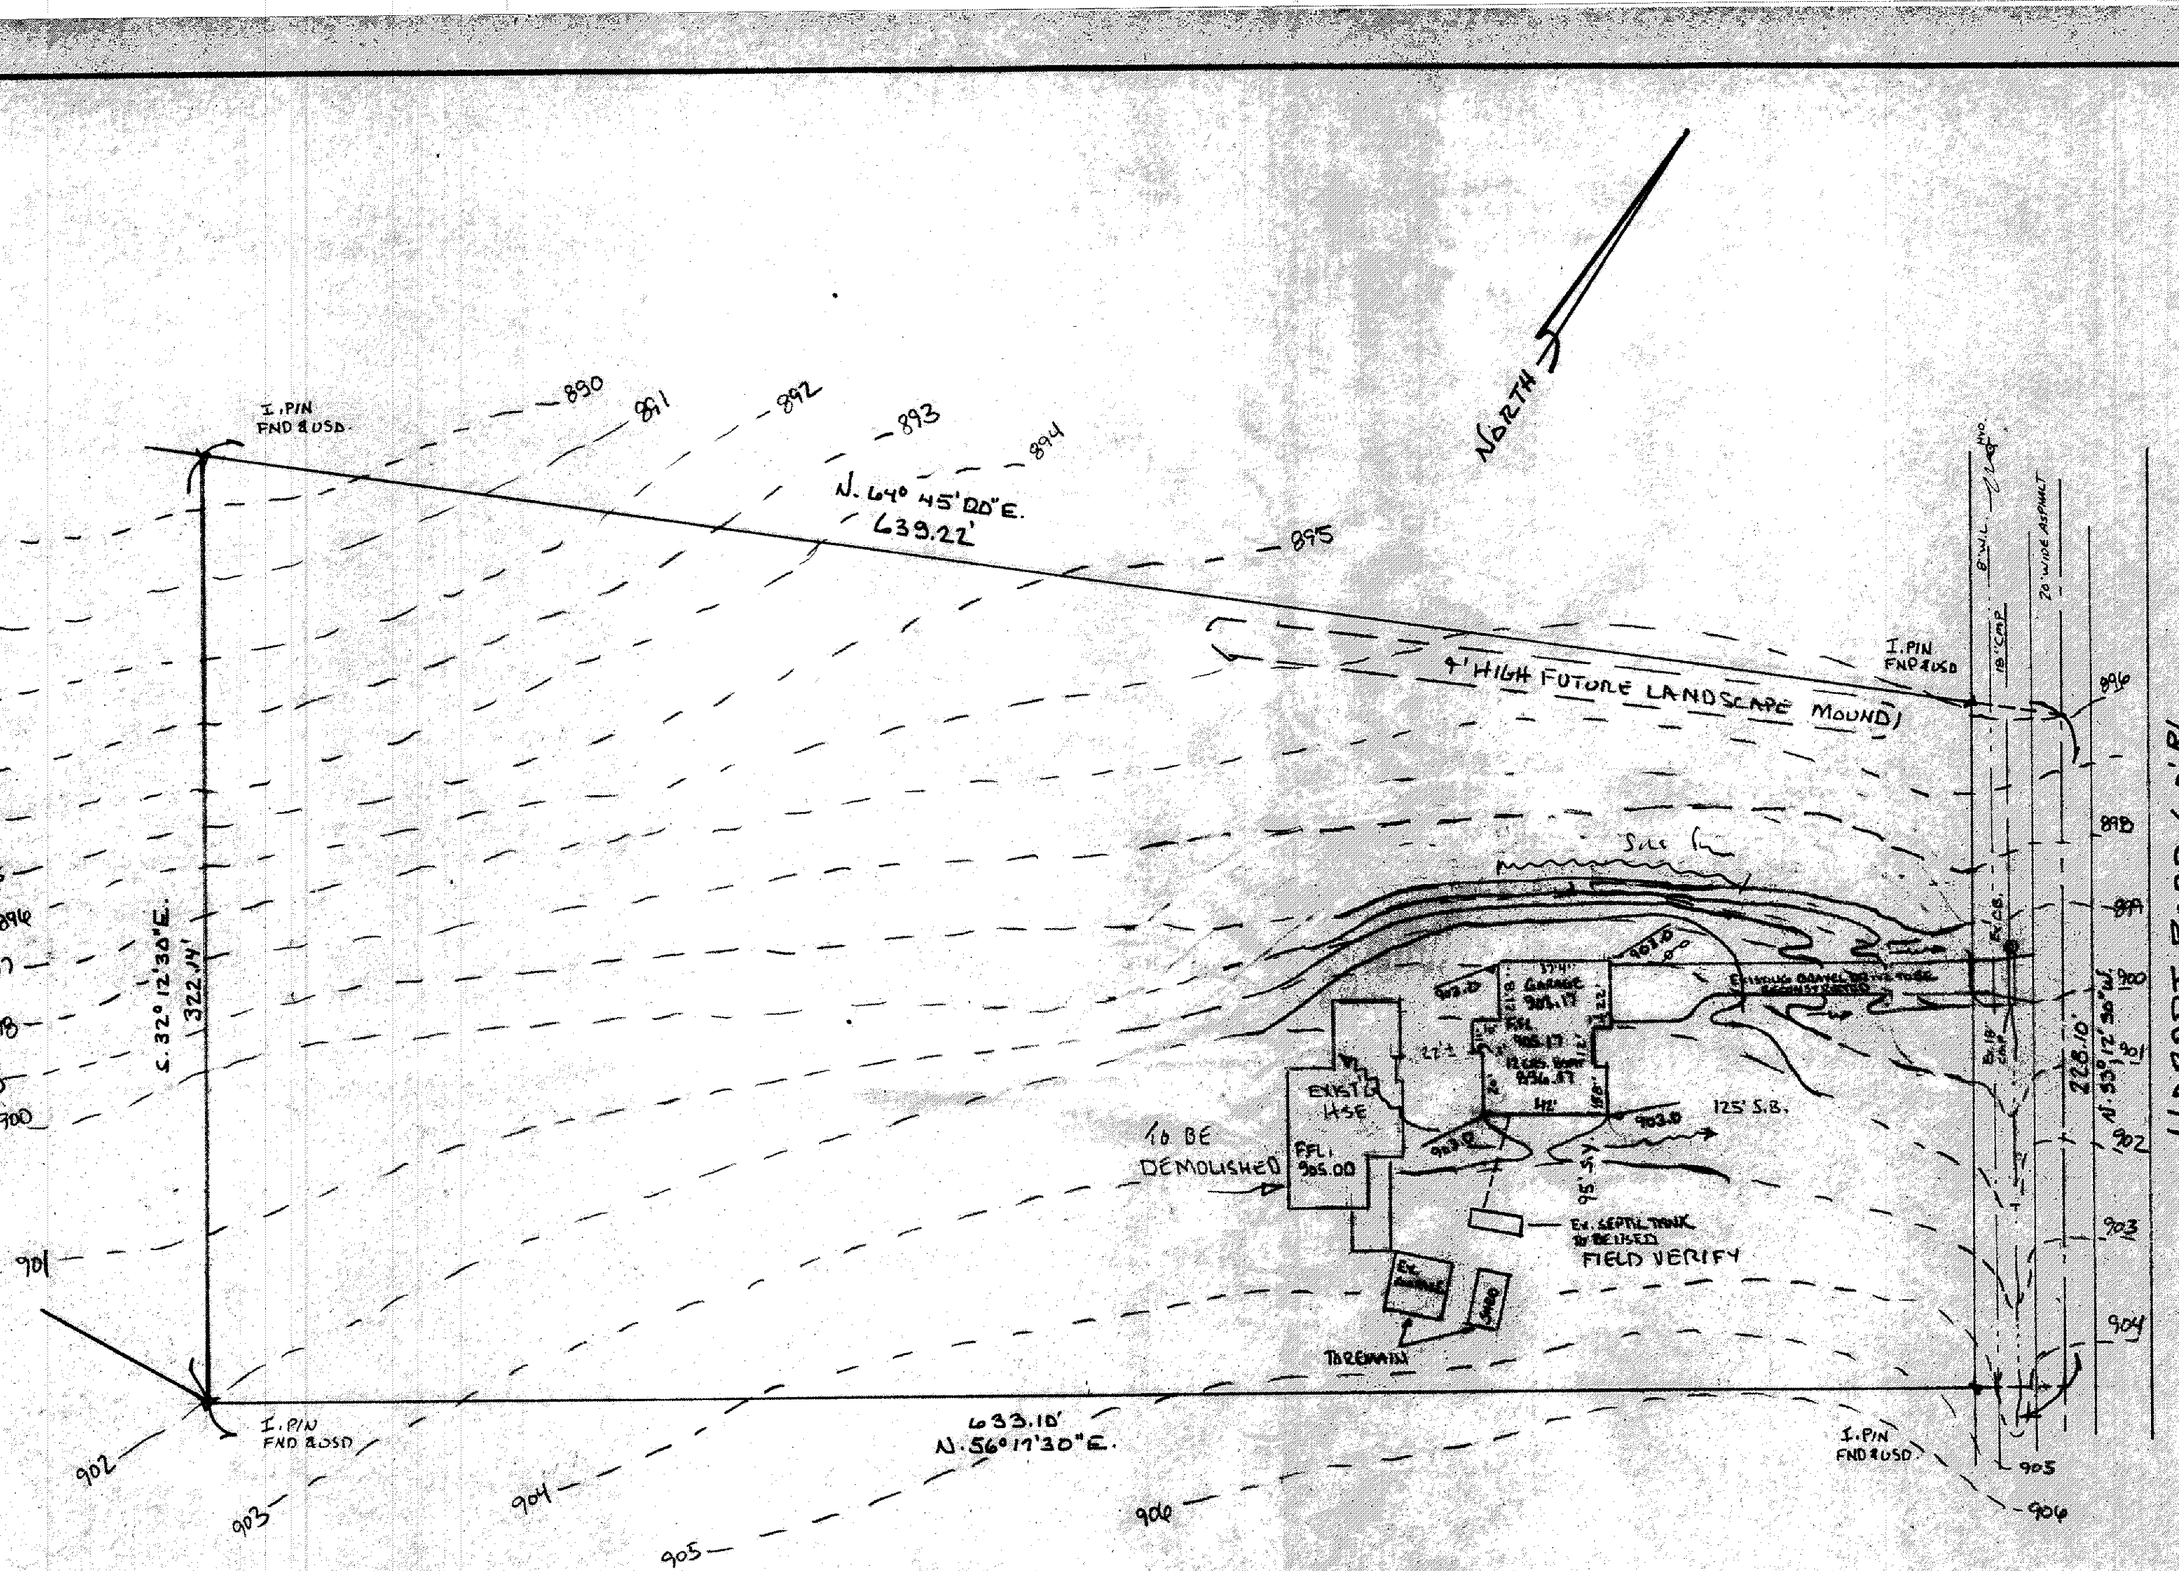

NOTES!

1) SEPTIC AND GAS TO BE CONNECTED TO EXIST'G LINES
2) ELEC. TO BE BURIED FROM EXIST'G POWER POLE
3) ROOF DRAINS TO BE SPLASH BLOCKED

EXISTING GRADES
PROPOSED
SWALE

STATE OF OHIO
JOHN CLOUD SKONIECZNY
6-6386
REGISTERED SURVEYOR

John C Skonieczny

JOHN C SKONIECZNY P.S.
7739 VIEWMOUNT DR.
PAINESVILLE OHIO
44077

440-352-7742 OFF.
440-537-4111 CELL

Stormwater Management Plan
Approved as shown and/or noted
JAMES R. GILLS, P.E.
County Drainage Engineer
By J.S. Date 10/12/11

20' 15' 10' 5' 0 20' 40' 80' 120'
GRAPHIC SCALE
1" = 40'

SITE PLAN FOR: B.V.Q. HOMES

10166 HOB

SCALE: 1" = 40'	APPROVED BY:	DRAWN BY:
DATE: SEPT. 11		REVISED

BEING P.P.# 20-A-023-G-00-008-0 RECORDED IN PLAT L.C.R.'S
CITY OF KIRTLAND - LAKE COUNTY - OHIO

DRAWING NUM 11-30

2 WORKING DAYS BEFORE YOU DIG
CALL TOLL FREE 800-362-2764
OHIO UTILITIES PROTECTION SERVICE