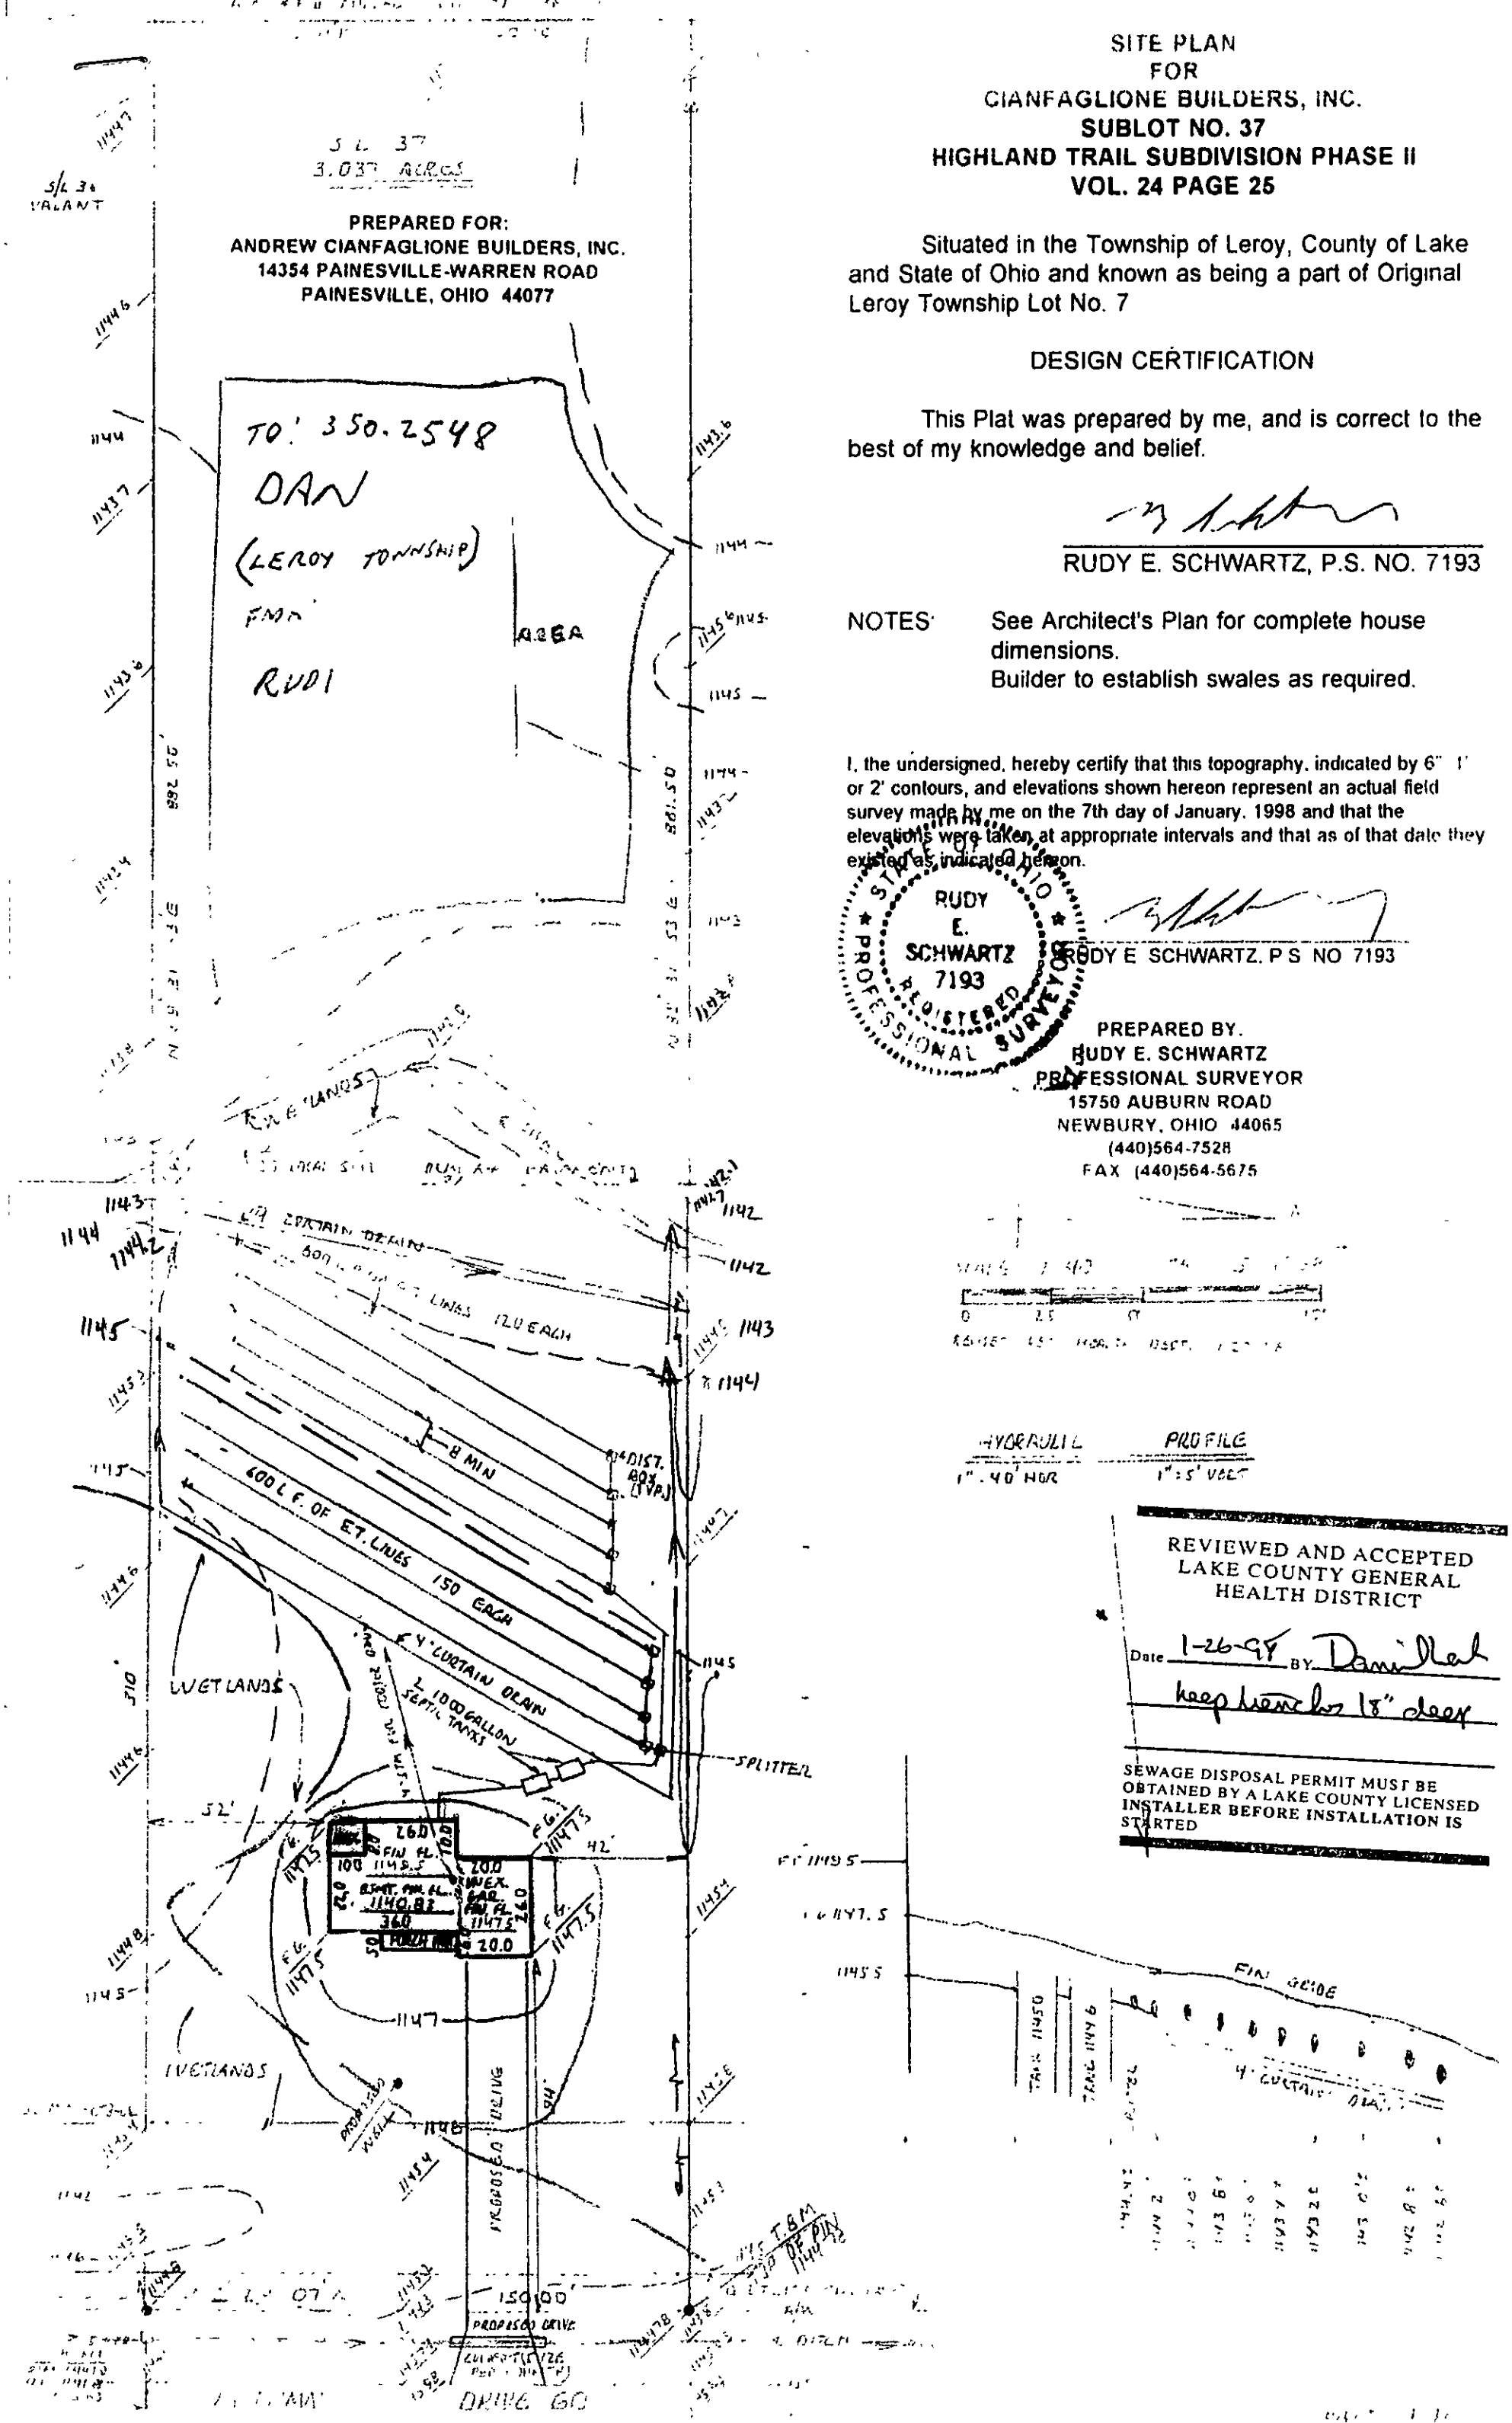

SITE PLAN
FOR
CIANFAGLIONE BUILDERS, INC.
SUBLOT NO. 37
HIGHLAND TRAIL SUBDIVISION PHASE II
VOL. 24 PAGE 25

Situated in the Township of Leroy, County of Lake and State of Ohio and known as being a part of Original Leroy Township Lot No. 7

DESIGN CERTIFICATION

This Plat was prepared by me, and is correct to the best of my knowledge and belief.

RUDY E. SCHWARTZ, P.S. NO. 7193

NOTES: See Architect's Plan for complete house dimensions.
Builder to establish swales as required.

I, the undersigned, hereby certify that this topography, indicated by 6", 1' or 2' contours, and elevations shown hereon represent an actual field survey made by me on the 7th day of January, 1998 and that the elevations were taken at appropriate intervals and that as of that date they existed as indicated hereon.

STATE OF OHIO RUDY E. SCHWARTZ 7193 REGISTERED PROFESSIONAL SURVEYOR

RUDY E SCHWARTZ, P S NO 7193

PREPARED BY.
RUDY E. SCHWARTZ
PROFESSIONAL SURVEYOR
15750 AUBURN ROAD
NEWBURY, OHIO 44065
(440)564-7528
FAX (440)564-5675

HYDRAULIC 1" = 40' HOR — PROFILE 1" = 5' VERT

REVIEWED AND ACCEPTED
LAKE COUNTY GENERAL
HEALTH DISTRICT

Date 1-26-98 BY Dan Hall

keep home low 18" deep

SEWAGE DISPOSAL PERMIT MUST BE OBTAINED BY A LAKE COUNTY LICENSED INSTALLER BEFORE INSTALLATION IS STARTED