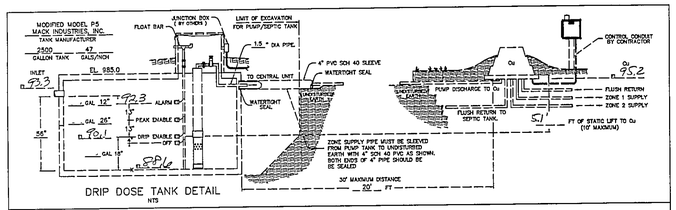
MODIFIED MODEL P5
MACK INDUSTRIES, INC.
TANK MANUFACTURER
2500 GALLON TANK
47 GALS/INCH
JUNCTION BOX (BY OTHERS)
FLOAT BAR
LIMIT OF EXCAVATION FOR PUMP/SEPTIC TANK
1.5" DIA PIPE
TO CENTRAL UNIT
4" PVC SCH 40 SLEEVE
WATERTIGHT SEAL
CONTROL CONDUIT BY CONTRACTOR
FLUSH RETURN
ZONE 1 SUPPLY
ZONE 2 SUPPLY
FT OF STATIC LIFT TO CU (10' MAXIMUM)
PUMP DISCHARGE TO CU
FLUSH RETURN TO SEPTIC TANK
30' MAXIMUM DISTANCE
ALARM
PEAK ENABLE
DRIP ENABLE
