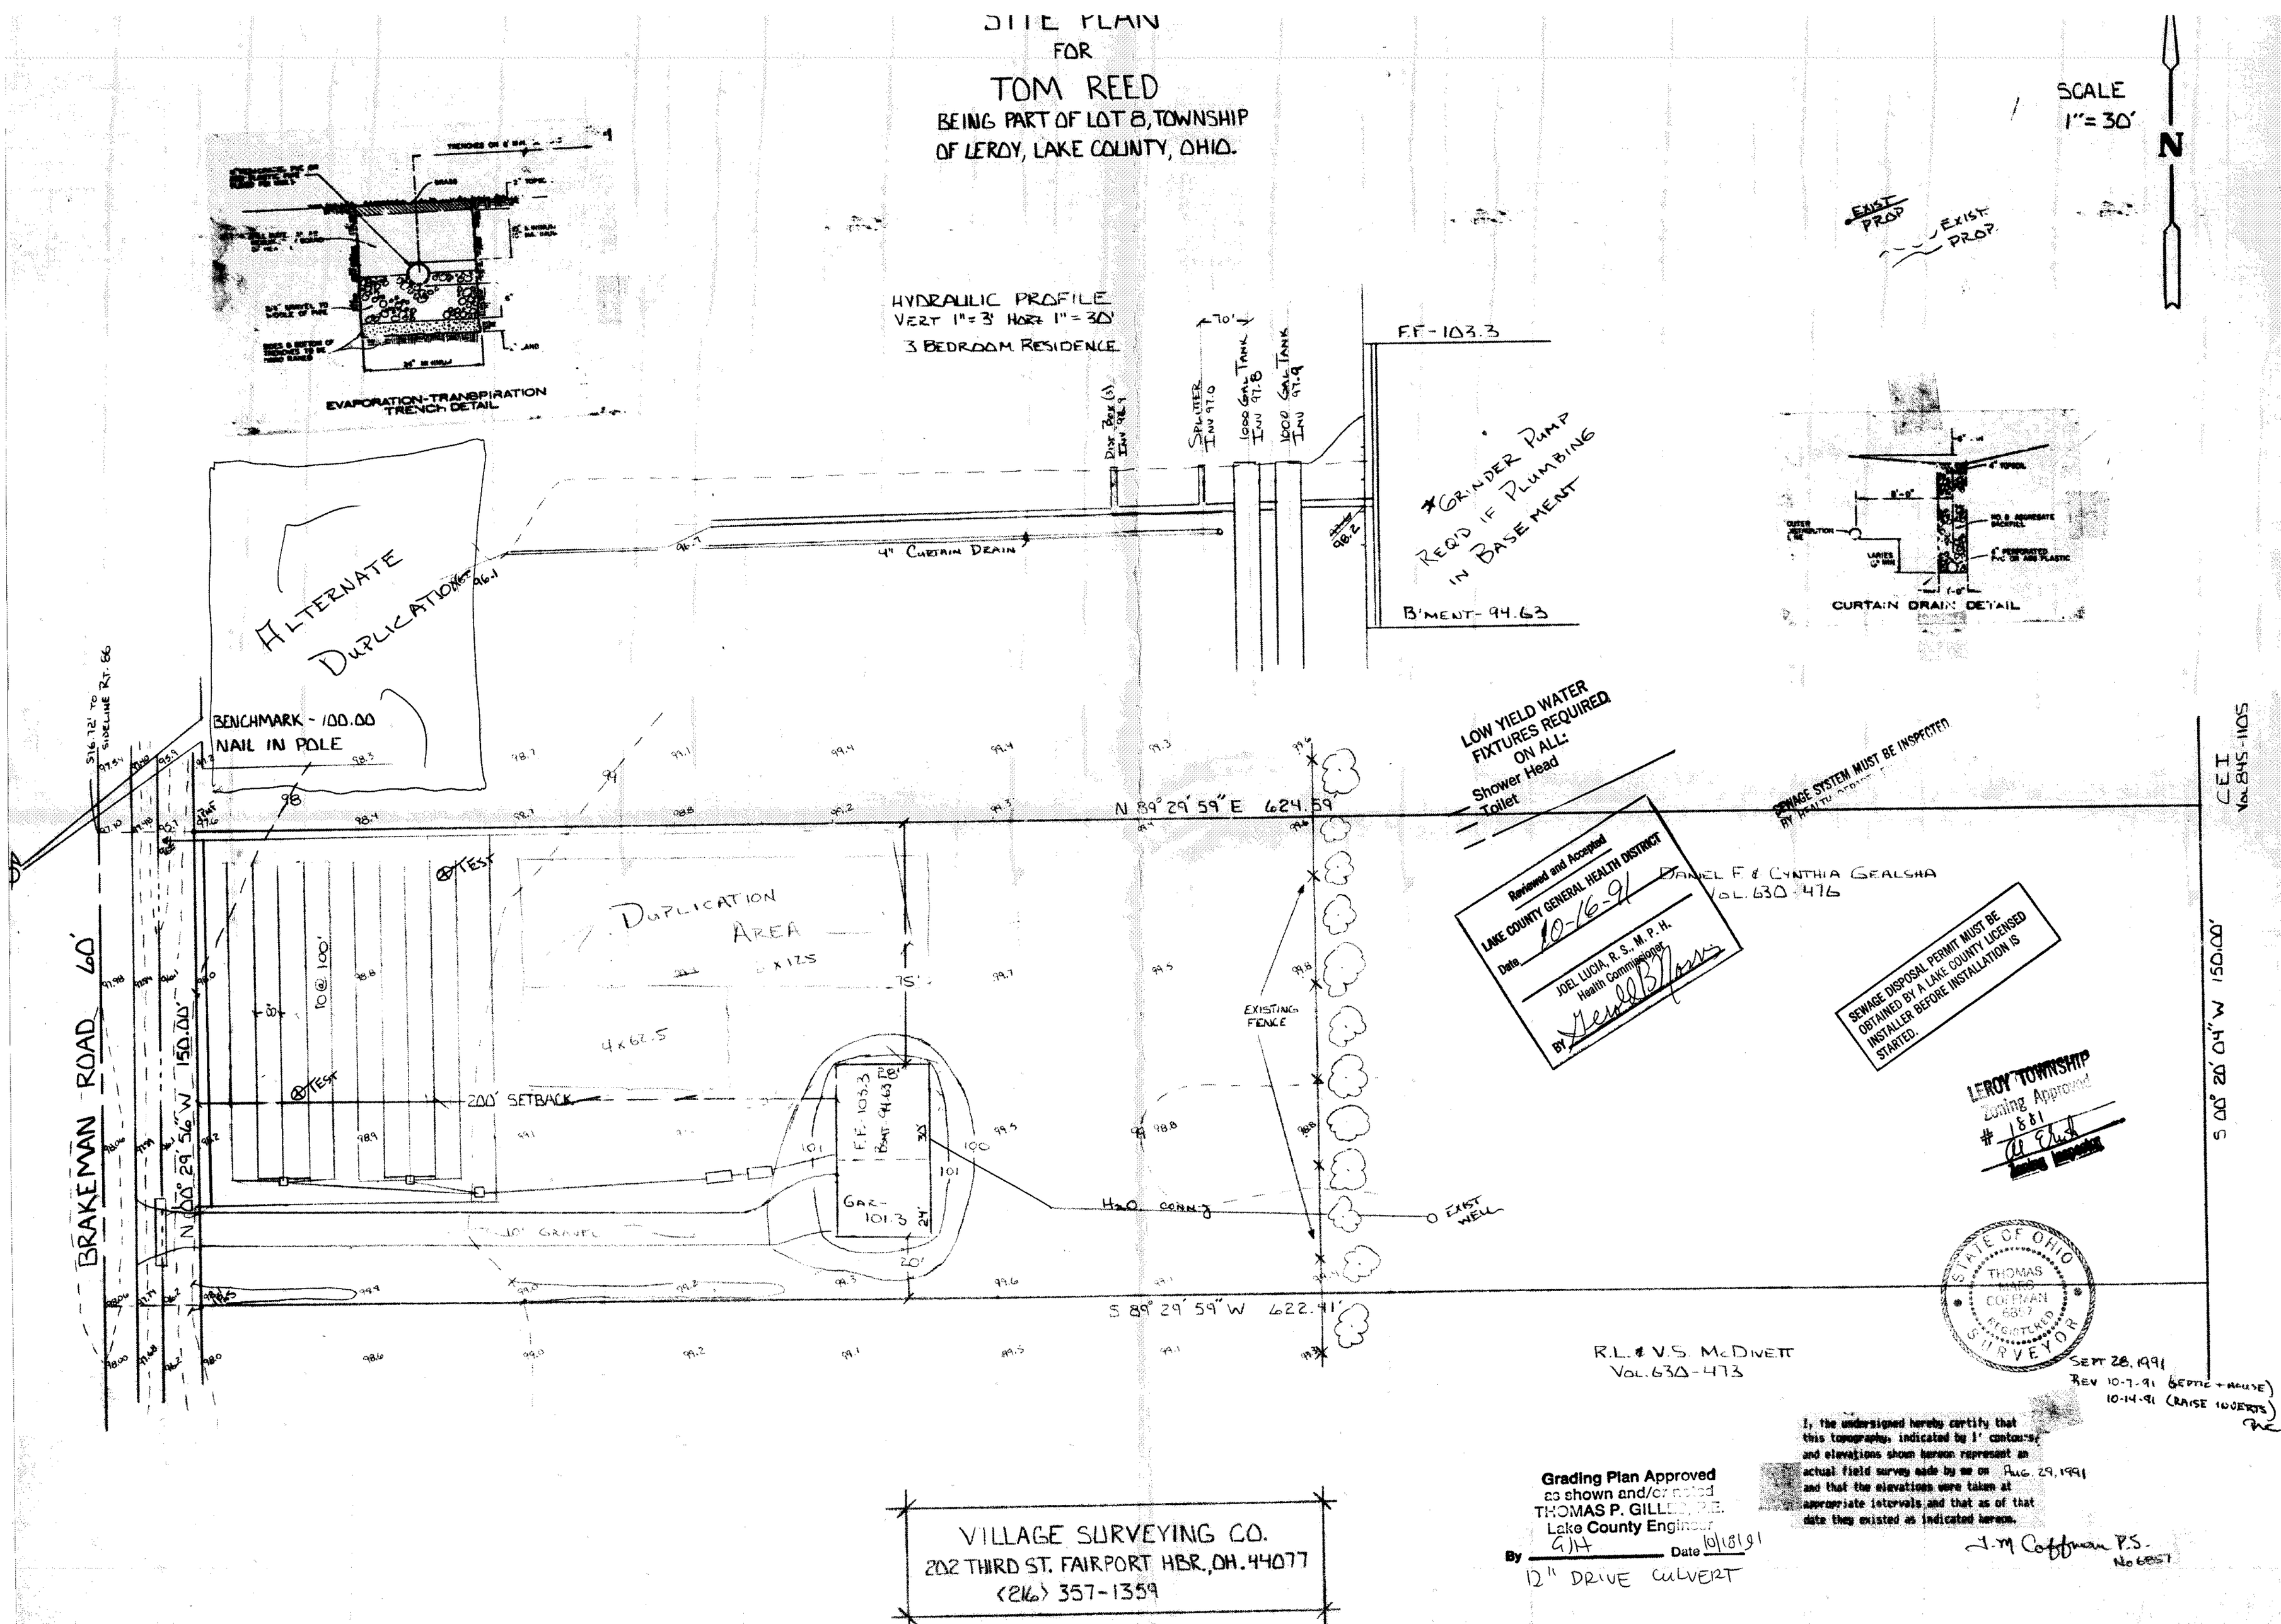
SITE PLAN
FOR
TOM REED
BEING PART OF LOT 8, TOWNSHIP
OF LEROY, LAKE COUNTY, OHIO.
SCALE
1" = 30'
N
EXIST PROP
EXIST PROP
EVAPORATION-TRANSPIRATION TRENCH DETAIL
HYDRAULIC PROFILE
VERT 1" = 3' HORZ 1" = 30'
3 BEDROOM RESIDENCE
70'
DIST BOX (3) INV 98.9
SPLITTER INV 97.0
1000 GAL TANK INV 97.8
1000 GAL TANK INV 97.9
F.F. - 103.3
*GRINDER PUMP REQ'D IF PLUMBING IN BASEMENT
B'MENT - 94.63
4" CURTAIN DRAIN
CURTAIN DRAIN DETAIL
ALTERNATE DUPLICATION
BENCHMARK - 100.00
NAIL IN POLE
LOW YIELD WATER FIXTURES REQUIRED ON ALL:
Shower Head
Toilet
SEWAGE SYSTEM MUST BE INSPECTED BY HEALTH DEPARTMENT
N 89° 29' 59" E 624.59'
DANIEL F. & CYNTHIA GEALSHA
VOL. 630-476
Reviewed and Accepted
LAKE COUNTY GENERAL HEALTH DISTRICT
Date 10-16-91
JOEL LUCIA, R.S., M.P.H.
Health Commissioner
BY
SEWAGE DISPOSAL PERMIT MUST BE OBTAINED BY A LAKE COUNTY LICENSED INSTALLER BEFORE INSTALLATION IS STARTED.
LEROY TOWNSHIP
Zoning Approved
1881
Zoning Inspector
DUPLICATION AREA
6 x 12.5
4 x 62.5
TEST
10 @ 100'
75'
200' SETBACK
F.F. 103.3
BSMT 94.63
GAR - 101.3
EXISTING FENCE
H2O CONN'G
EXIST WELL
10' GRAVEL
BRAKEMAN ROAD 60'
N 00° 29' 56" W 150.00'
S 00° 20' 04" W 150.00'
S 89° 29' 59" W 622.41'
R.L. & V.S. McDIVETT
VOL. 630-473
STATE OF OHIO
THOMAS MARC COFFMAN
6857
REGISTERED
SURVEYOR
SEPT 28, 1991
REV 10-7-91 (SEPTIC + HOUSE)
10-14-91 (RAISE INVERTS)
I, the undersigned hereby certify that this topography, indicated by 1' contours, and elevations shown hereon represent an actual field survey made by me on Aug. 29, 1991 and that the elevations were taken at appropriate intervals and that as of that date they existed as indicated hereon.
J. M. Coffman P.S.
No 6857
Grading Plan Approved
as shown and/or noted
THOMAS P. GILLES, P.E.
Lake County Engineer
By GJH Date 10/18/91
12" DRIVE CULVERT
VILLAGE SURVEYING CO.
202 THIRD ST. FAIRPORT HBR., OH. 44077
(216) 357-1359