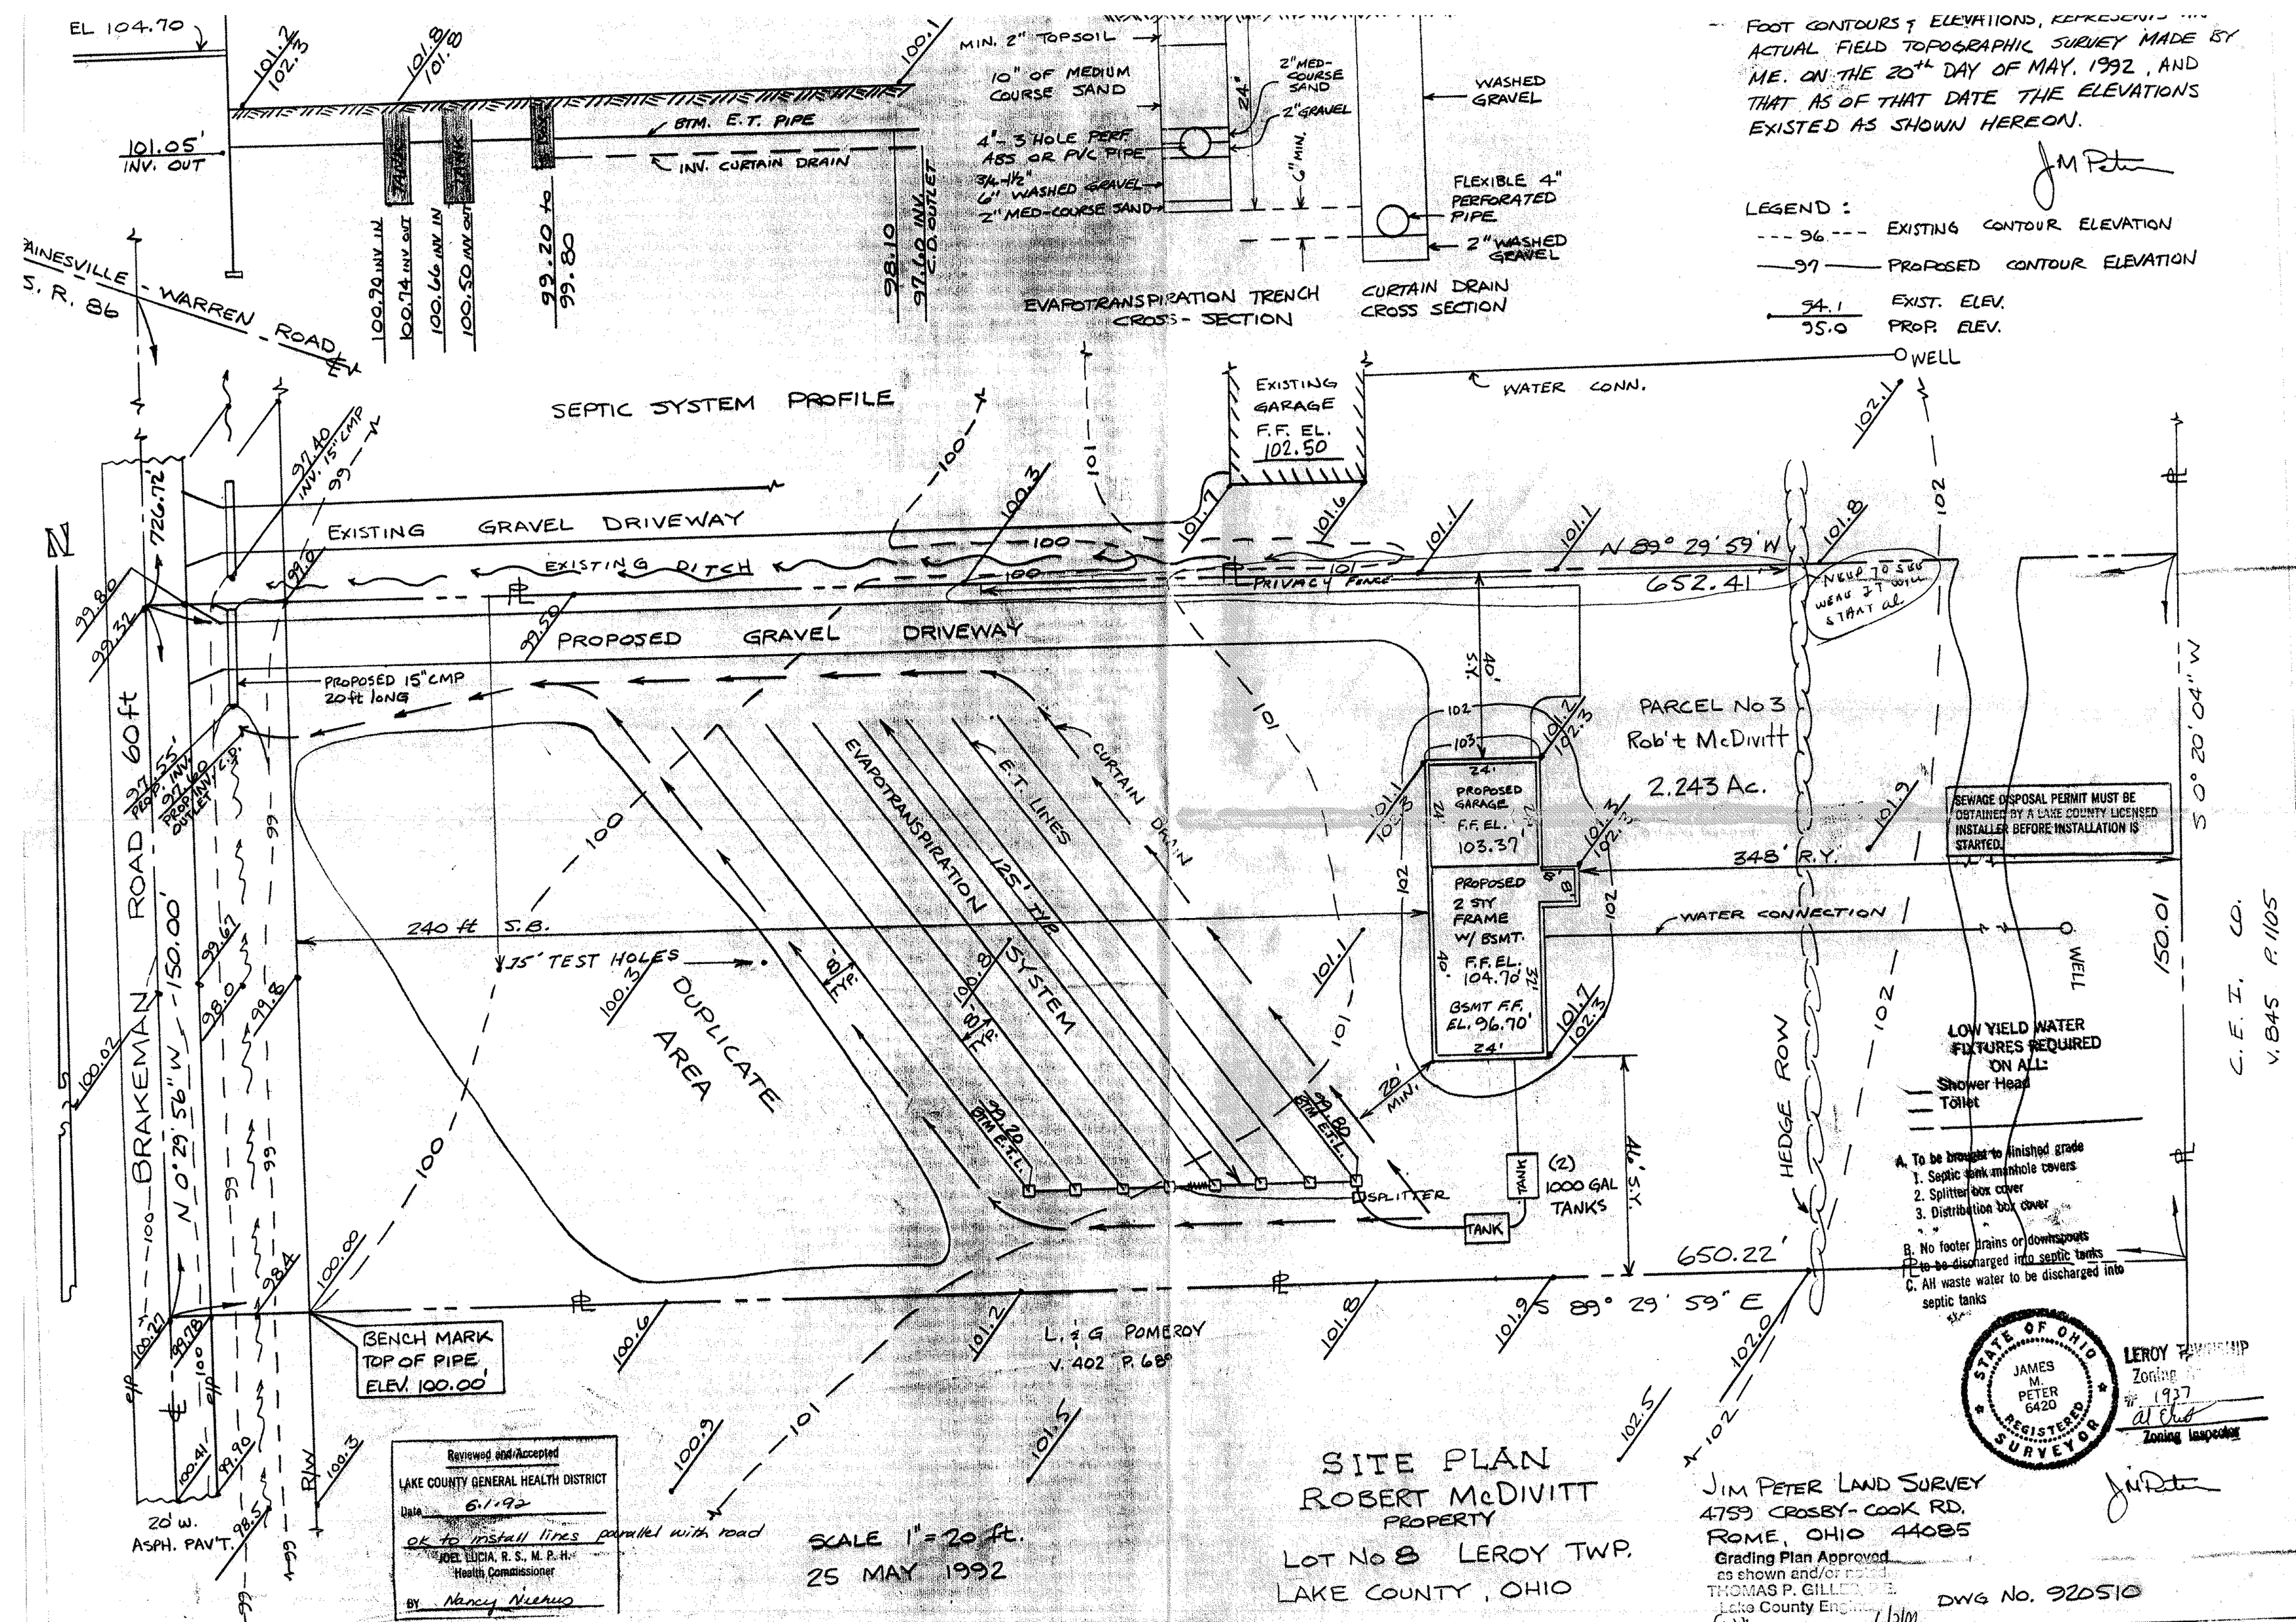

FOOT CONTOURS & ELEVATIONS, REPRESENTS AN ACTUAL FIELD TOPOGRAPHIC SURVEY MADE BY ME. ON THE 20th DAY OF MAY, 1992, AND THAT AS OF THAT DATE THE ELEVATIONS EXISTED AS SHOWN HEREON.
LEGEND:
96 EXISTING CONTOUR ELEVATION
97 PROPOSED CONTOUR ELEVATION
94.1 EXIST. ELEV.
95.0 PROP. ELEV.
EL 104.70
101.05' INV. OUT
BTM. E.T. PIPE
INV. CURTAIN DRAIN
100.90 INV IN
100.74 INV OUT
100.66 INV IN
100.50 INV OUT
99.20 to 99.80
98.10
97.60 INV. C.D. OUTLET
MIN. 2" TOPSOIL
10" OF MEDIUM COURSE SAND
4"-3 HOLE PERF. ABS OR PVC PIPE
3/4-1 1/2" 6" WASHED GRAVEL
2" MED-COURSE SAND
2" MED-COURSE SAND
2" GRAVEL
WASHED GRAVEL
FLEXIBLE 4" PERFORATED PIPE
2" WASHED GRAVEL
EVAPOTRANSPIRATION TRENCH CROSS-SECTION
CURTAIN DRAIN CROSS SECTION
PAINESVILLE - WARREN ROAD
S. R. 86
SEPTIC SYSTEM PROFILE
EXISTING GARAGE F.F. EL. 102.50
WATER CONN.
WELL
EXISTING GRAVEL DRIVEWAY
EXISTING DITCH
PRIVACY FENCE
N 89° 29' 59" W
652.41
NEED TO SEE WERE IT WILL START at
PROPOSED GRAVEL DRIVEWAY
PROPOSED 15" CMP 20 ft long
PARCEL No 3
Rob't McDivitt
2.243 Ac.
PROPOSED GARAGE F.F. EL. 103.37
PROPOSED 2 STY FRAME W/ BSMT. F.F. EL. 104.70
BSMT F.F. EL. 96.70
348' R.Y.
WATER CONNECTION
240 ft S.B.
75' TEST HOLES
DUPLICATE AREA
EVAPOTRANSPIRATION SYSTEM
E.T. LINES
125' TYP.
CURTAIN DRAIN
SPLITTER
TANK
(2) 1000 GAL TANKS
HEDGE ROW
BRAKEMAN ROAD 60 ft
N 0° 29' 56" W
150.00'
150.01
S 0° 20' 04" W
C.E.I. CO.
V. 845 P. 1105
650.22'
S 89° 29' 59" E
BENCH MARK TOP OF PIPE ELEV. 100.00'
L. & G. POMEROY
V. 402 P. 689
20' W. ASPH. PAV'T.
SEWAGE DISPOSAL PERMIT MUST BE OBTAINED BY A LAKE COUNTY LICENSED INSTALLER BEFORE INSTALLATION IS STARTED.
LOW YIELD WATER FIXTURES REQUIRED ON ALL:
Shower Head
Toilet
A. To be brought to finished grade
1. Septic tank manhole covers
2. Splitter box cover
3. Distribution box cover
B. No footer drains or downspouts to be discharged into septic tanks
C. All waste water to be discharged into septic tanks
STATE OF OHIO JAMES M. PETER 6420 REGISTERED SURVEYOR
LEROY TOWNSHIP Zoning
1937
Zoning Inspector
Reviewed and Accepted
LAKE COUNTY GENERAL HEALTH DISTRICT
Date 6.1.92
ok to install lines parallel with road
JOEL LUCIA, R.S., M.P.H.
Health Commissioner
BY Nancy Niehus
SCALE 1" = 20 ft.
25 MAY 1992
SITE PLAN
ROBERT McDIVITT PROPERTY
LOT No 8 LEROY TWP.
LAKE COUNTY, OHIO
JIM PETER LAND SURVEY
4759 CROSBY-COOK RD.
ROME, OHIO 44085
Grading Plan Approved as shown and/or noted
THOMAS P. GILLES, P.E.
Lake County Engineer
DWG No. 920510