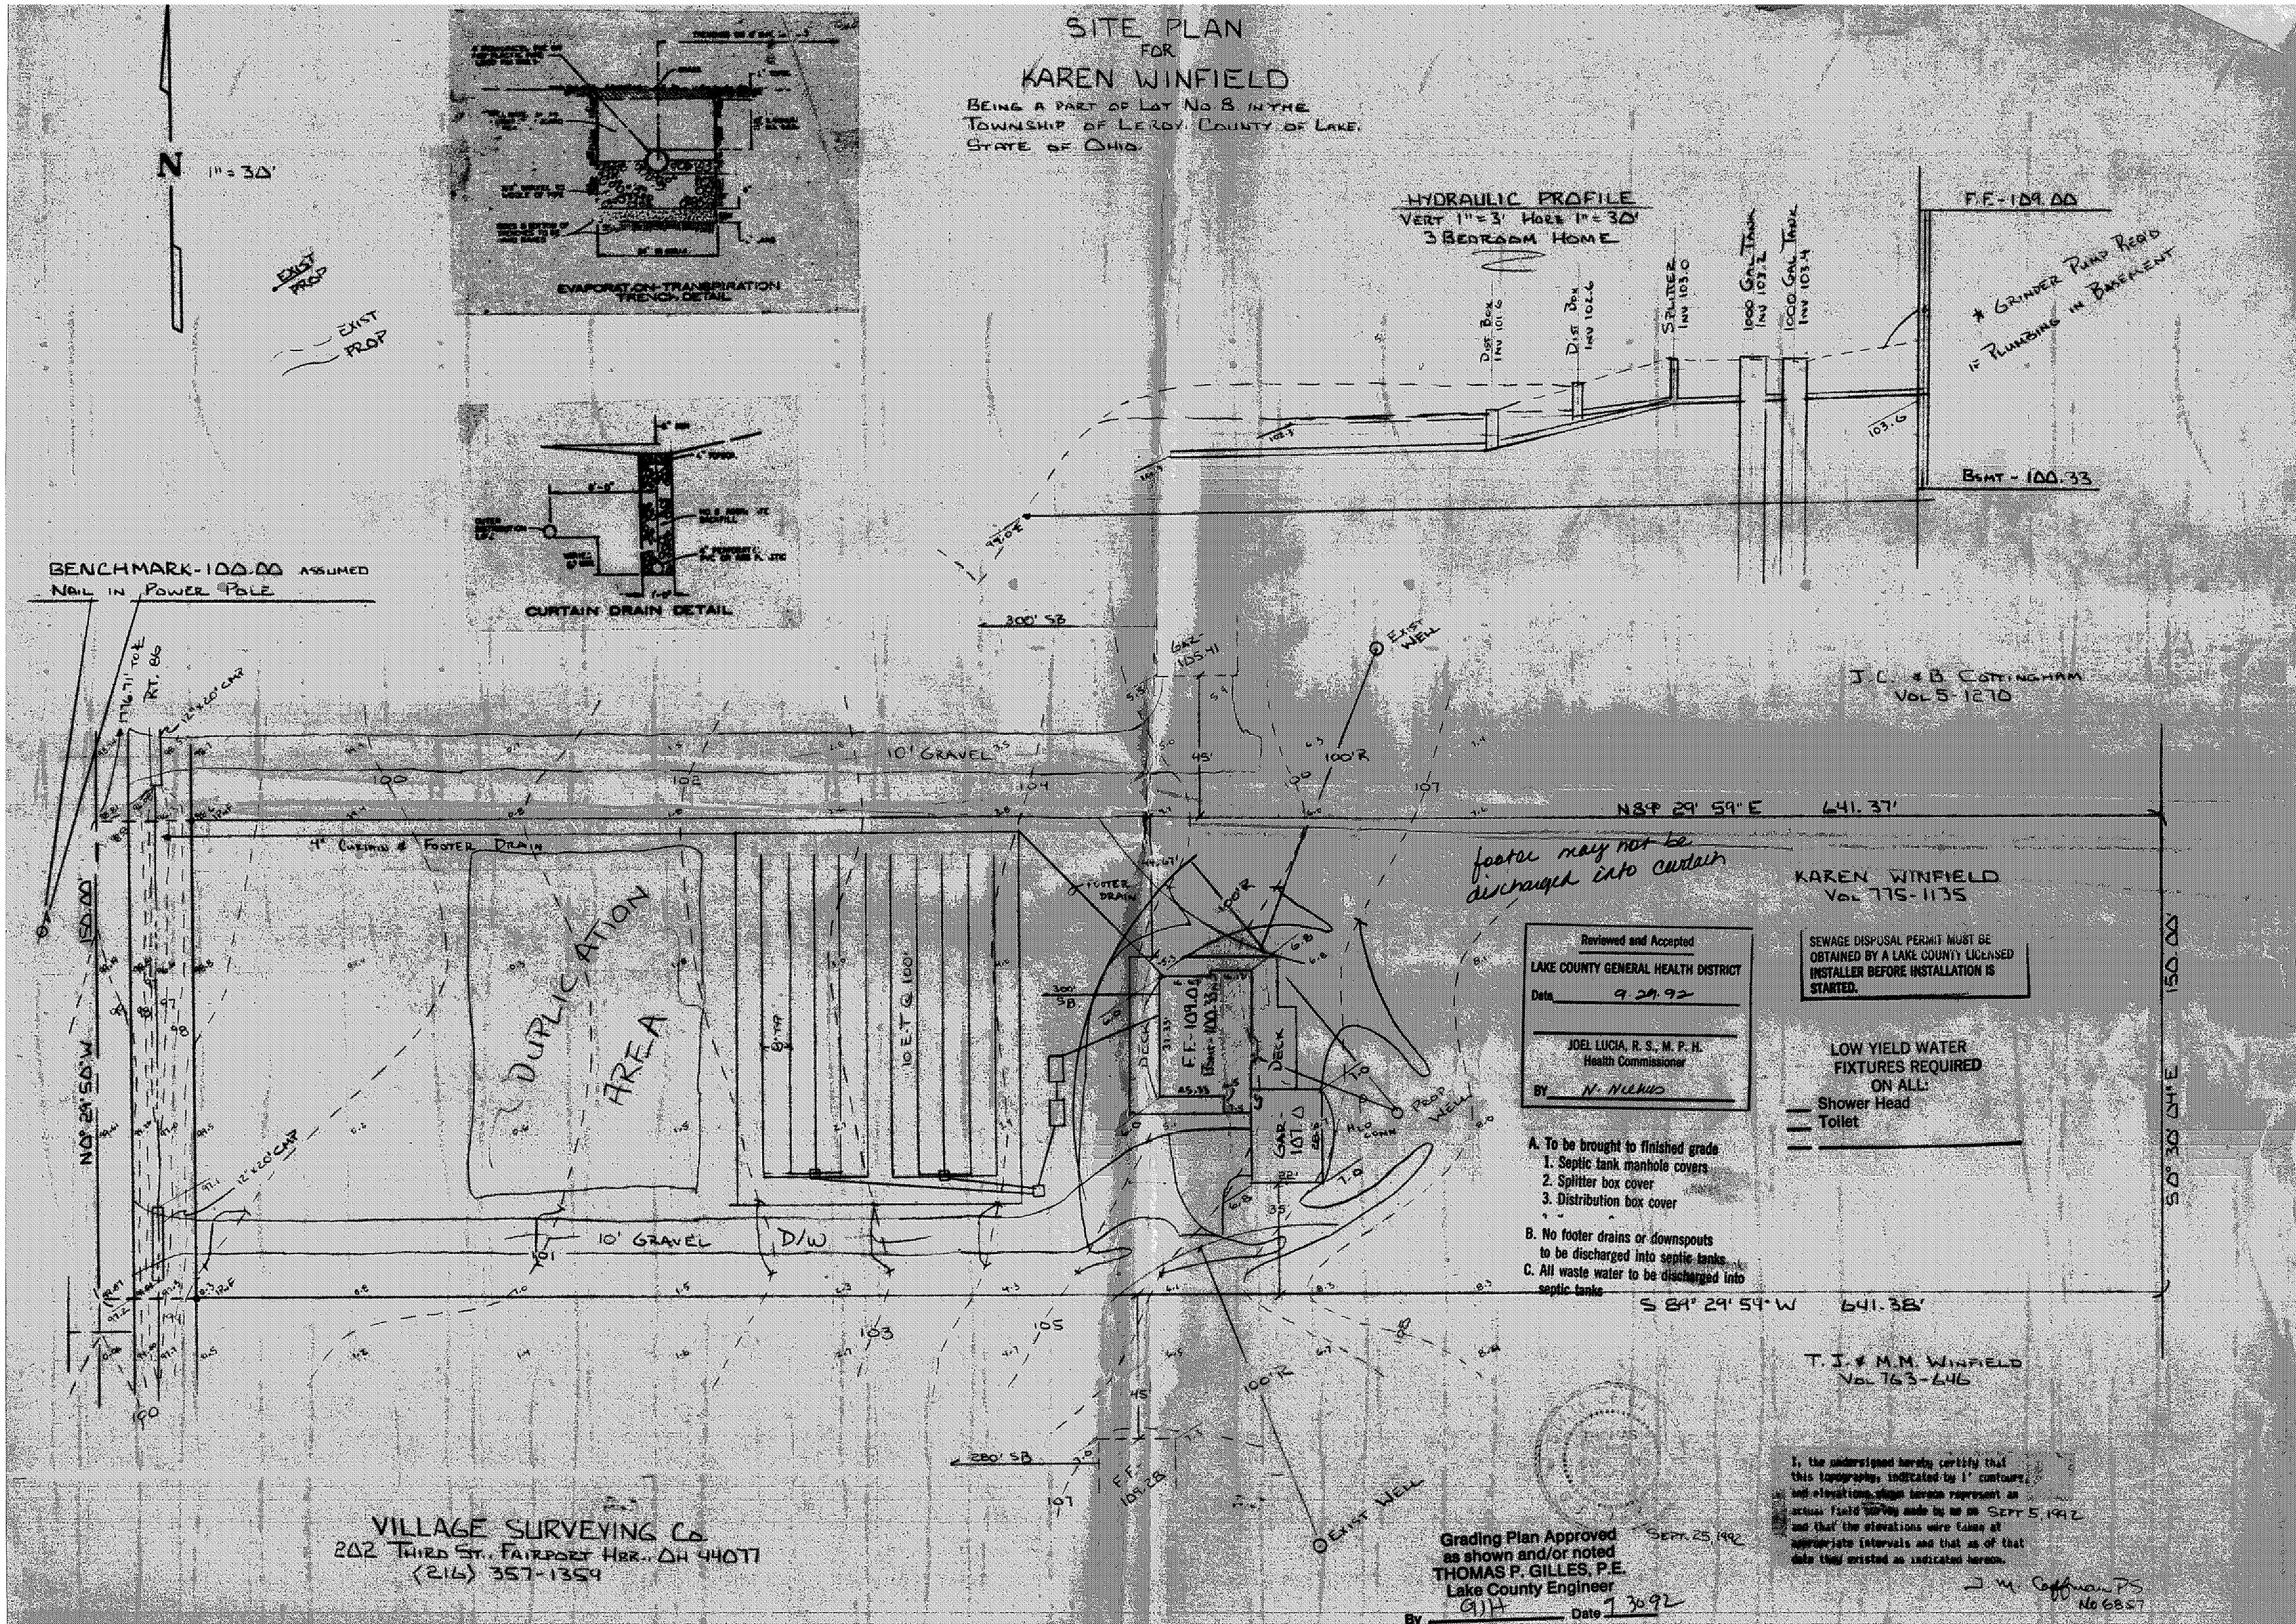
SITE PLAN
FOR
KAREN WINFIELD
BEING A PART OF LOT NO 8 IN THE TOWNSHIP OF LEROY, COUNTY OF LAKE, STATE OF OHIO
N
1" = 30'
EXIST PROP
EXIST PROP
EVAPORATION-TRANSPIRATION TRENCH DETAIL
CURTAIN DRAIN DETAIL
HYDRAULIC PROFILE
VERT 1" = 3' HORZ 1" = 30'
3 BEDROOM HOME
DIST BOX INV 101.6
DIST BOX INV 102.6
SPLITTER INV 103.0
1000 GAL TANK INV 103.2
1000 GAL TANK INV 103.4
F.F. - 109.00
* GRINDER PUMP REQ'D IF PLUMBING IN BASEMENT
BSMT - 100.33
BENCHMARK - 100.00 ASSUMED NAIL IN POWER POLE
300' SB
EXIST WELL
J.C. & B. COTTINGHAM
VOL 5-1270
10' GRAVEL
N89° 29' 59" E 641.37'
4" CURTAIN & FOOTER DRAIN
DUPLICATION AREA
FOOTER DRAIN
10 E.T. @ 100'
DECK
F.F. - 109.05
BSMT - 100.33
GAR - 107.0
PROP WELL
10' GRAVEL
D/W
N0° 29' 50" W
150.00'
S0° 30' 04" E
150.00'
S 89° 29' 59" W 641.38'
KAREN WINFIELD
VOL 775-1135
footer may not be discharged into curtain
Reviewed and Accepted
LAKE COUNTY GENERAL HEALTH DISTRICT
Date 9.29.92
JOEL LUCIA, R. S., M. P. H.
Health Commissioner
BY N. Nichols
SEWAGE DISPOSAL PERMIT MUST BE OBTAINED BY A LAKE COUNTY LICENSED INSTALLER BEFORE INSTALLATION IS STARTED.
LOW YIELD WATER FIXTURES REQUIRED ON ALL:
Shower Head
Toilet
A. To be brought to finished grade
1. Septic tank manhole covers
2. Splitter box cover
3. Distribution box cover
B. No footer drains or downspouts to be discharged into septic tanks
C. All waste water to be discharged into septic tanks
T. J. & M.M. WINFIELD
VOL 763-646
280' SB
EXIST WELL
VILLAGE SURVEYING CO.
202 THIRD ST., FAIRPORT HBR., OH 44077
(216) 357-1359
Grading Plan Approved as shown and/or noted
THOMAS P. GILLES, P.E.
Lake County Engineer
By GJH Date 7 30 92
SEPT. 25, 1992
I, the undersigned hereby certify that this topography, indicated by 1' contours, and elevations shown hereon represent an actual field survey made by me on SEPT 5, 1992 and that the elevations were taken at appropriate intervals and that as of that date they existed as indicated hereon.
J. M. Coffman PS
No 6857