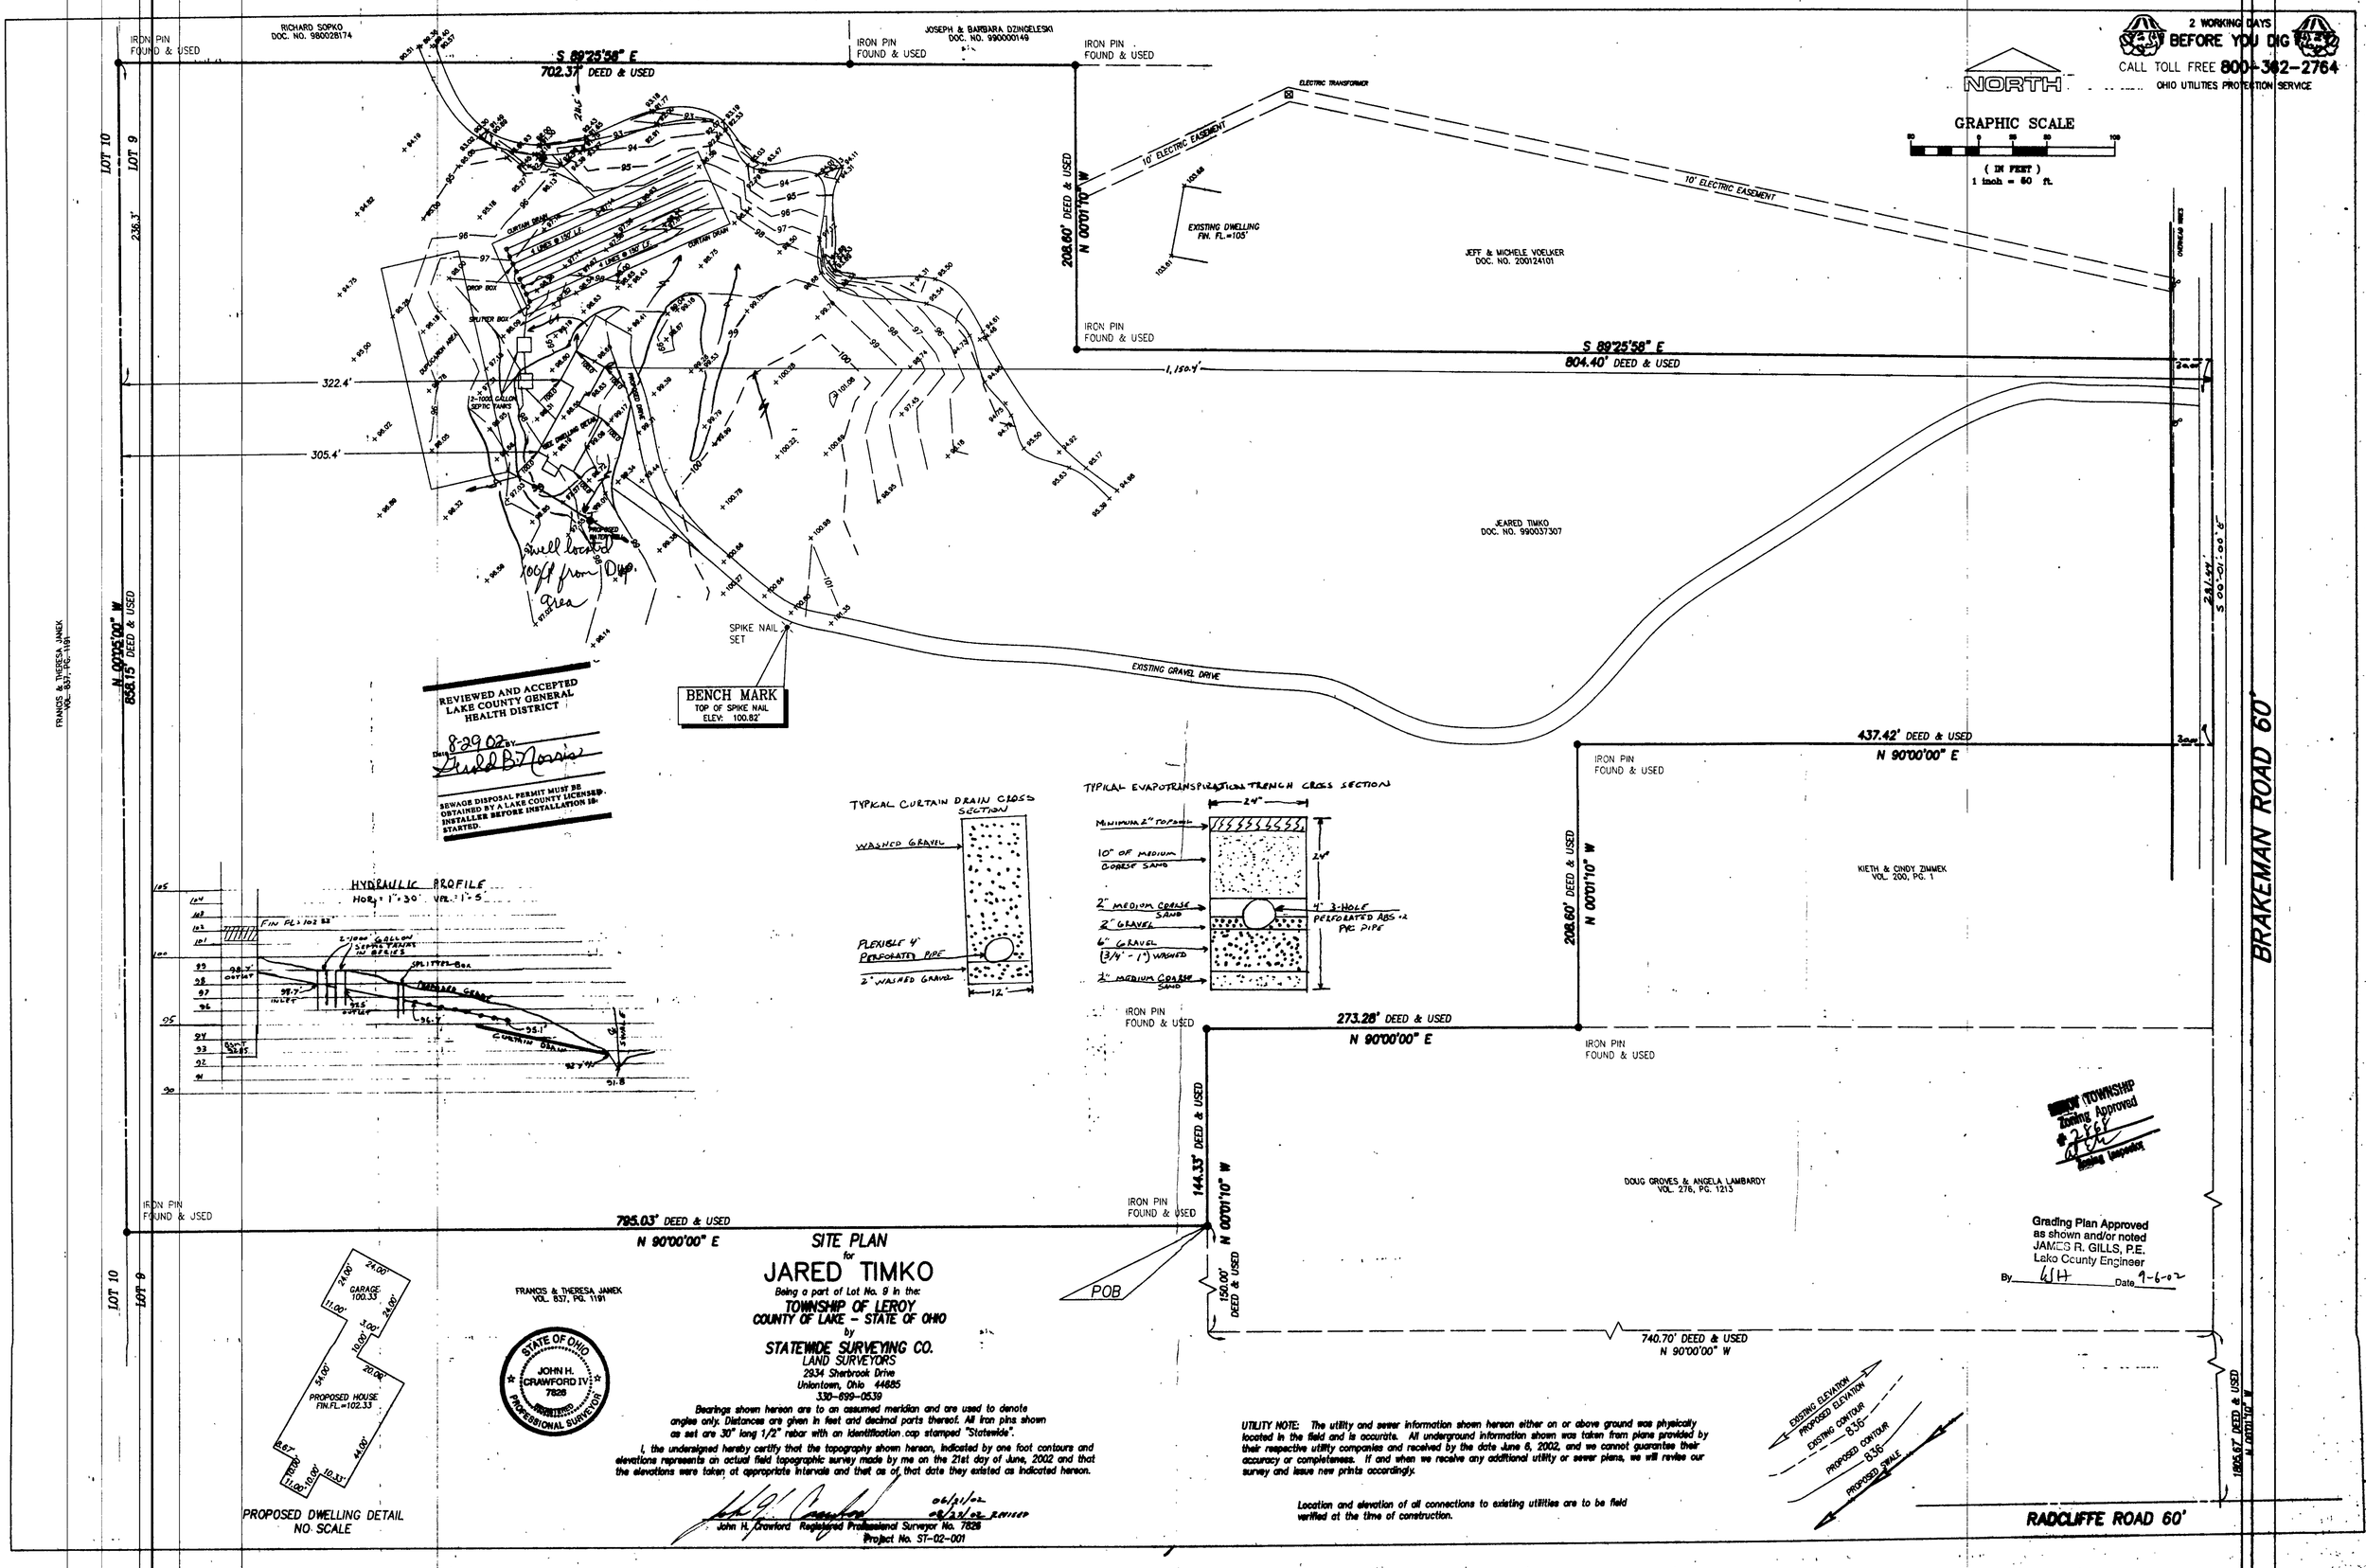

SITE PLAN
for
JARED TIMKO

Being a part of Lot No. 9 in the:
TOWNSHIP OF LEROY
COUNTY OF LAKE - STATE OF OHIO
by
STATEWIDE SURVEYING CO.
LAND SURVEYORS
2934 Sherbrook Drive
Uniontown, Ohio 44685
330-699-0539

Bearings shown hereon are to an assumed meridian and are used to denote angles only. Distances are given in feet and decimal parts thereof. All iron pins shown as set are 30" long 1/2" rebar with an identification cap stamped "Statewide".

I, the undersigned hereby certify that the topography shown hereon, indicated by one foot contours and elevations represents an actual field topographic survey made by me on the 21st day of June, 2002 and that the elevations were taken at appropriate intervals and that as of that date they existed as indicated hereon.

06/21/02
08/23/02 REVISED
John H. Crawford Registered Professional Surveyor No. 7826
Project No. ST-02-001

UTILITY NOTE: The utility and sewer information shown hereon either on or above ground was physically located in the field and is accurate. All underground information shown was taken from plans provided by their respective utility companies and received by the date June 6, 2002, and we cannot guarantee their accuracy or completeness. If and when we receive any additional utility or sewer plans, we will revise our survey and issue new prints accordingly.

Location and elevation of all connections to existing utilities are to be field verified at the time of construction.