SITE PLAN
FOR
TRIPLE "E" CO.

Being part of original Leroy Township Lot No. 12 in the County of Lake and State of Ohio
Scale 1"=30' March, 1981

Richard O. Mackay
Registered Ohio Surveyor No. 4105
SLABE & MACKAY
CIVIL ENGINEERS & SURVEYORS

NOTE:
Parcel location & survey provided by owner

STATE OF OHIO — RICHARD O. MACKAY — 4105 — REGISTERED PROFESSIONAL SURVEYOR

Grading Plan Approved
as shown and/or noted
THOMAS P. GILLES, P.E.
Lake County Engineer
By _____ Date 4-23-81

Existing Grades / Finish Grades — TYPICAL

EXISTING CONTOUR
FINISH CONTOUR
SURFACE FLOW

LEROY TOWNSHIP
Zoning Approved
Zoning Inspector
4/28/81 #262

EVAPORATION-TRANSPIRATION TREN

NOTES

1. Alternate flow from Section I to Section II annually.
2. Minimum fall of 1" from inlet to outlet lines.
3. Twenty foot minimum distance from Septic Tanks to Ho
4. Clean sand .4 to 1MM in size, uniform coefficient no to exceed 4.
5. Sewage disposal system & structures to be in accordance with Detail and Specifications of the Lake County General Health District

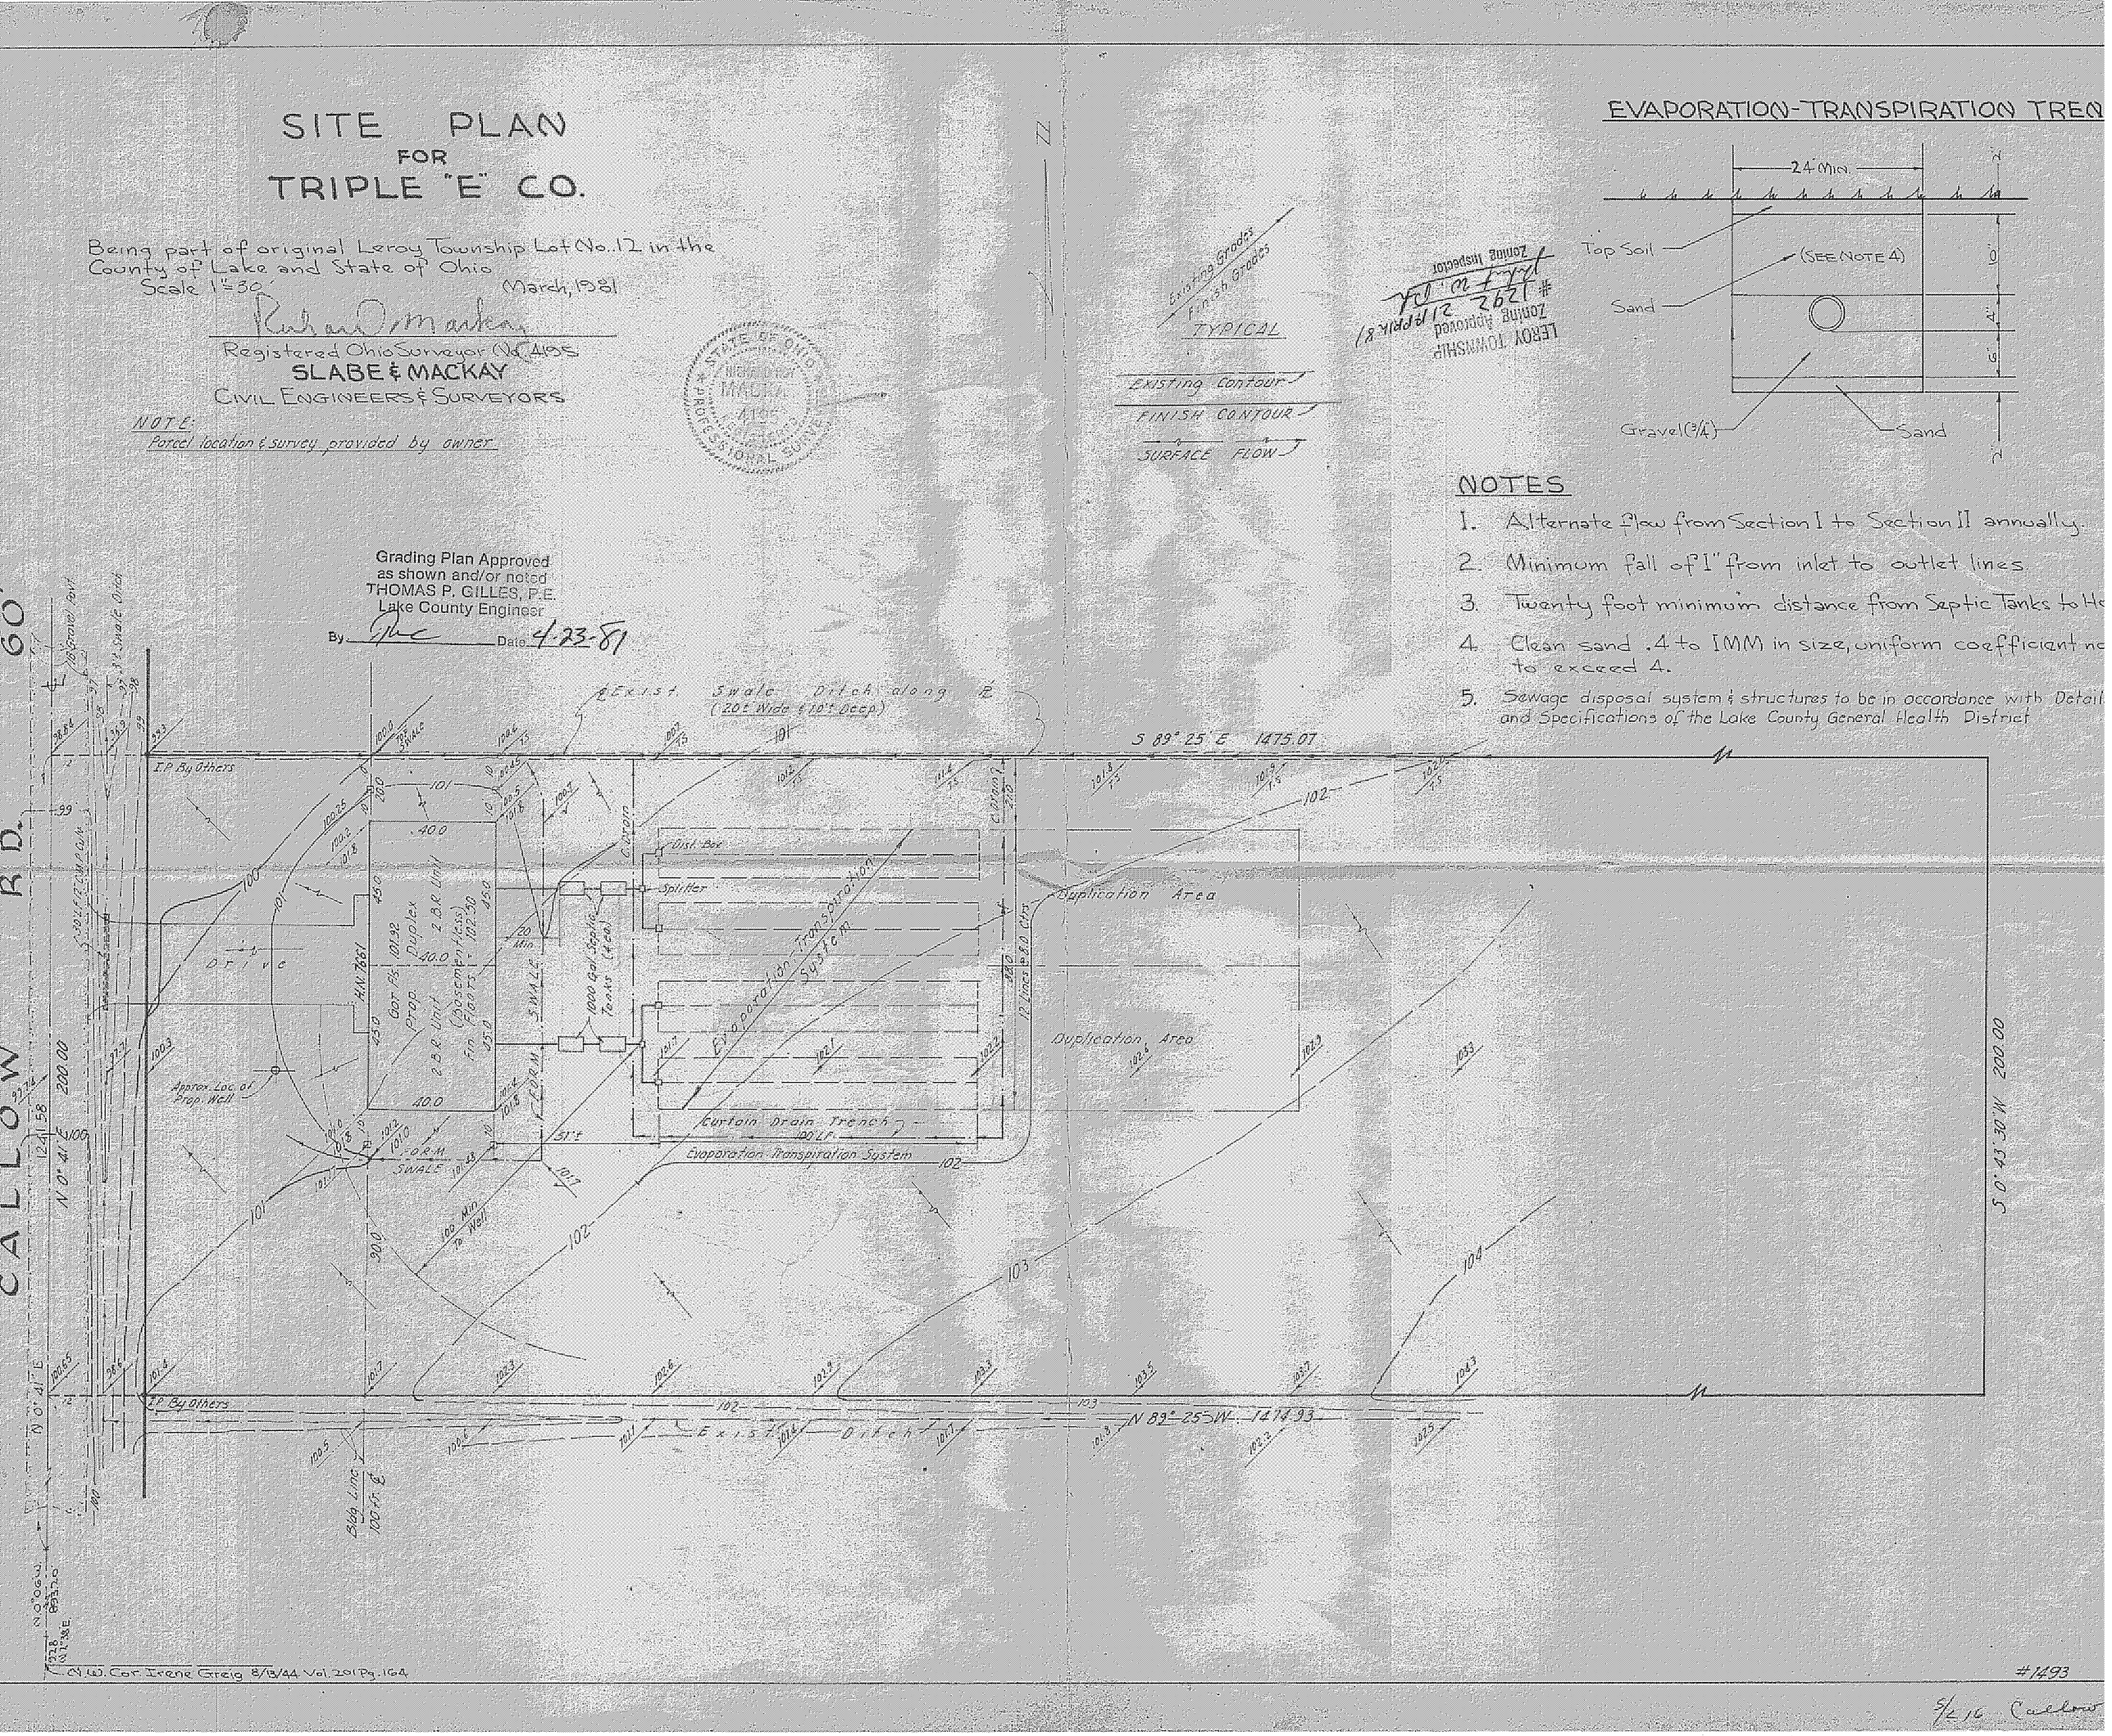

5/16 Carlson