Site Plan
FOR
David & Roberta Tycast

BEING PARCELS No. 12 & 13 IN THE GLENHAVEN DEVELOPMENT SUBDIVISION OF PART OF LOT 13 AS RECORDED IN VOLUME L – PAGE 39 OF THE LAKE COUNTY PLAT OF RECORDS, IN THE TOWNSHIP OF LEROY, COUNTY OF LAKE, STATE OF OHIO.

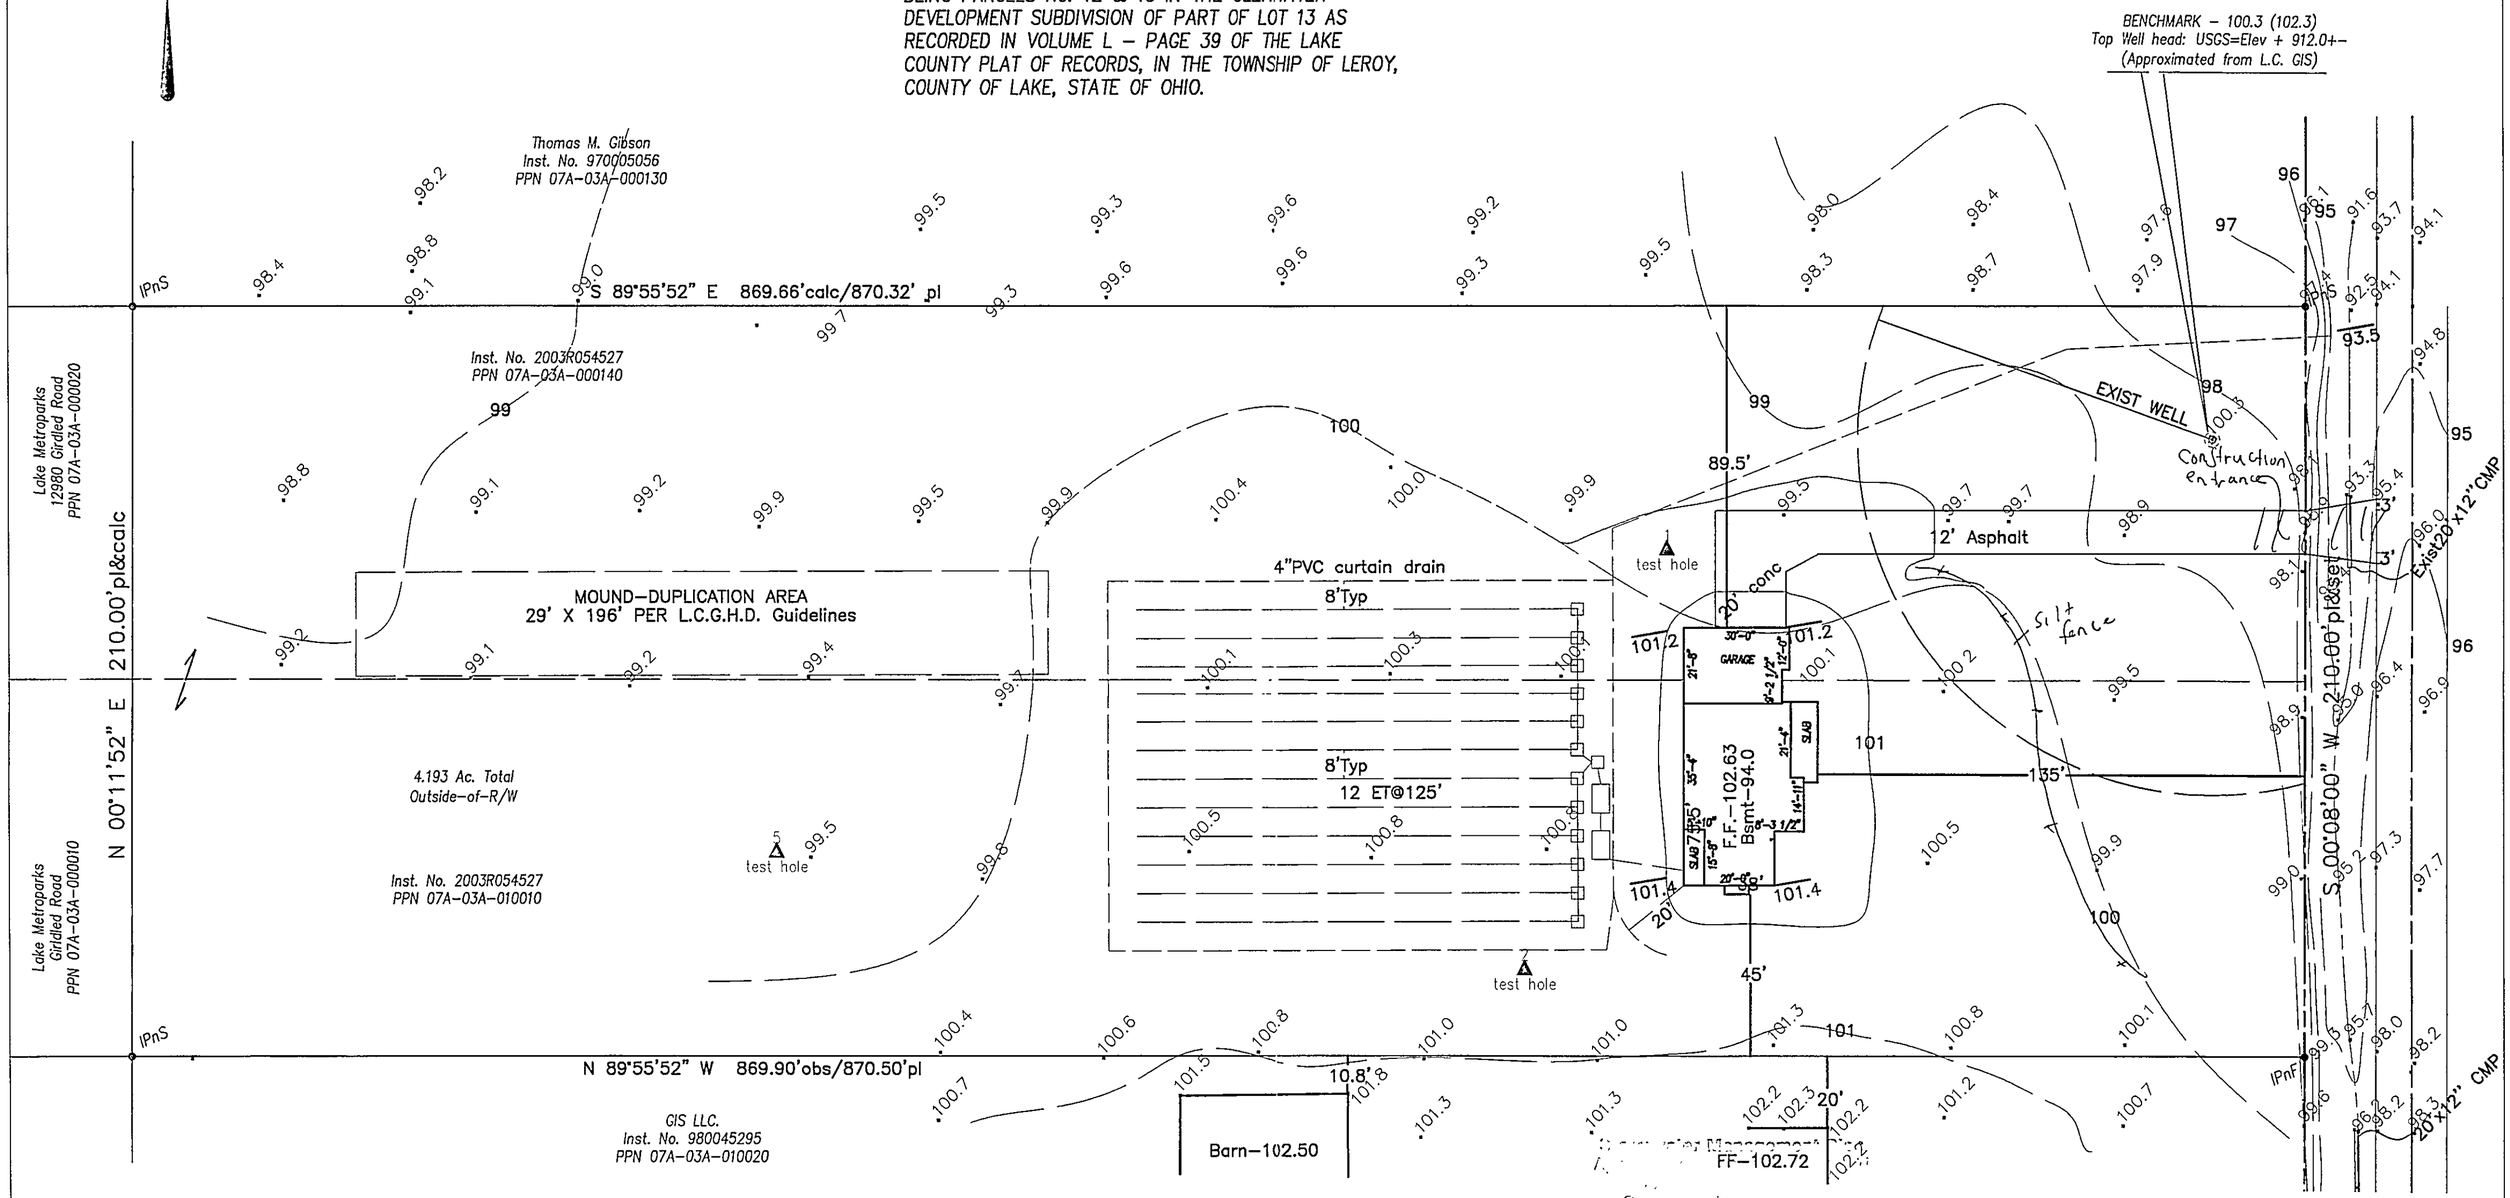

HYDRAULIC PROFILE
VERT– 1"= 5' HORZ – 1" = 30'

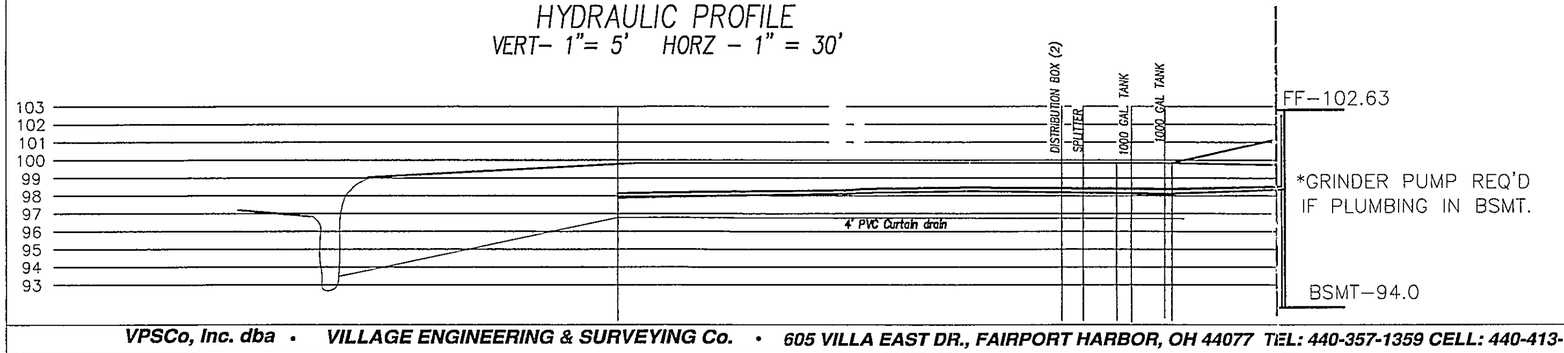

By GJH 72204
See attached notes.

ROOF DRAINS SHALL DISCHARGE TO SPLASH BLOCKS.

This project is exempt from ESC Plan Review
Date 7-21-04
Lake SWCD
PJP

I, the undersigned hereby certify that the boundary survey represented by this plat and that all monumentation set has been done in accordance with the specifications set forth in Chapter 4733–37 of the Ohio Administrative Code.

I, further certify that the topography, indicated by 1 foot contours and elevations shown hereon represent an actual field survey made by me on July 13, 2004 and the elevations were taken at the appropriate intervals and that as of that date they existed as indicated hereon.

STATE OF OHIO THOMAS MARC COFFMAN S-6857 PROFESSIONAL SURVEYOR

THOMAS M. COFFMAN P.S., DATE
REGISTERED SURVEYOR No. 6857
STATE OF OHIO

July 20, 2004

1/2

VPSCo, Inc. dba • VILLAGE ENGINEERING & SURVEYING Co. • 605 VILLA EAST DR., FAIRPORT HARBOR, OH 44077 TEL: 440-357-1359 CELL: 440-413-0527