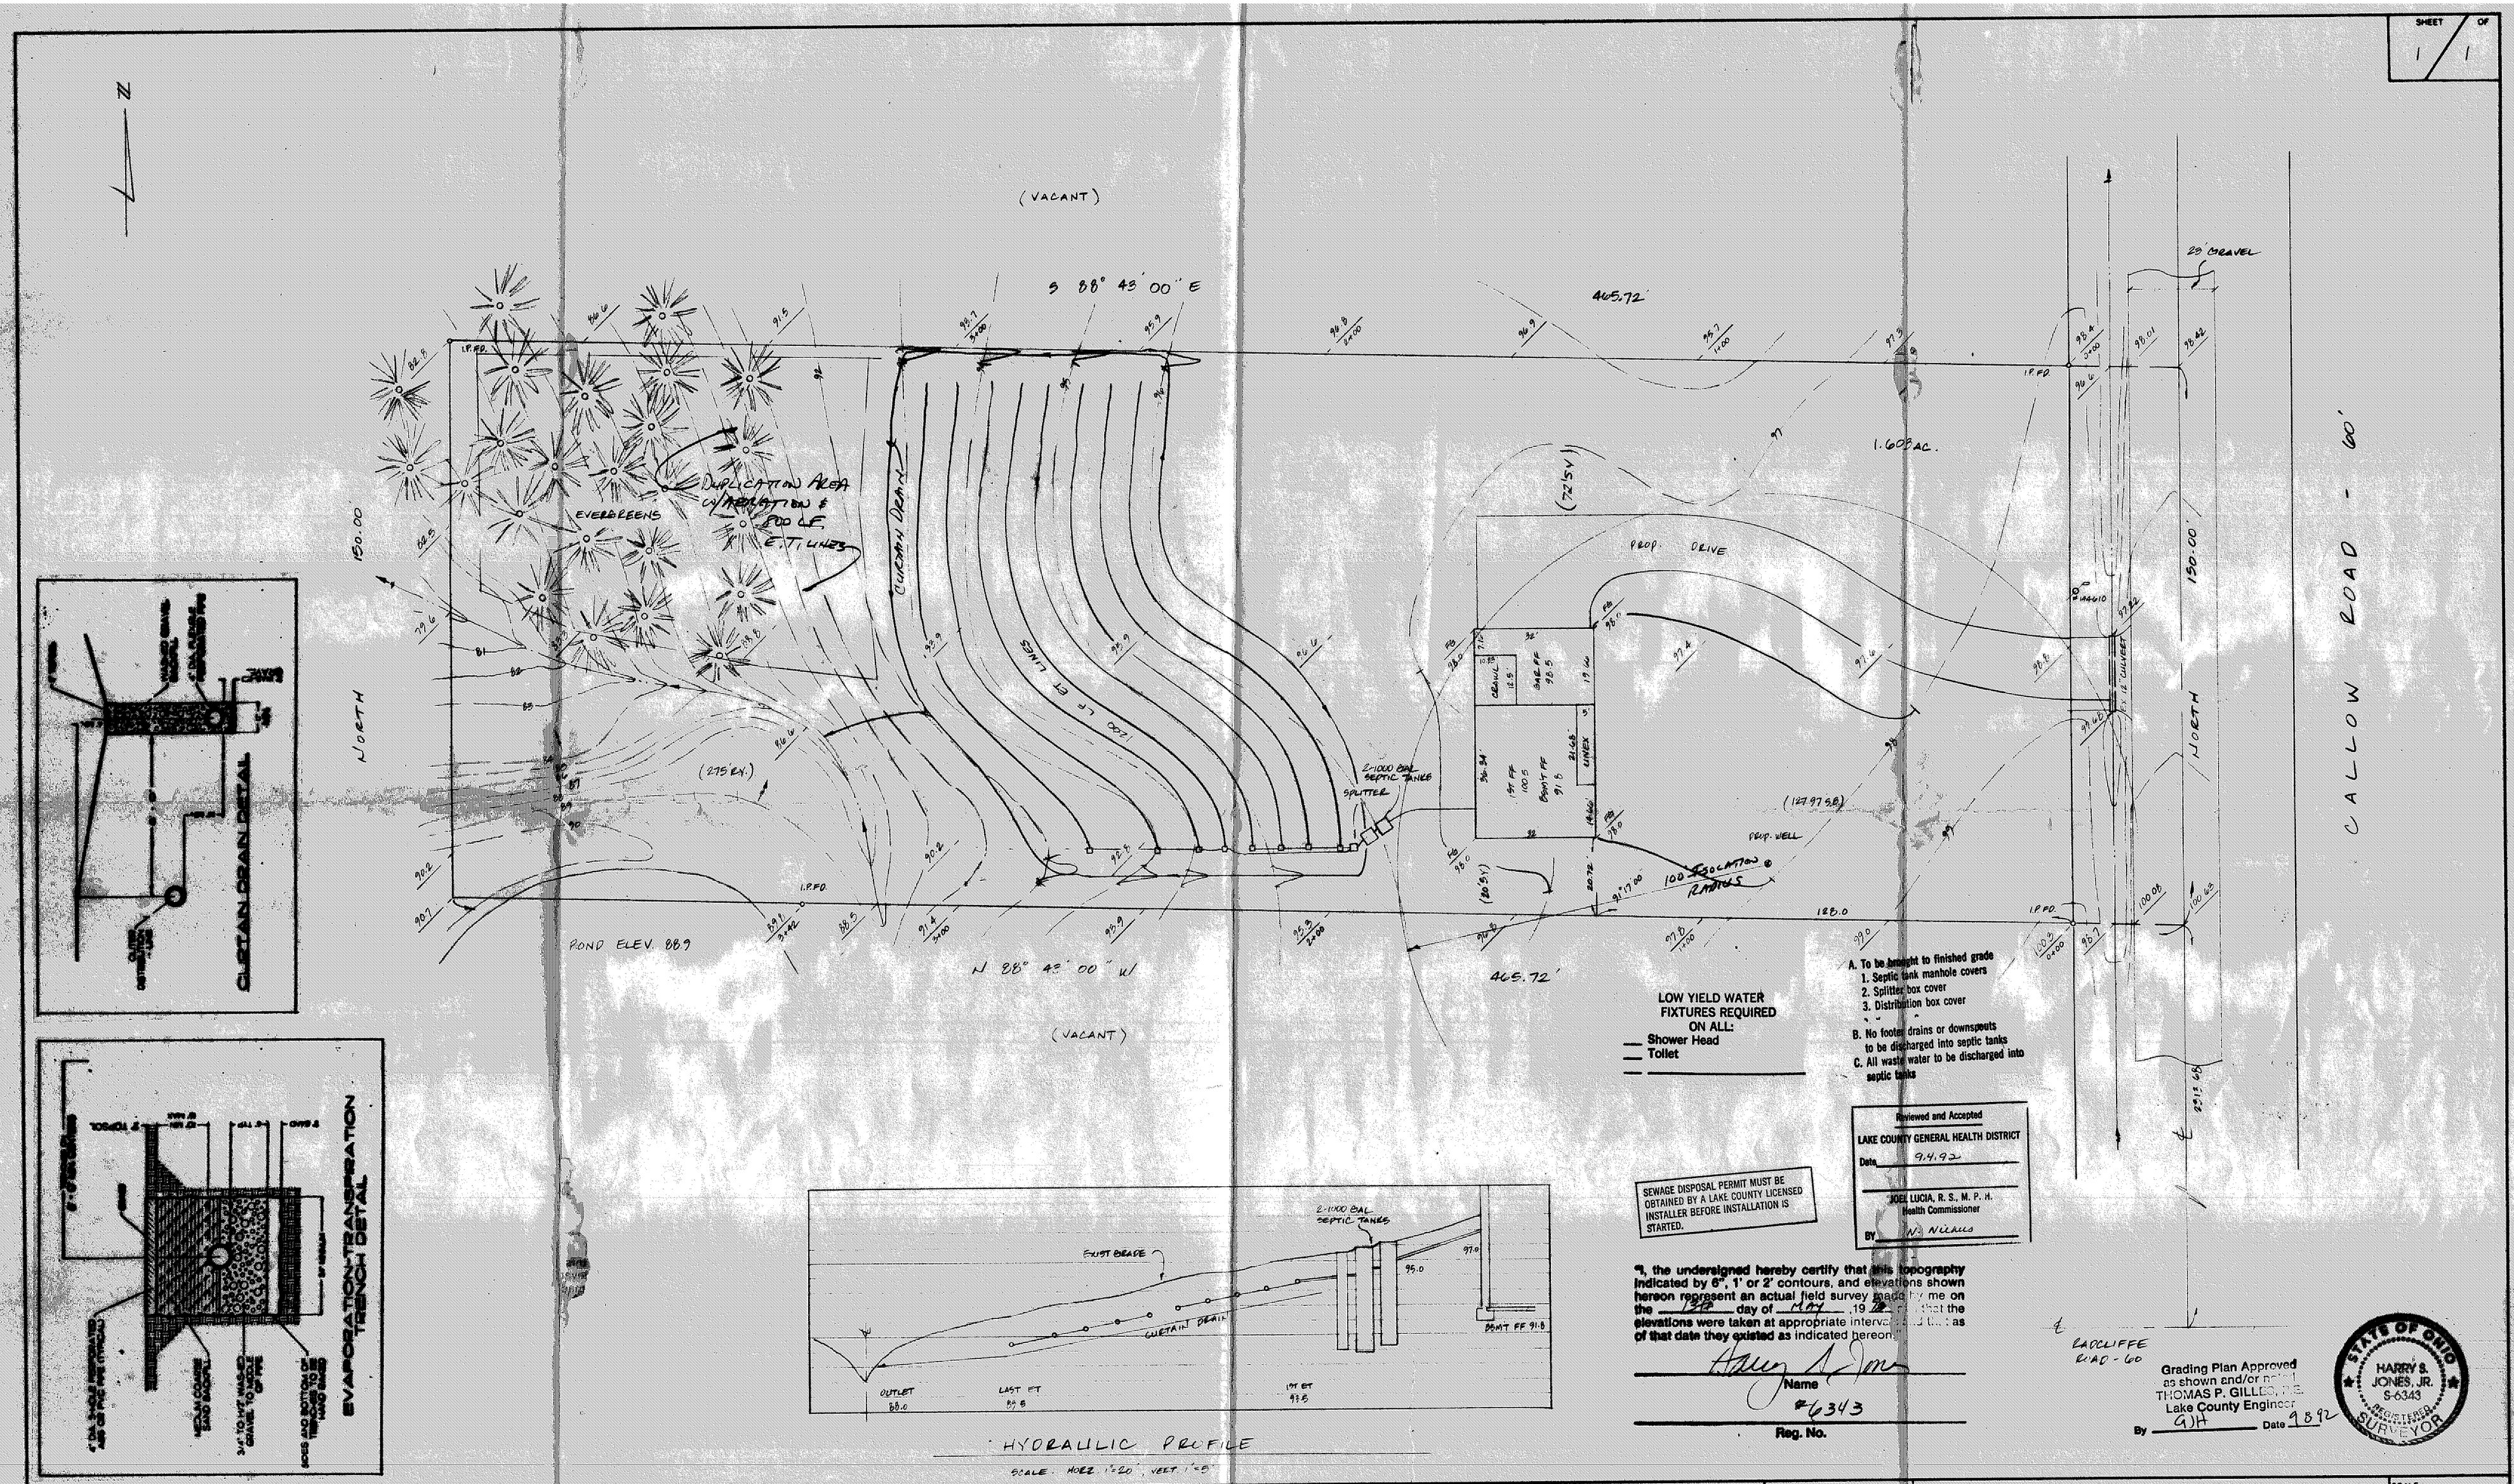

LOW YIELD WATER FIXTURES REQUIRED ON ALL:
- Shower Head
- Toilet

A. To be brought to finished grade
1. Septic tank manhole covers
2. Splitter box cover
3. Distribution box cover

B. No footer drains or downspouts to be discharged into septic tanks

C. All waste water to be discharged into septic tanks

Reviewed and Accepted
LAKE COUNTY GENERAL HEALTH DISTRICT
Date 9.4.92
JOEL LUCIA, R. S., M. P. H.
Health Commissioner
BY N. Nicholls

SEWAGE DISPOSAL PERMIT MUST BE OBTAINED BY A LAKE COUNTY LICENSED INSTALLER BEFORE INSTALLATION IS STARTED.

"I, the undersigned hereby certify that this topography indicated by 6", 1' or 2' contours, and elevations shown hereon represent an actual field survey made by me on the 13th day of May, 1992 and that the elevations were taken at appropriate intervals and that as of that date they existed as indicated hereon."

Harry S. Jones
Name
#6343
Reg. No.

Grading Plan Approved as shown and/or noted
THOMAS P. GILLES, P.E.
Lake County Engineer
By GJH Date 9.8.92

STATE OF OHIO
HARRY S. JONES, JR.
S-6343
REGISTERED SURVEYOR

REV NO.	DESCRIPTION	DATE	BY	CHK'D
1	REVISED E.T. FIELD & REPLACEMENT AREA	9-3-92	HT	HT

SITE PLAN FOR DAVID & SANDRA ORTIZ

BABCOCK, JONES AND ASSOCIATES, INC
CIVIL ENGINEERS - SURVEYORS - LAND PLANNERS
PAINESVILLE OHIO 44077

DATE 5-14-92
DESIGN BY DE
DRAWN BY DE
APPROVED BY HT

OUT OF PERM. PARCEL # 7A-3E-10
CALLOW ROAD
LEROY TOWNSHIP - LAKE COUNTY - STATE OF OHIO

SCALE 1"=20'
JOB NO 92-029
SHEET 1 OF 1