HUNTOON ROAD - 60'

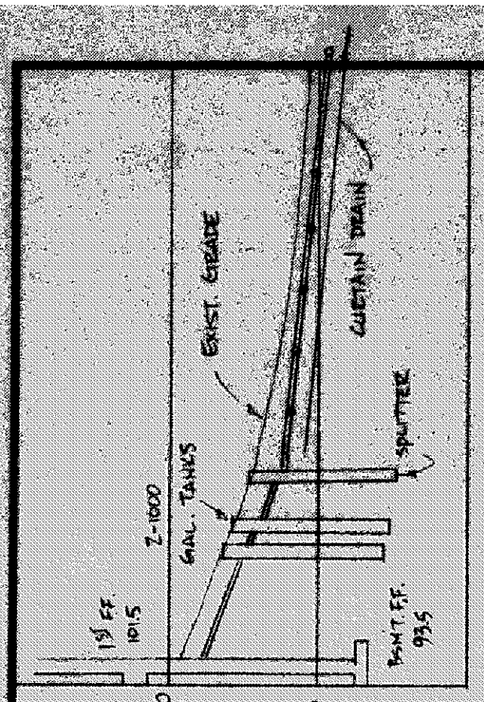

 

HUNTOON ROAD - 60'

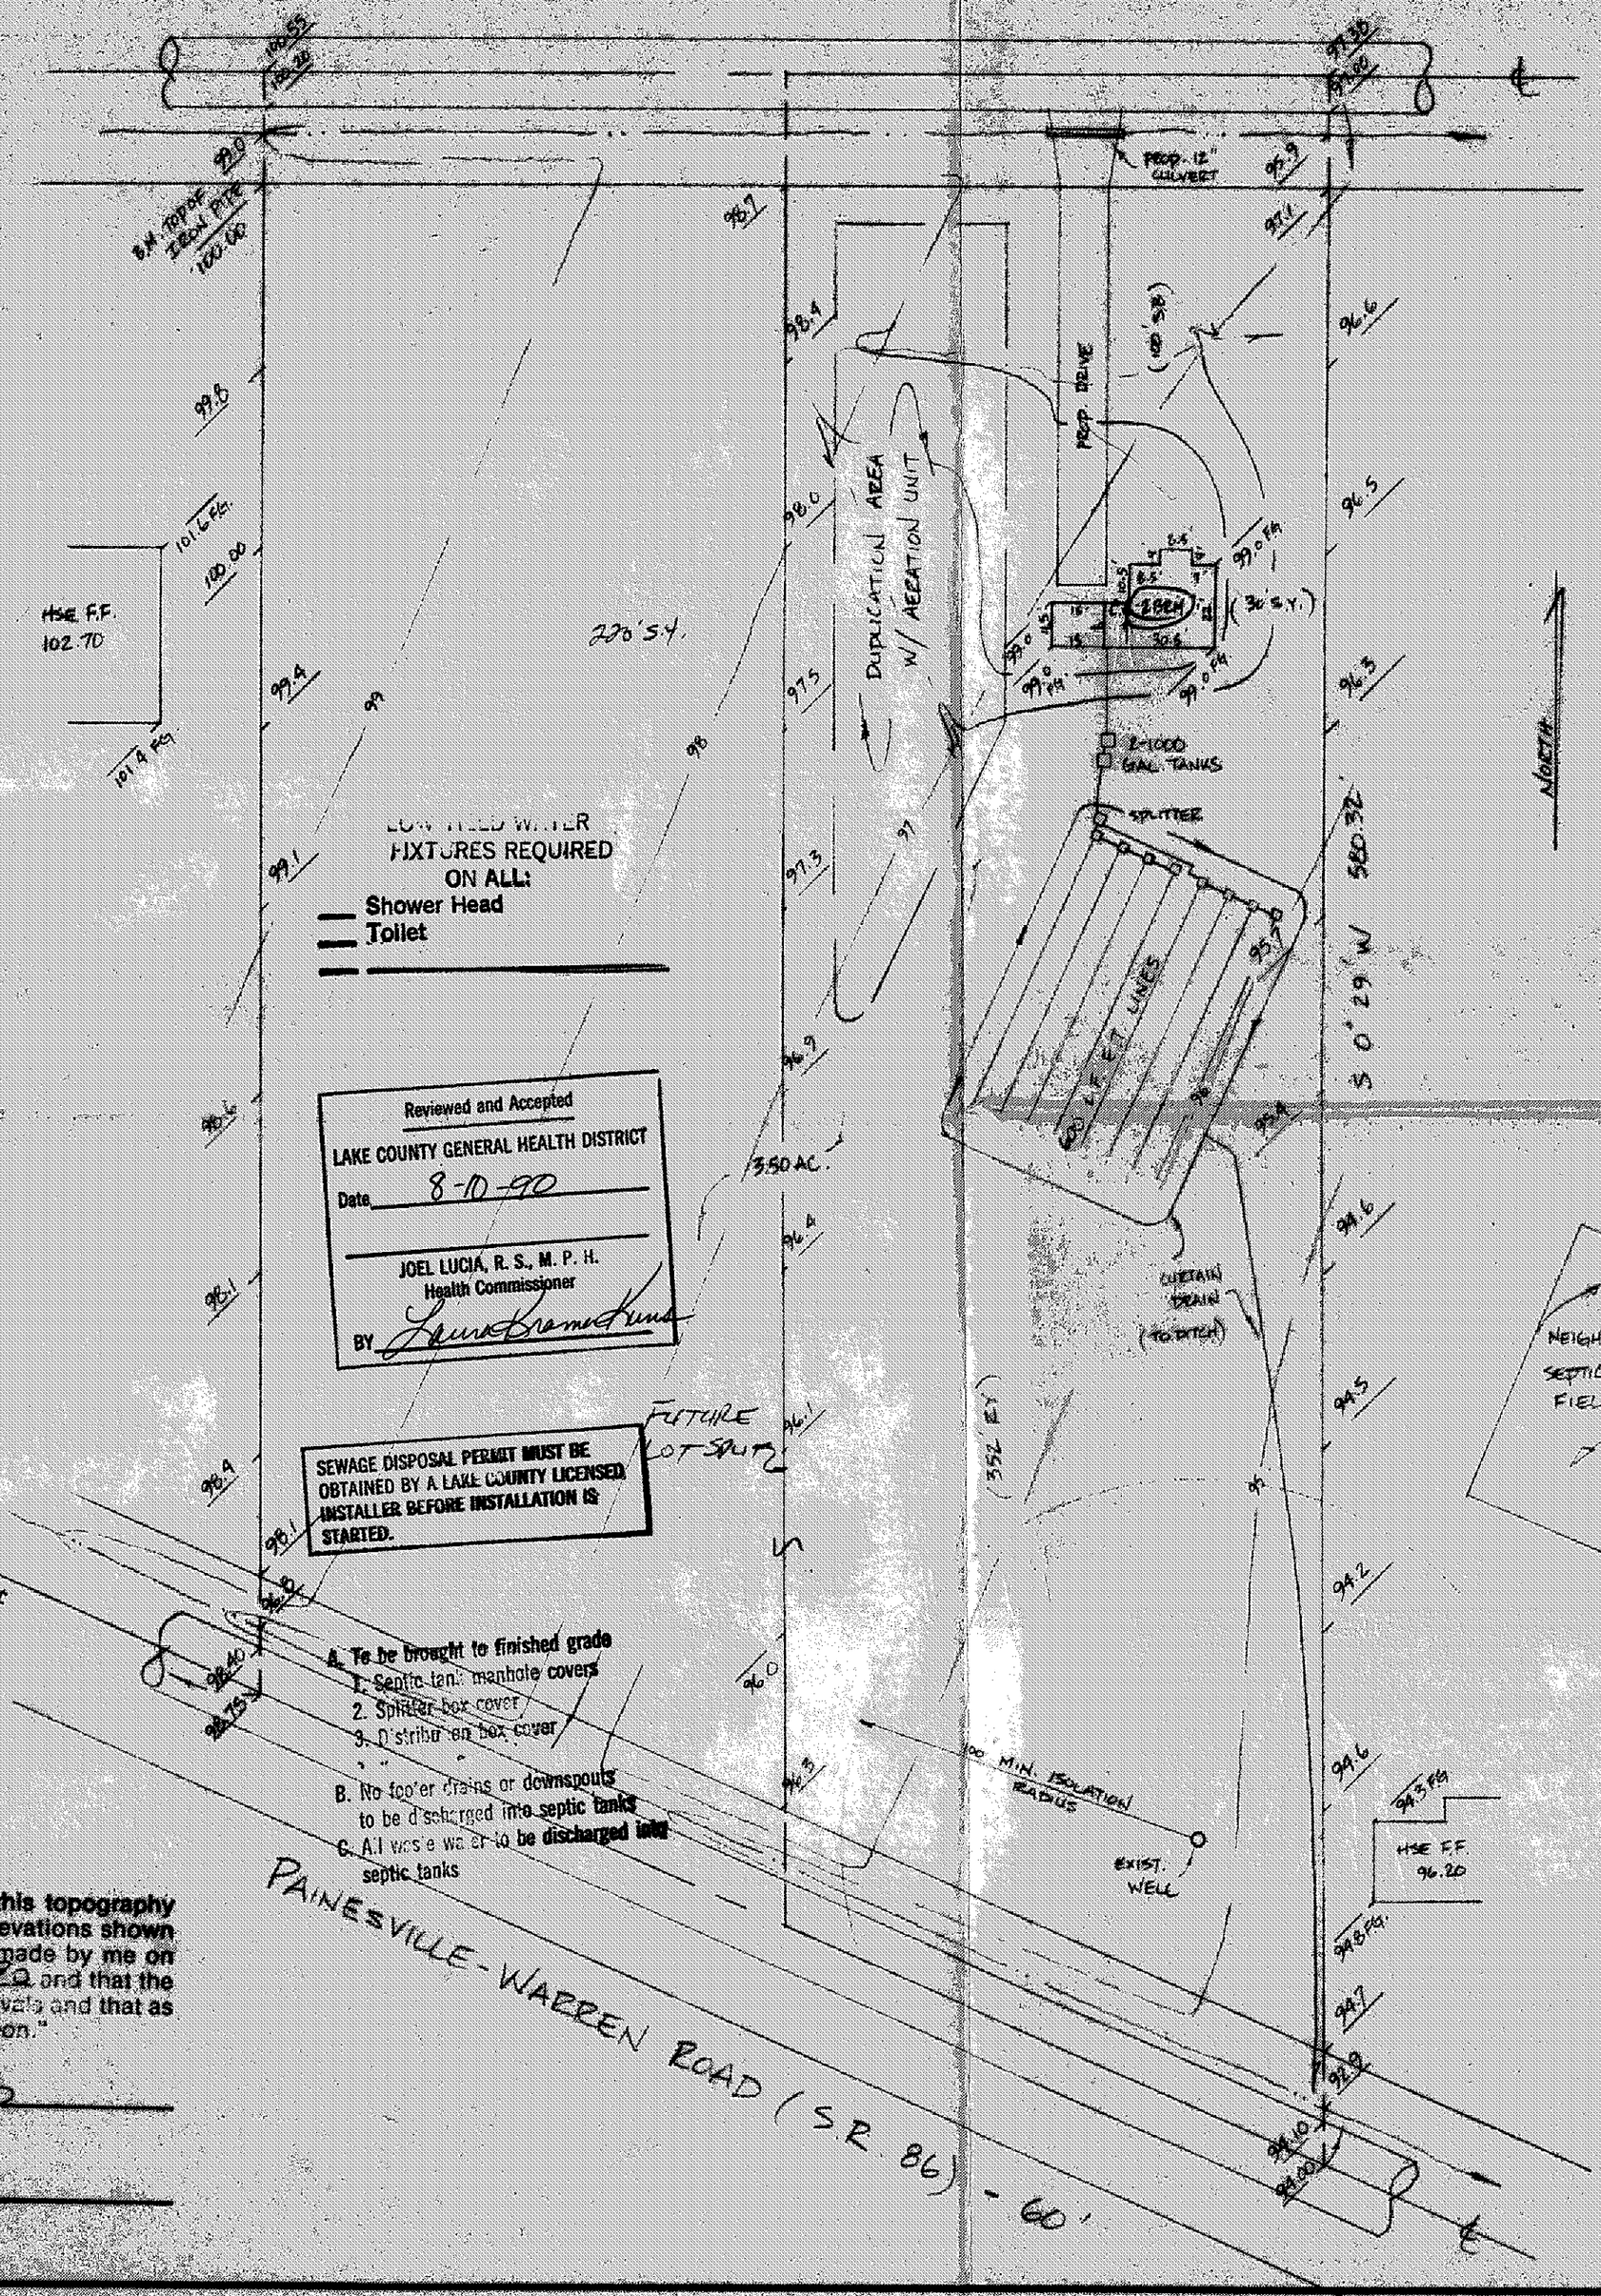

LOW FLOW WATER FIXTURES REQUIRED ON ALL:
- Shower Head
- Toilet

Reviewed and Accepted
LAKE COUNTY GENERAL HEALTH DISTRICT
Date 8-10-90
JOEL LUCIA, R. S., M. P. H.
Health Commissioner
BY

SEWAGE DISPOSAL PERMIT MUST BE OBTAINED BY A LAKE COUNTY LICENSED INSTALLER BEFORE INSTALLATION IS STARTED.

A. To be brought to finished grade
1. Septic tank manhole covers
2. Splitter box cover
3. Distribution box cover

B. No footer drains or downspouts to be discharged into septic tanks

C. All waste water to be discharged into septic tanks

"I, the undersigned hereby certify that this topography indicated by 6", 1' or 2' contours, and elevations shown hereon represent an actual field survey made by me on the 2nd day of July, 1990 and that the elevations were taken at appropriate intervals and that as of that date they existed as indicated hereon."

Name

#6343

Reg. No.

SITE PLAN

LEROY TOWNSHIP, LAKE COUNTY, OHIO

for: BOB COLLINS (CLIENT / OWNER)

8070 CALLOW ROAD (ADDRESS STREET) — (CITY) — 254-9291 (ZIP)

SUBDIVISION NAME — VOL. — PG. — SUBLOT NO. — STREET

LOT 46 — TRACT 1024 — VOLUME B36 — PAGE — PERM. PARCEL NO. TA-16A-4 — STREET HUNTOON RD.

LEGEND

- SANITARY MANHOLE
- STORM MANHOLE
- INLET OR CATCH BASIN
- HYDRANT
- EXISTING CONTOURS
- PROPOSED CONTOURS
- EXIST. ELEV. 100.0
- PROP. ELEV. 100.0
- WATER VALVE (GAS)
- WATER METER (GAS)
- AS BUILT ELEVATION 100.0
- INDICATES DIRECTION OF SURFACE DRAINAGE

REMARKS

ALL BOUNDARY DATA SHOWN WAS OBTAINED FROM (DEEDS, RECORDED SUBDIVISION PLAT OR OTHER PUBLIC RECORDS)

LOCATIONS AS SHOWN OF ADJACENT WELLS AND SEPTIC TANKS OBTAINED FROM LAKE COUNTY HEALTH DEPARTMENT

DESIGN CERTIFICATION

THIS PLAT WAS PREPARED BY ME, AND IS CORRECT TO THE BEST OF MY KNOWLEDGE AND BELIEF.

NAME — SURVEYOR — REGISTRATION NO. #6343

CHECK LIST

- NO. OF BEDROOMS
- DIMENSIONS
- BEARINGS
- TIE TO NEAREST STREET
- SUBLOT NO. PARCEL NO.
- SURROUNDING OWNERS
- BLDG. DIMENSIONS FIN. GR.
- BLDG. TIES FIN. GRADES
- ASPHALT TYPE WIDTH THICKNESS
- SIDEWALK TYPE WIDTH THICKNESS
- CULVERT TYPE DIA., LENGTH
- ROCK OUTCROPPINGS
- WATER MAIN SIZE, LOCATION
- SAN. SEWER SIZE % GR., LOC.
- SAN. MH. CAST. ELEV., INV. ELEV.
- SAN. CONN. SIZE, LOC. DEPTH
- STORM SEWER SIZE % GR., LOC.
- STORM MH. CAST. ELEV. INV. ELEV.
- PAVT. TYPE GRADE CURB
- GAS LINE LOC. SIZE PRESSURE
- SEPTIC TANK LOCATION & DUPLICATION AREA
- WELL LOCATION
- ISOLATION RADIUS FROM WELL

REVISIONS		
NO.	DATE	BY
1		
2		
3		
4		
5		

PLAN PREPARED BY:
BABCOCK • JONES & ASSOCIATES, INC.
PAINESVILLE, OHIO

DRAWN BY RL	SCALE 1" = 40'	PHONE NO. 357-1811
CHK'D. MT	DATE 7-30-90	DRAWING NO. 90-143
CREW CHIEF CC	APP'D. MT	

"AS BUILT" CERTIFICATION

I, HEREBY CERTIFY THAT THE CIRCLED GRADES ARE EXISTING FINISH GRADES CHECKED IN THE FIELD ON _____, 19____ AND ARE CORRECT TO THE BEST OF MY KNOWLEDGE AND BELIEF.

REGISTERED SURVEYOR — REG. NO.

TBM TOP OF IRON PIPE SOUTHEAST CORNER OF PARCEL, ELEV. = 100.00

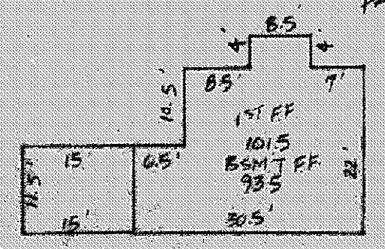

Grading Plan Approved as shown and/or noted
THOMAS P. GILLES, P.E.
Lake County Engineer
By GJH Date 8/23/90

ZONING # 1804