Grading Plan A
as shown and/or no
THOMAS P. GILLES, P.E.
Lake County Engineer

By JWK Date 20 July 73

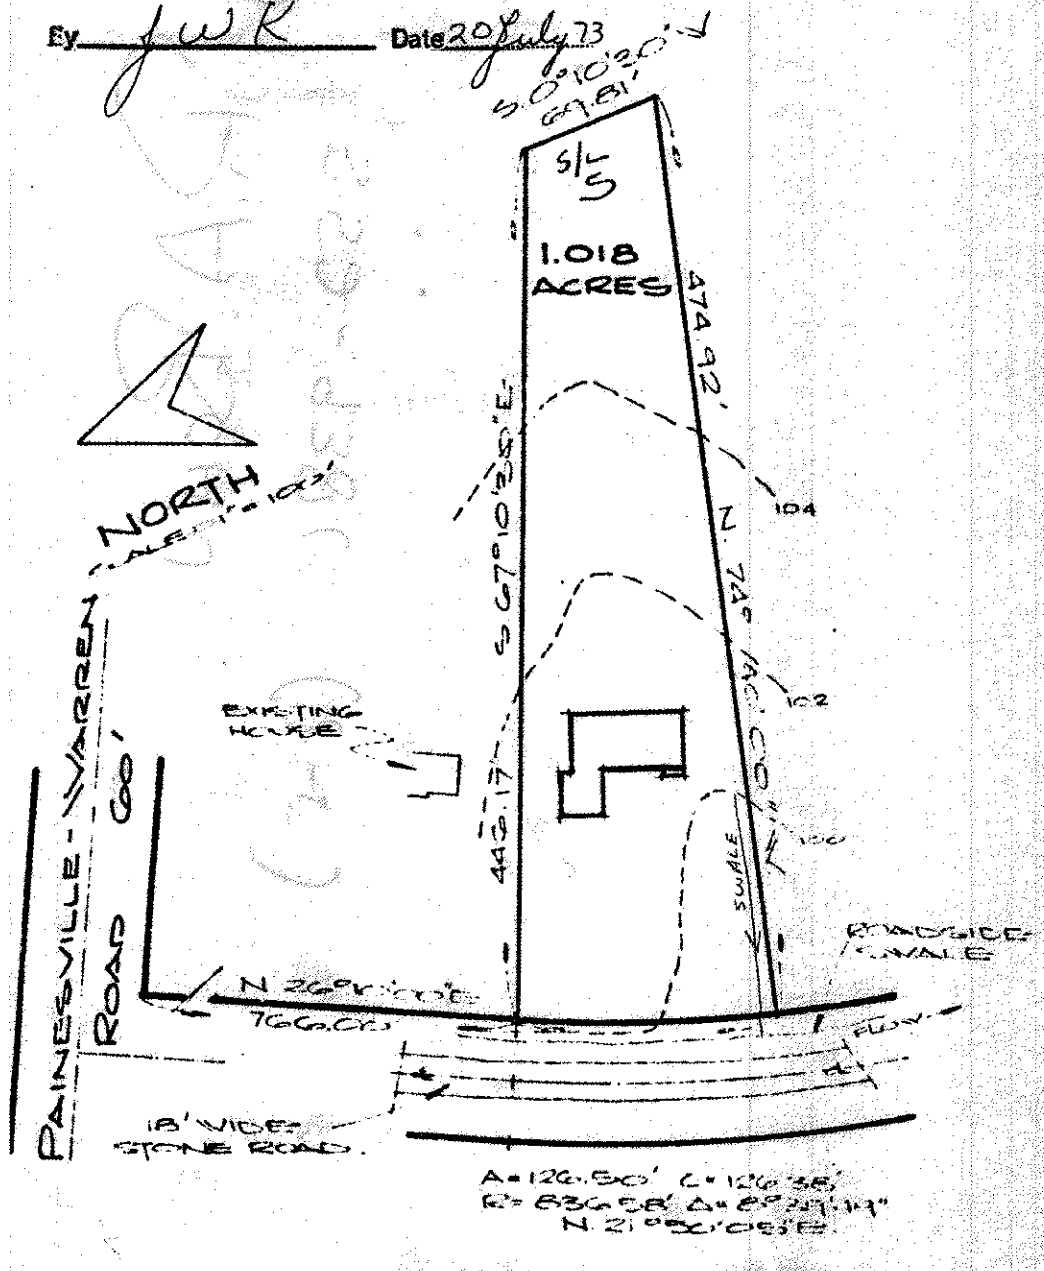

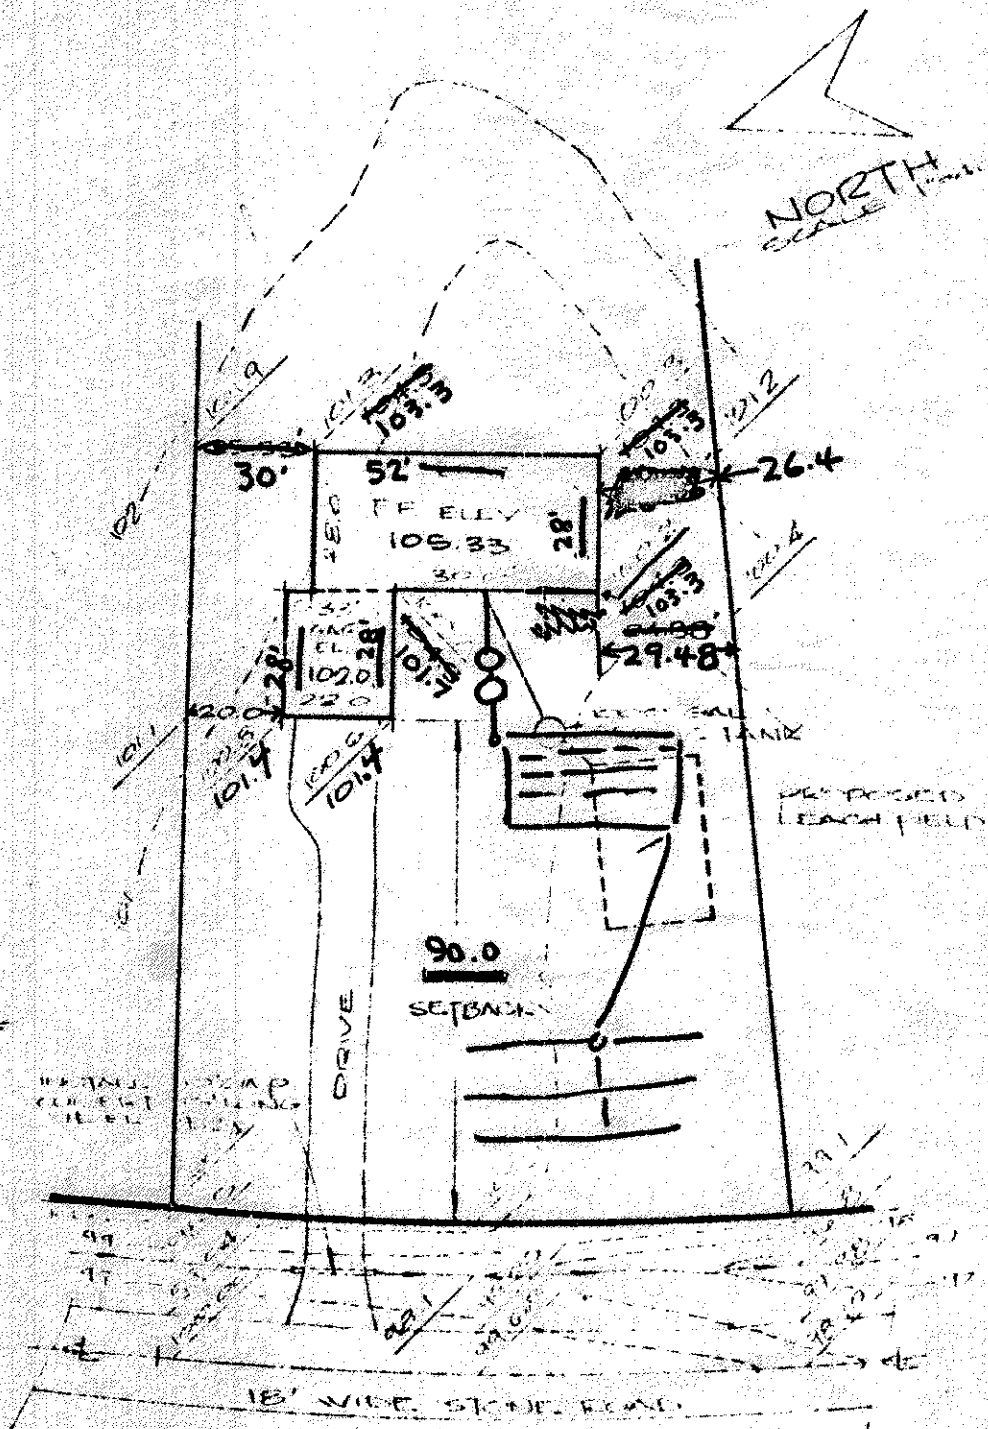

RICHARD J. BILSKI
P.S. 5244