JOSEPH D. HADDEN

Registered Surveyor

130 E. JACKSON STREET
PAINESVILLE, OHIO 44077

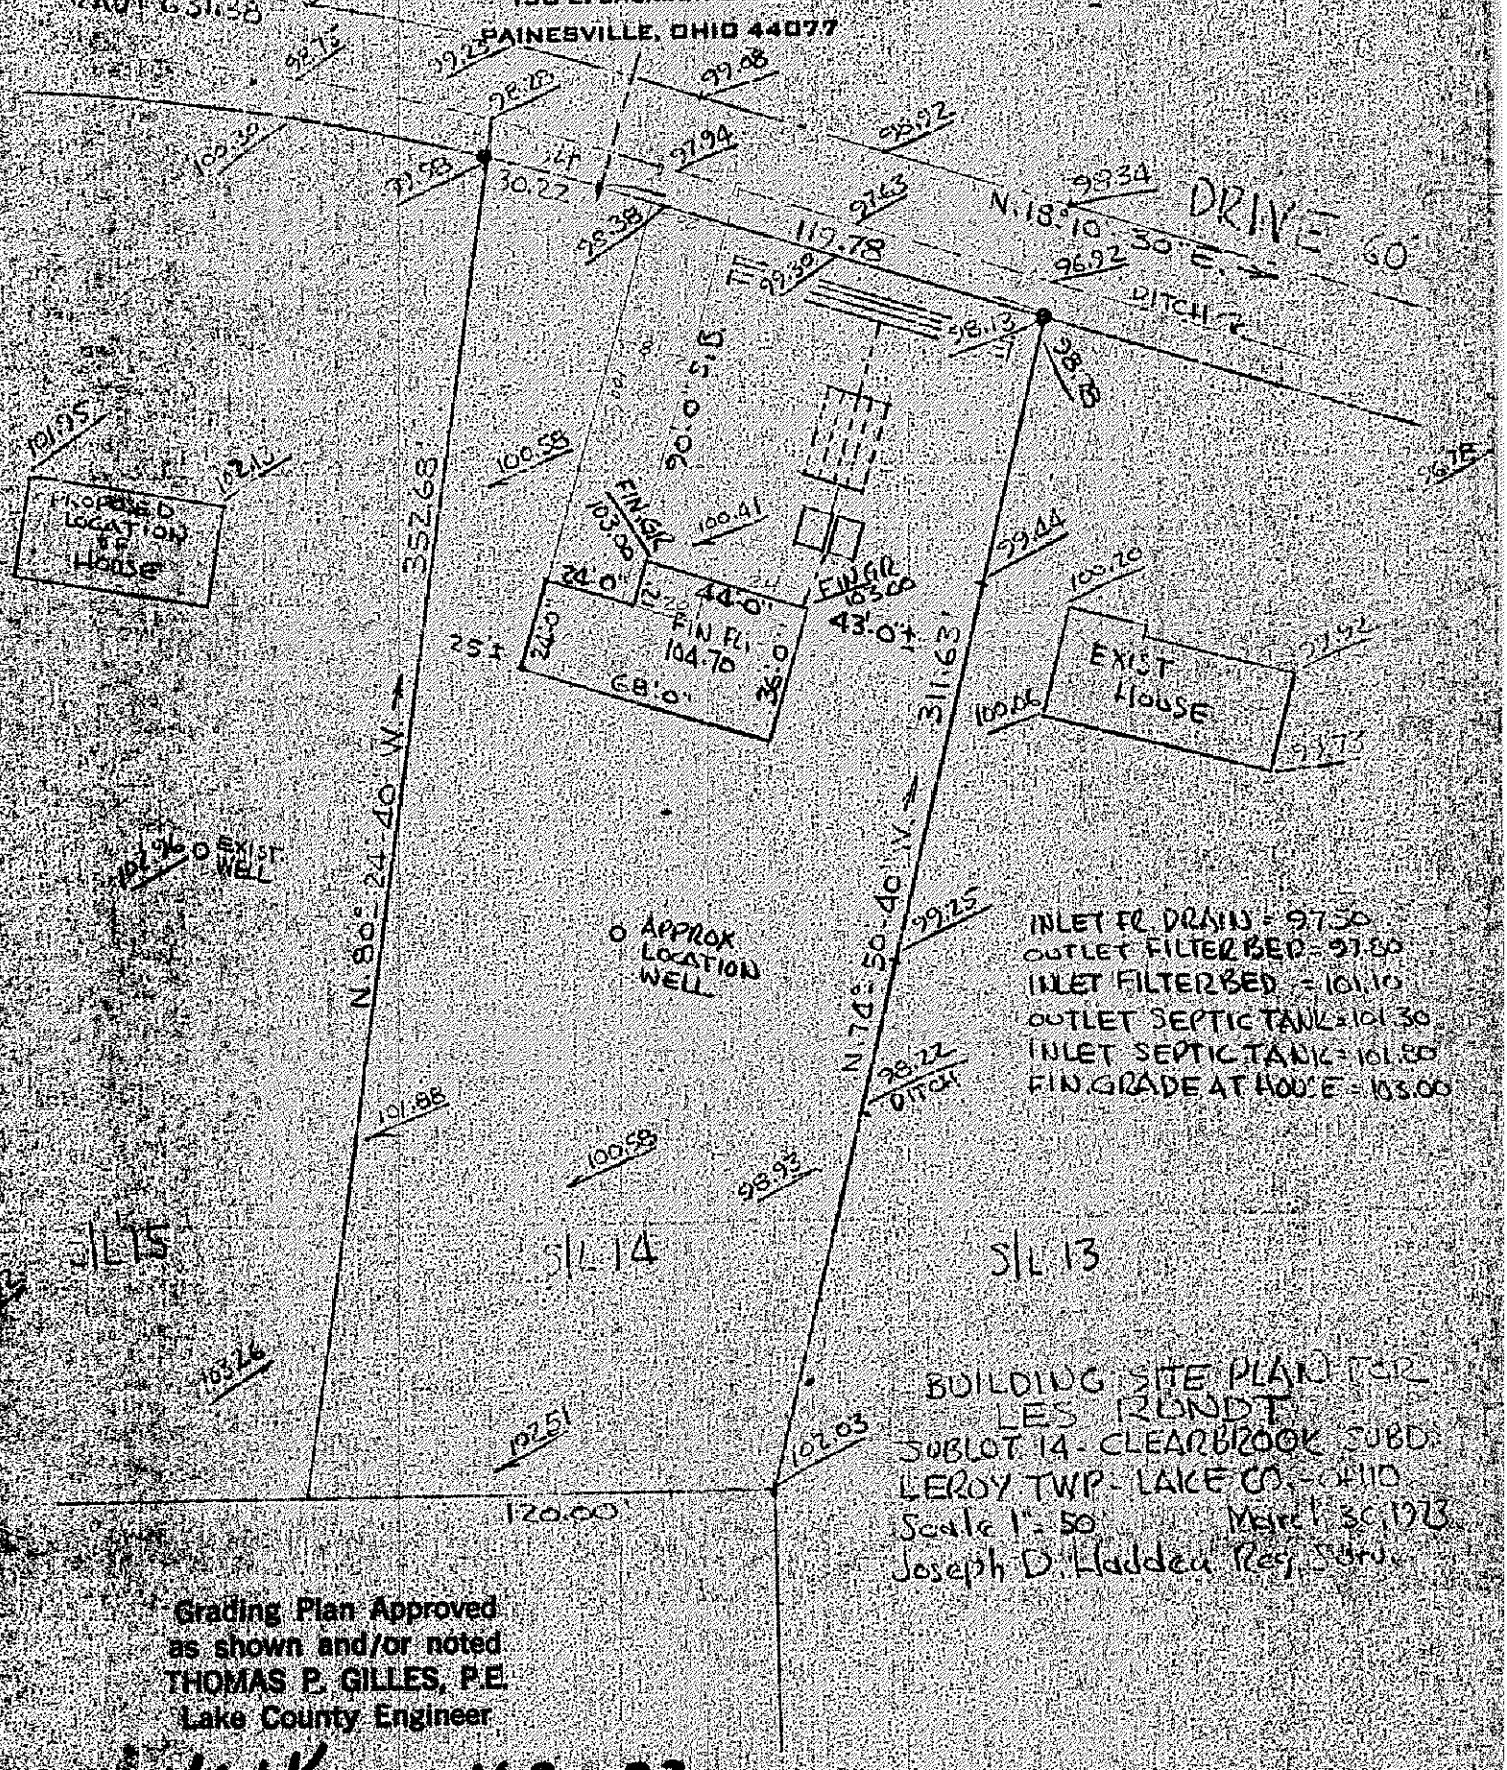

Grading Plan Approved
as shown and/or noted
THOMAS P. GILLES, P.E.
Lake County Engineer

By JWK Date 16 May 73