SEPTIC SYSTEM PROFILE

SCALE HOR.: 1"=20'
VERT.: 1"=5'

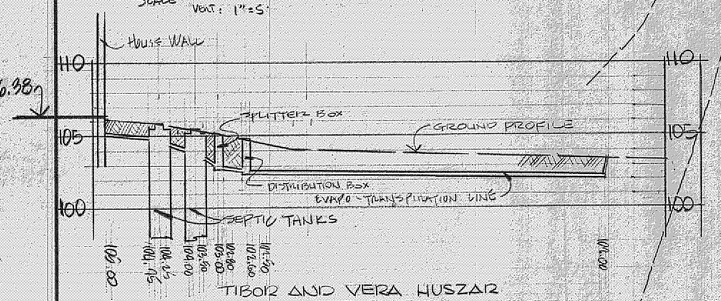

TIBOR AND VERA HUSZAR
VOL. 777 - PAGE 1491
29.5 Ac.

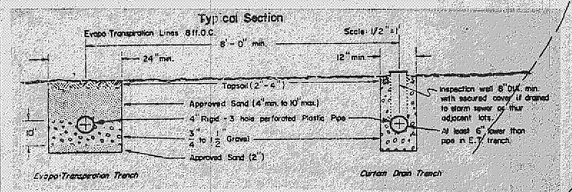

DESIGN CERTIFICATION

I HEREBY CERTIFY THAT THIS PLAT WAS PREPARED BY ME AND IS CORRECT TO THE BEST OF MY KNOWLEDGE AND BELIEF.

REGISTERED SURVEYOR
No. 5553

"AS BUILT" CERTIFICATION

I HEREBY CERTIFY THAT THE CIRCLED GRADES ARE EXISTING FINISHED GRADES CHECKED IN THE FIELD ON _____ AND THAT THE SURVEY IS CORRECT TO THE BEST OF MY KNOWLEDGE AND BELIEF.

REGISTERED SURVEYOR
No.

LEROY TOWNSHIP
Zoning Approved
#1242 9-19-79
Zoning Inspector

Grading Plan Approved as shown and/or noted
LAKE COUNTY SOIL & WATER CONSERVATION DISTRICT
By [illegible] 10-15-79

SLOVENIAN MUTUAL BENEFIT ASSOC.
VOL. 641 - PAGE 175

NOTE: EXISTING CONTOURS ARE SHOWN IN DASHED LINES. PROPOSED CONTOURS ARE SHOWN IN SOLID LINES. ALL UNDERLINED ELEVATIONS ARE PROPOSED FINISHED ELEVATIONS.

REVISION DESCRIPTION	DATE	BY	CH'K'D
1. RELOCATE PROP. BLDG. & SHOW WELL	8/23/76	GM	
2. ADD SEPTIC SYSTEM & WELL	"	"	
3. ADDED SEPTIC SYS. PROFILE & GRADES	9/17/79	CB	

Colpetzer • Woods Consultants, Inc.
CONSULTING ENGINEERS AND SURVEYORS
PAINESVILLE, OHIO 44077

DATE 8-12-76
SCALE 1"=20'
DRAWN BY [illegible]
CH'K'D BY
F.B.# 283 PG. 126

TOPOGRAPHICAL SURVEY OF PROPERTY FOR
TIBOR HUSZAR
PART OF LOT No. 27
LEROY TOWNSHIP - LAKE COUNTY - OHIO

SHEET / OF
CONTRACT NO. 76-175