NOTES: 1. LAKE COUNTY HEALTH DISTRICT AND EPA RULES AND STANDARDS ARE TO BE USED.

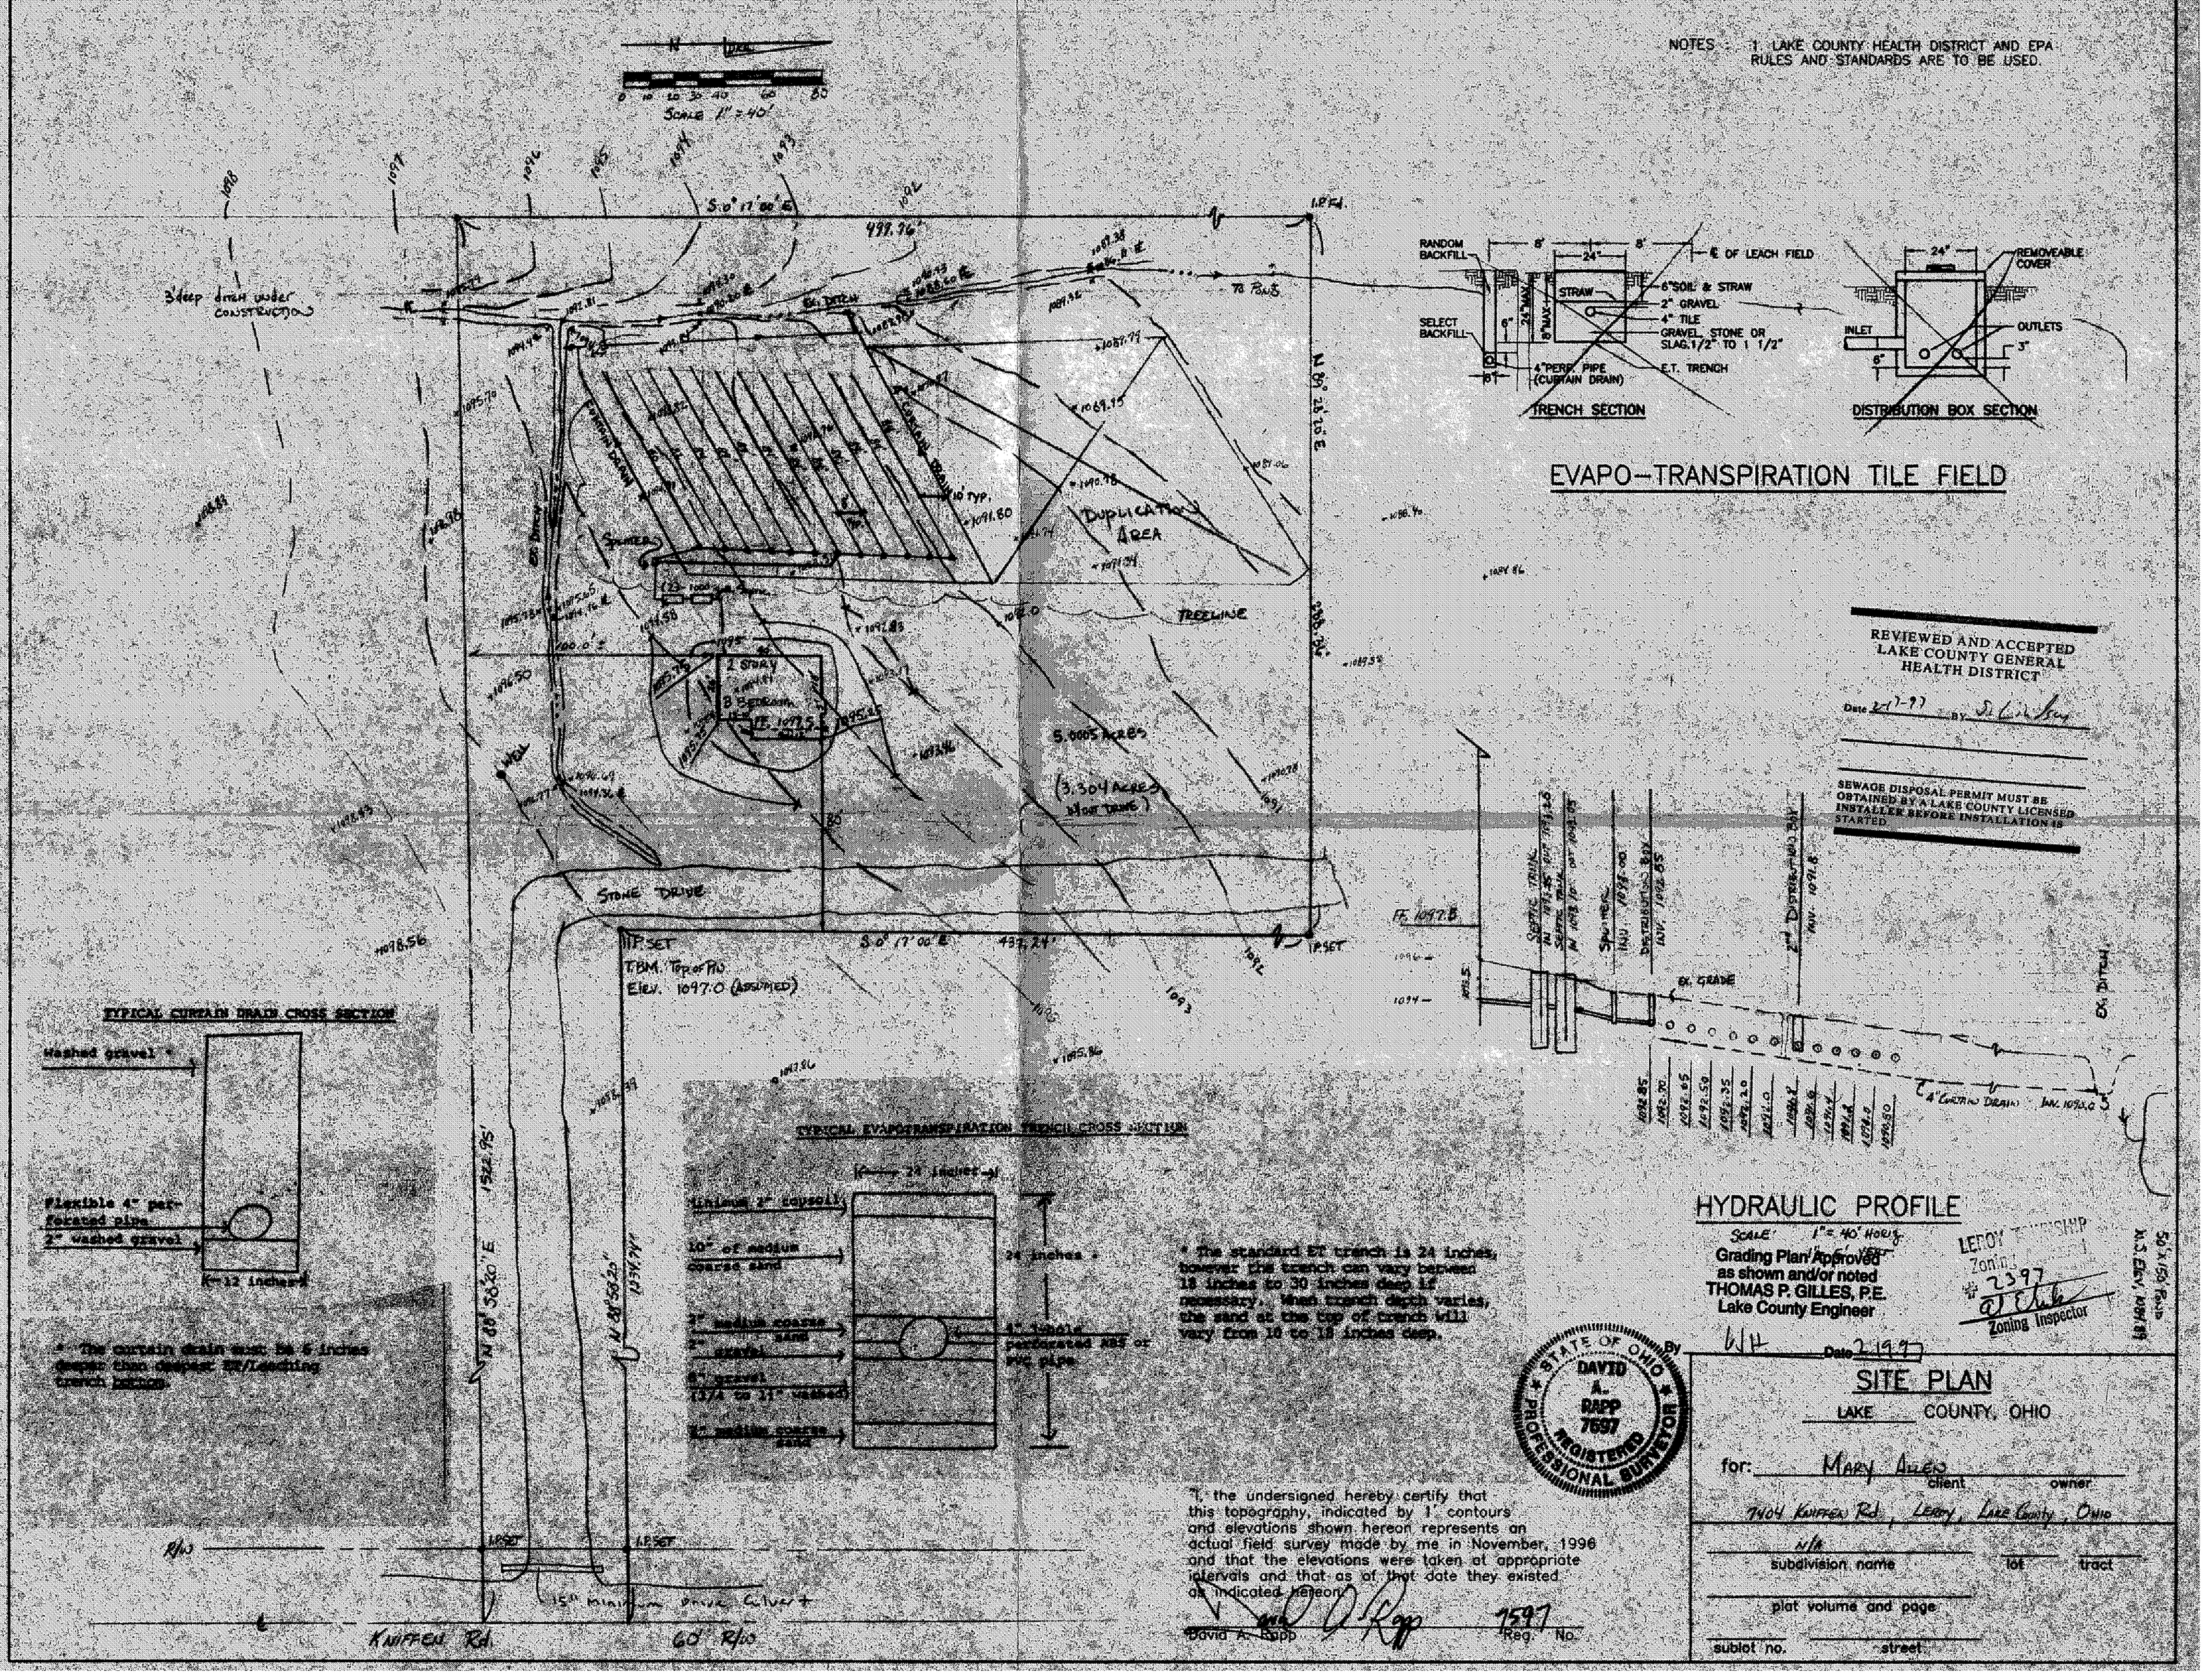

REVIEWED AND ACCEPTED
LAKE COUNTY GENERAL HEALTH DISTRICT

Date 2-17-97 By [signature]

SEWAGE DISPOSAL PERMIT MUST BE OBTAINED BY A LAKE COUNTY LICENSED INSTALLER BEFORE INSTALLATION IS STARTED.

"I, the undersigned hereby certify that this topography, indicated by 1' contours and elevations shown hereon represents an actual field survey made by me in November, 1996 and that the elevations were taken at appropriate intervals and that as of that date they existed as indicated hereon."

David A. Rapp 7597 Reg. No.

SITE PLAN

LAKE COUNTY, OHIO

for: Mary Allen client owner

7404 Kniffen Rd., Leroy, Lake County, Ohio

N/A subdivision name lot tract

plat volume and page

sublot no. street