FOR

TOM REED General Cont.

BEING 9/LEG. OF THE SUNSHINE FARMS (PROPOSED). IN THE TOWNSHIP OF LEROY COUNTY OF LAKE, STATE OF OHIO

1" = 30'

N

EAST PROP

SOUTH PROP

BENCHMARK - 100.00 ASSUMED
DUPLEX NAIL IN POWER POLE

VERT 1" = 5' HORZ 1" = 50'

HYDRAULIC PROFILE
VERT 1" = 3' HORZ 1" = 30'
3 BEDROOM HOME

FF-100.4

GRINDER PUMP
REQ'D IF PLUMBING BASEMENT

BSMT - 91.73

370'± 4" PVC

DIST BOX (2)
INV 94.0

SPLITTER
INV 94.2

LOCAL TANK
INV 95.8

MAIN TANK
INV 95.8

L.R. & P.A. HENDERSHOT
VOL 511 - 410

HENRY W. & HAZEL SCHULTZ
VOL 308 - 329
7.717 Ac.

EAST 1898.18

DILUTION W/AERATION

4" PVC

TO EXISTING

500' SB

28'

PORCH

FF 100.4
BSMT 91.73

GAR 16.4

24'

16.3'

1263' RY

100' R

3 PROP WELL

50'

SET @ 125'

3 SWEEP CURTAIN DRAIN

PROP POND
NORMAL W.S. 93.0'
BASED ON APPARENT WATER TABLE

KNIFFEN RD 60'

NORTH 177.00'

SOUTH 177.00'

97

8" TOPSOIL

8" GRAVEL

20' R/W

40' FROM ℄ RD

3' GRAVE

WEST 1894.35

N. OHIO CELLULAR PHONE CO.
VOL 184-710

Reviewed and Accepted
LAKE COUNTY GENERAL HEALTH DISTRICT
Date 10-25-94
May need pump for sewer system
JOEL LUCIA, R. S., M. P. H.
Health Commissioner
BY J. Lucia

Sept 30, 1994
Rev 10-20-94

I, the undersigned hereby certify that this topography, indicated by 1' contours, and elevations shown hereon represent an actual field survey made by me on Aug 23, 1994 and that the elevations were taken at appropriate intervals and that as of that date they existed as indicated hereon.

T. M. Chatfield PS
No 6857

VILLAGE SURVEYING CO.
P.O. Box 1046, Fairport Har., OH 44077
(216) 357-1959

A. To be brought to finished grade
1. Septic tank manhole covers
2. Splitter box cover
3. Distribution box cover

B. No footer drains or downspouts to be discharged into septic tanks

C. All waste water to be discharged into septic tanks

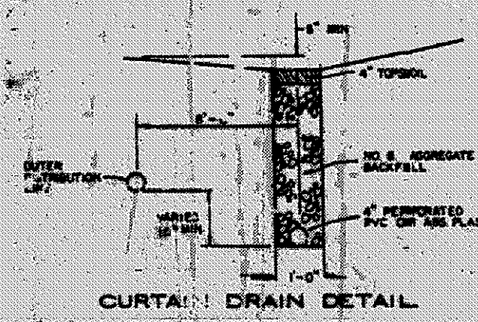

CURTAIN DRAIN DETAIL

LOW YIELD WATER FIXTURES REQUIRED ON ALL:
___ Shower Head
___ Toilet
___

 

EVAPORATION-TRANSPIRATION TRENCH DETAIL

SEWAGE DISPOSAL PERMIT MUST BE OBTAINED BY A LAKE COUNTY LICENSED INSTALLER BEFORE INSTALLATION IS STARTED.

Grading Plan Approved as shown and/or noted
THOMAS P. GILLES, P.E.
Lake County Engineer
By GJH Date 10-26-94