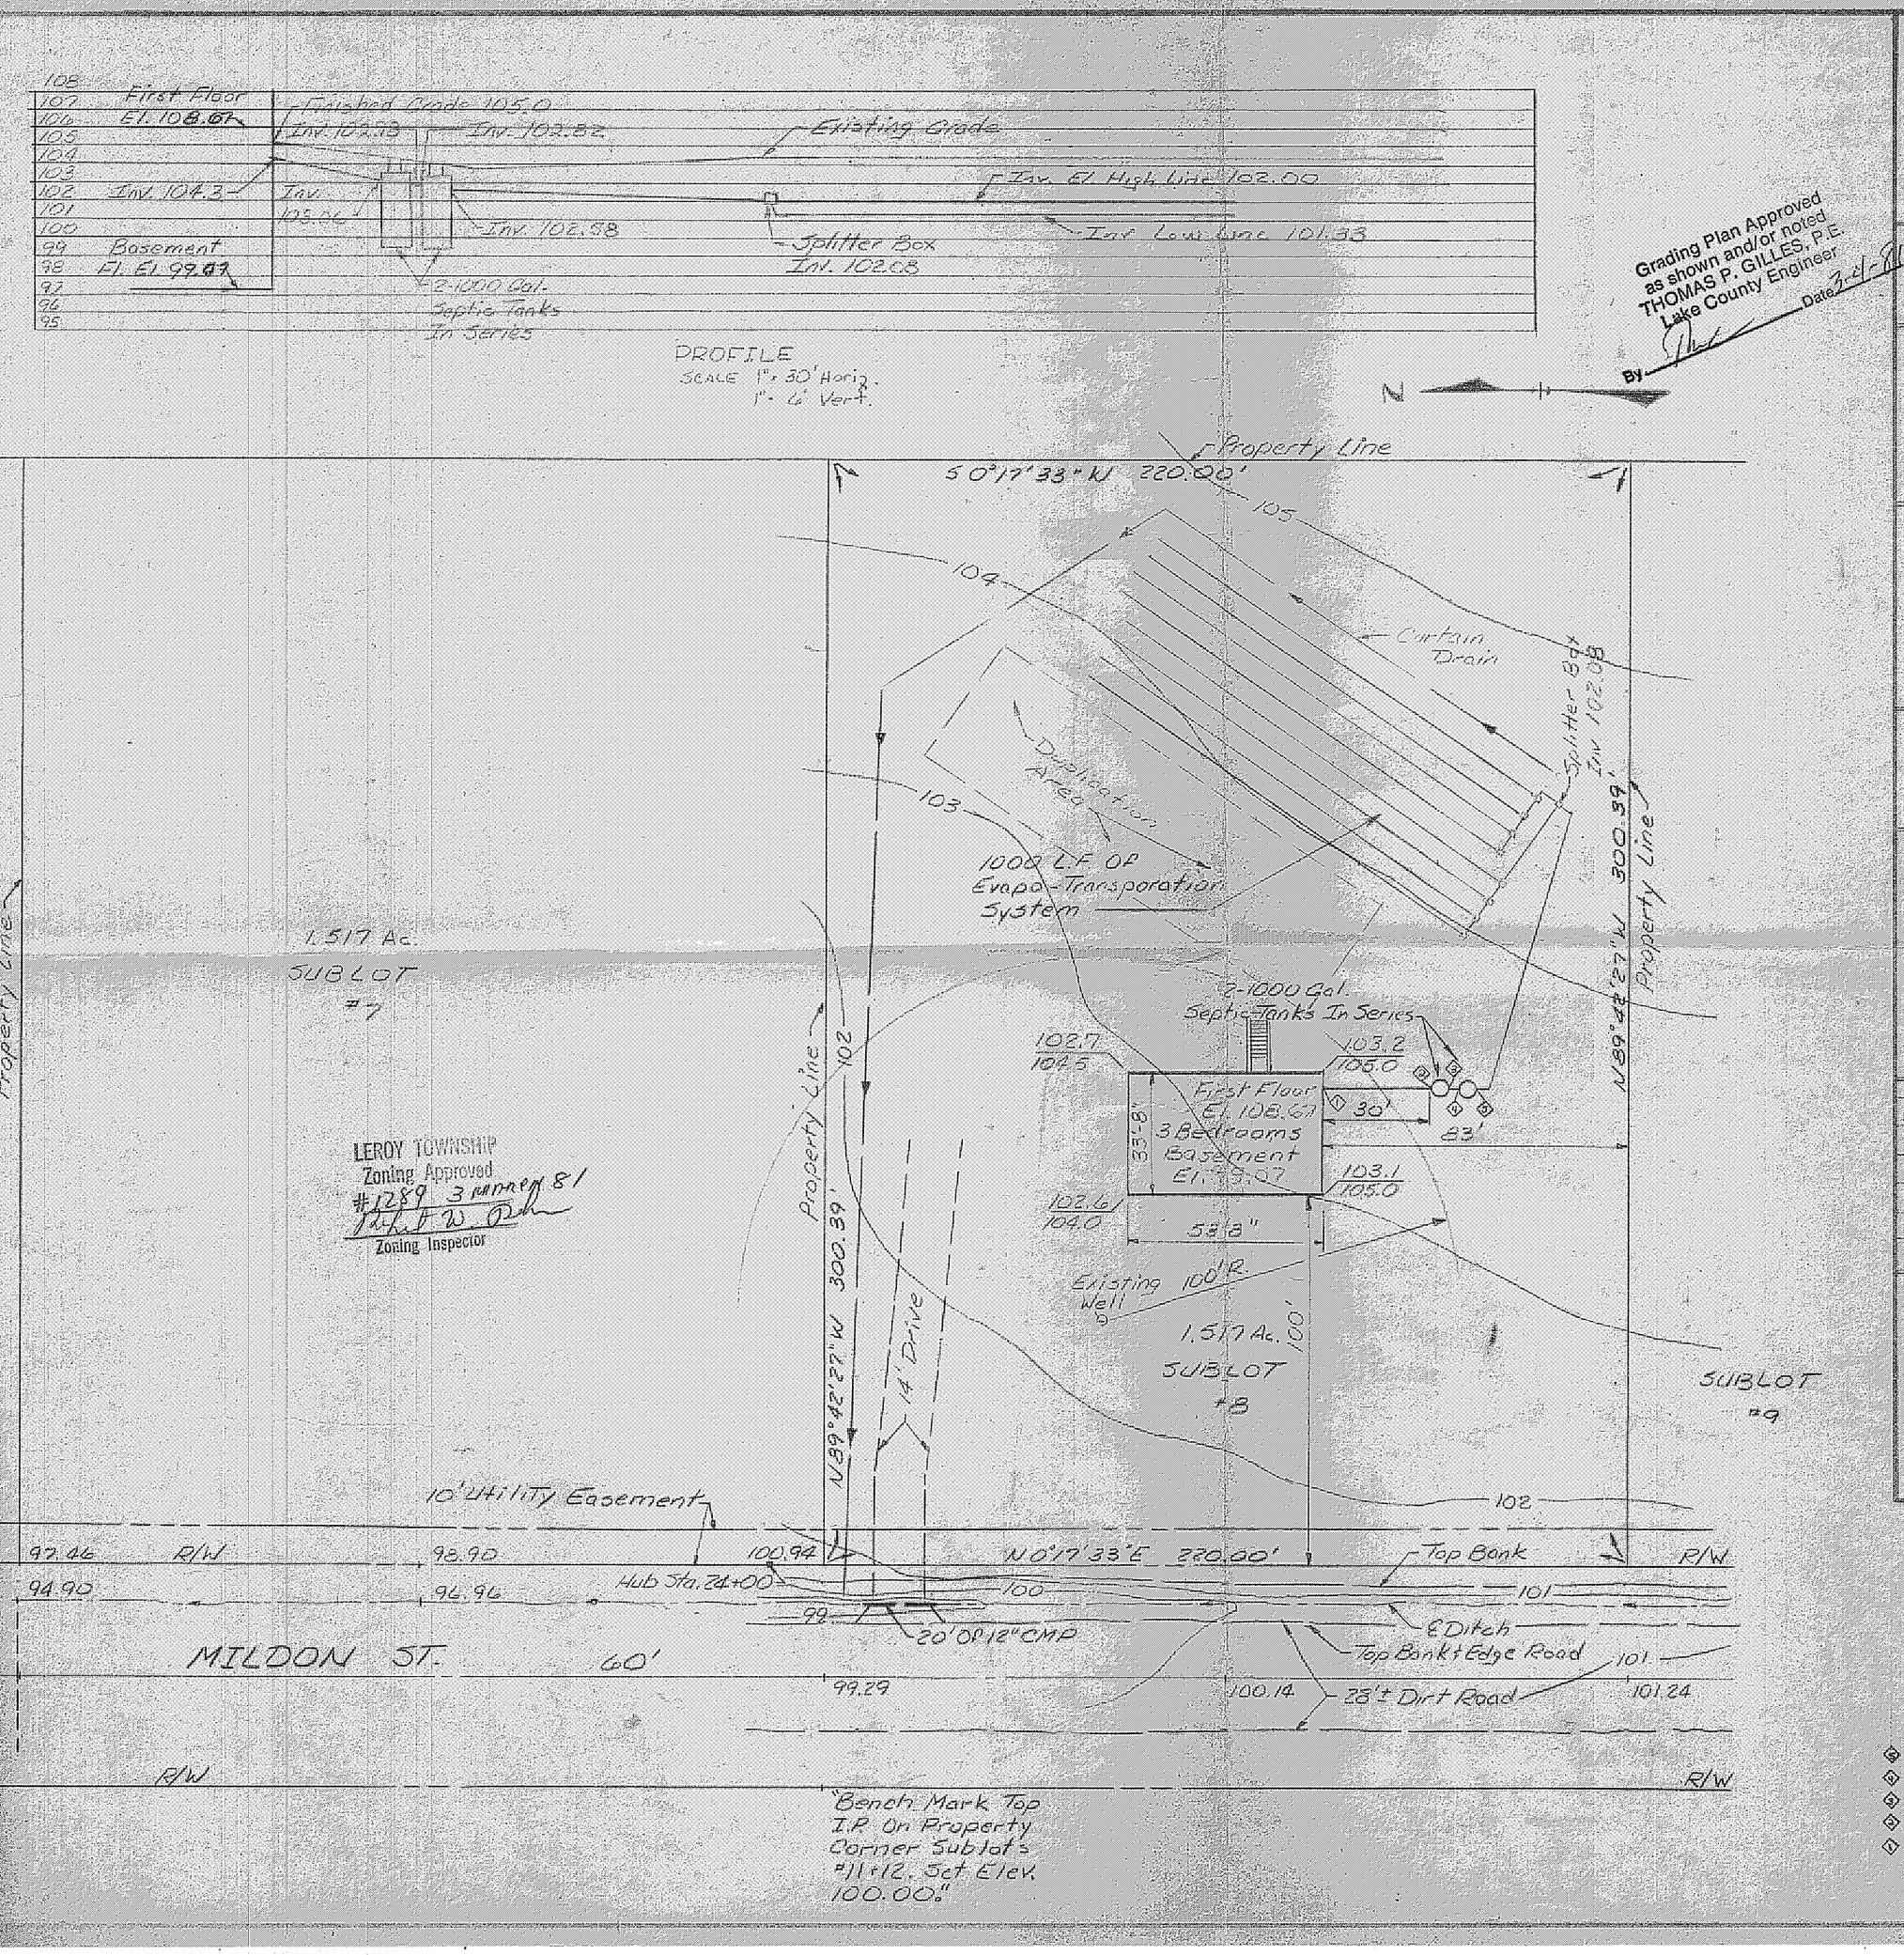

Grading Plan Approved as shown and/or noted
THOMAS P. GILLES, P.E.
Lake County Engineer
By [signature] Date 3-4-81

SITE PLAN

LEROY TOWNSHIP, LAKE COUNTY, O

FOR: DENNIS DAVIS
CLIENT OWNER

5169 Cockwood Rd. Perry
ADDRESS STREET CITY

Cascade Ridge #1
SUBDIVISION Z-13 NAME
#8 VOL. - PG. Mildon St.
SUBLOT NO. STREET

LOT TRAC
VOLUME PAGE
PERM PARCEL NO. STRE

LEGEND

RIGHT OF WAY
SANITARY
STORM
WATER LINE
GAS LINE
EXISTING CONTOURS
PROPOSED CONTOURS
EXIST. ELEV. 99.5 / 100.0 PROP. ELEV.

PROPERTY LINE
Easement
AS BUILT ELEVATION 100
Prop. Elev. 101.
INDICATES
DIRECTION OF
SURFACE DRAINAGE

REMARKS

DESIGN CERTIFICATION

THIS PLAT WAS PREPARED BY ME, AND IS CORREC
TO THE BEST OF MY KNOWLEDGE AND BELIEF.

NAME SURVEYOR REGISTRATION NO

CHECK LIST

NO. OF BEDROOMS
DIMENSIONS
BEARINGS
TIE TO NEAREST STREET
SUBLOT NO. PARCEL
SURROUNDING OWNERS
BLDG. DIMENSIONS FIN. GR.
BLDG. TIES FLR. GRADES
APRON TYPE WIDTH THICKNESS
SIDEWALK TYPE WIDTH THICKNESS
CULVERT TYPE DIA. LENGTH

REVISIONS		
NO.	DATE	BY
1	9/11/80	JR
2	10/29/80	JR
3		
4		
5		

PLAN PREPARED BY
Harry S. Jones PE, PS.
&
John T. Ruddle

DRAWN BY JR SCALE 1" = 30'
CHK'D DATE 8/26/80 DRAWING #80

"AS BUILT" CERTIFICATION

I, HEREBY CERTIFY THAT THE CIRCLED GRADES
EXISTING FINISH GRADES CHECKED IN FIELD
19 BY AND A
CORRECT TO THE BEST OF MY KNOWLEDGE AND

REGISTERED SURVEYOR REGISTRATION N

STATE OF OHIO
HARRY S. JONES, JR.
S-6343
REGISTERED SURVEYOR

Inv. El. 102.58
Inv. El. 102.82
Inv. El. 102.98
Inv. El. 103.06
Inv. El. 104.3