SITE PLAN
FOR
R.C. REED CONSTRUCTION
BEING A PART OF LOT No. 73, IN THE TOWNSHIP OF LEROY, COUNTY OF LAKE, STATE OF OHIO

*NOTE: BEARINGS PER RECORD DEED & MONUMENTATION FOUND
CITY

352 1924

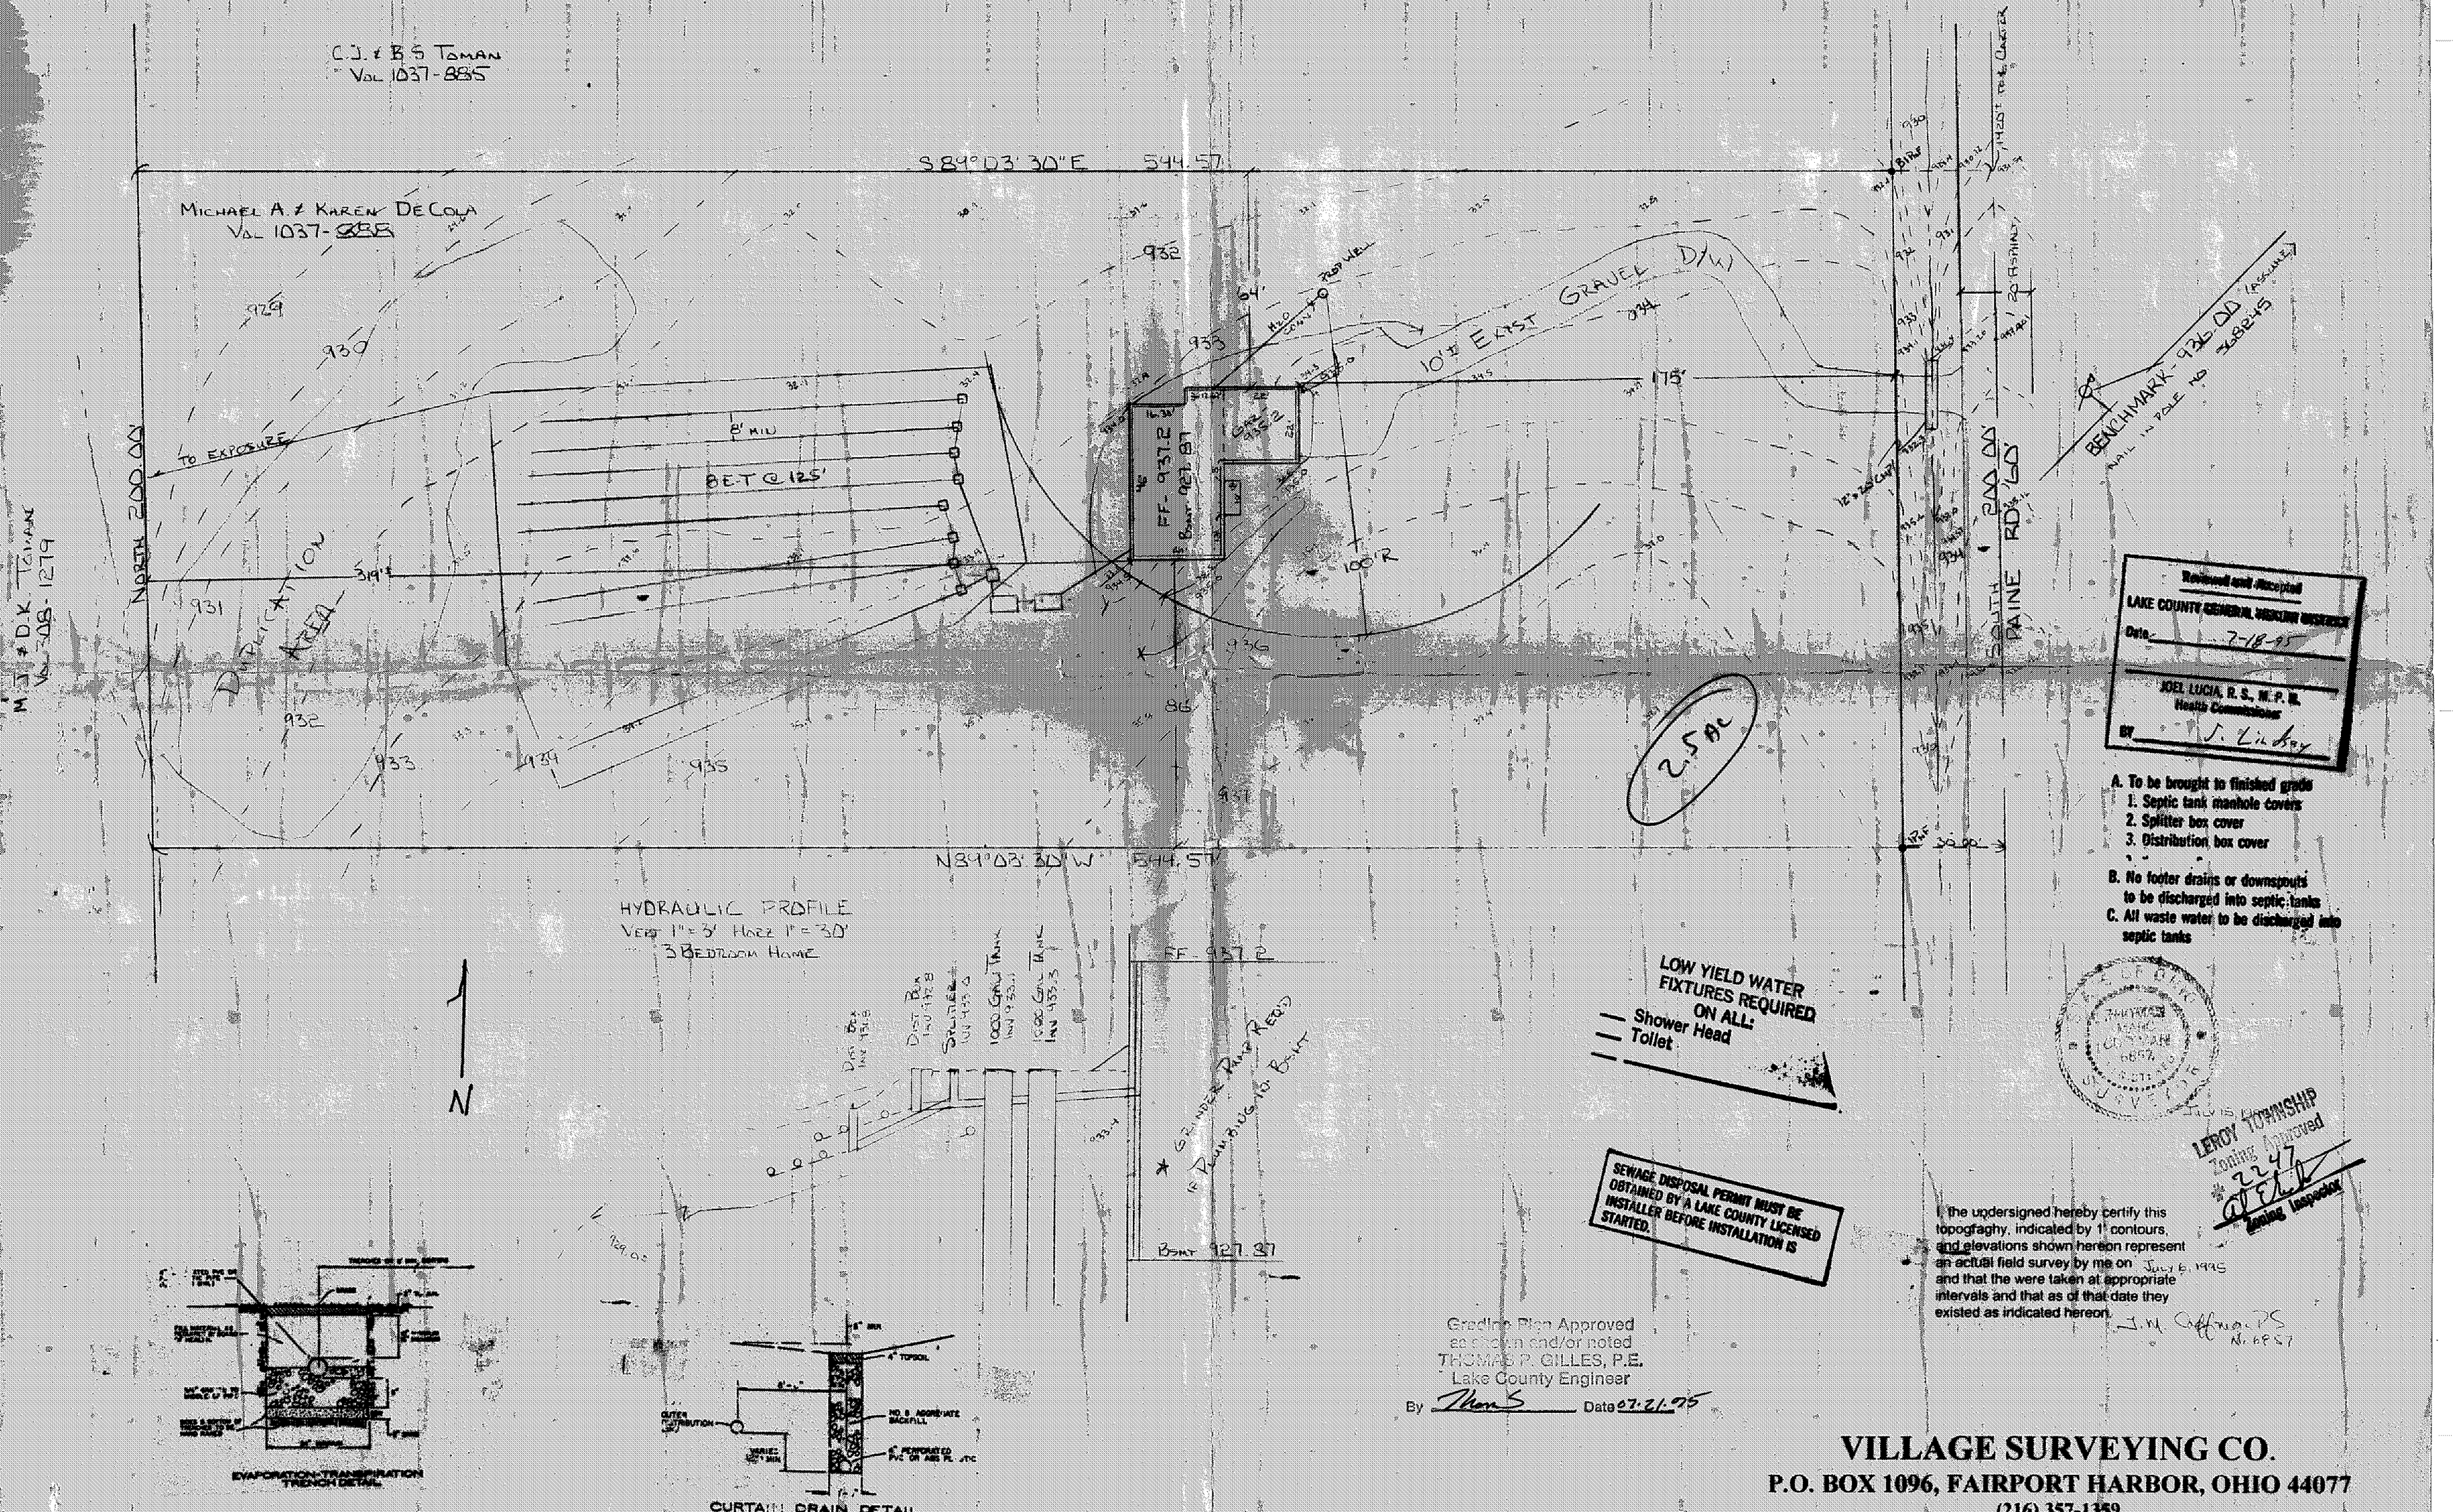

Reviewed and Accepted
LAKE COUNTY GENERAL HEALTH DISTRICT
Date 7-18-95
JOEL LUCIA, R.S., M.P.H.
Health Commissioner
BY J. Lichey

A. To be brought to finished grade
1. Septic tank manhole covers
2. Splitter box cover
3. Distribution box cover

B. No footer drains or downspouts to be discharged into septic tanks
C. All waste water to be discharged into septic tanks

LOW YIELD WATER FIXTURES REQUIRED ON ALL:
— Shower Head
— Toilet

SEWAGE DISPOSAL PERMIT MUST BE OBTAINED BY A LAKE COUNTY LICENSED INSTALLER BEFORE INSTALLATION IS STARTED.

LEROY TOWNSHIP
Zoning Approved
2247
Zoning Inspector

I, the undersigned hereby certify this topography, indicated by 1' contours, and elevations shown hereon represent an actual field survey by me on July 6, 1995 and that the were taken at appropriate intervals and that as of that date they existed as indicated hereon.

J.M. Coffman PS
No. 6957

Grading Plan Approved
as shown and/or noted
THOMAS P. GILLES, P.E.
Lake County Engineer
By Thom S Date 07-21-95

VILLAGE SURVEYING CO.
P.O. BOX 1096, FAIRPORT HARBOR, OHIO 44077
(216) 357-1359