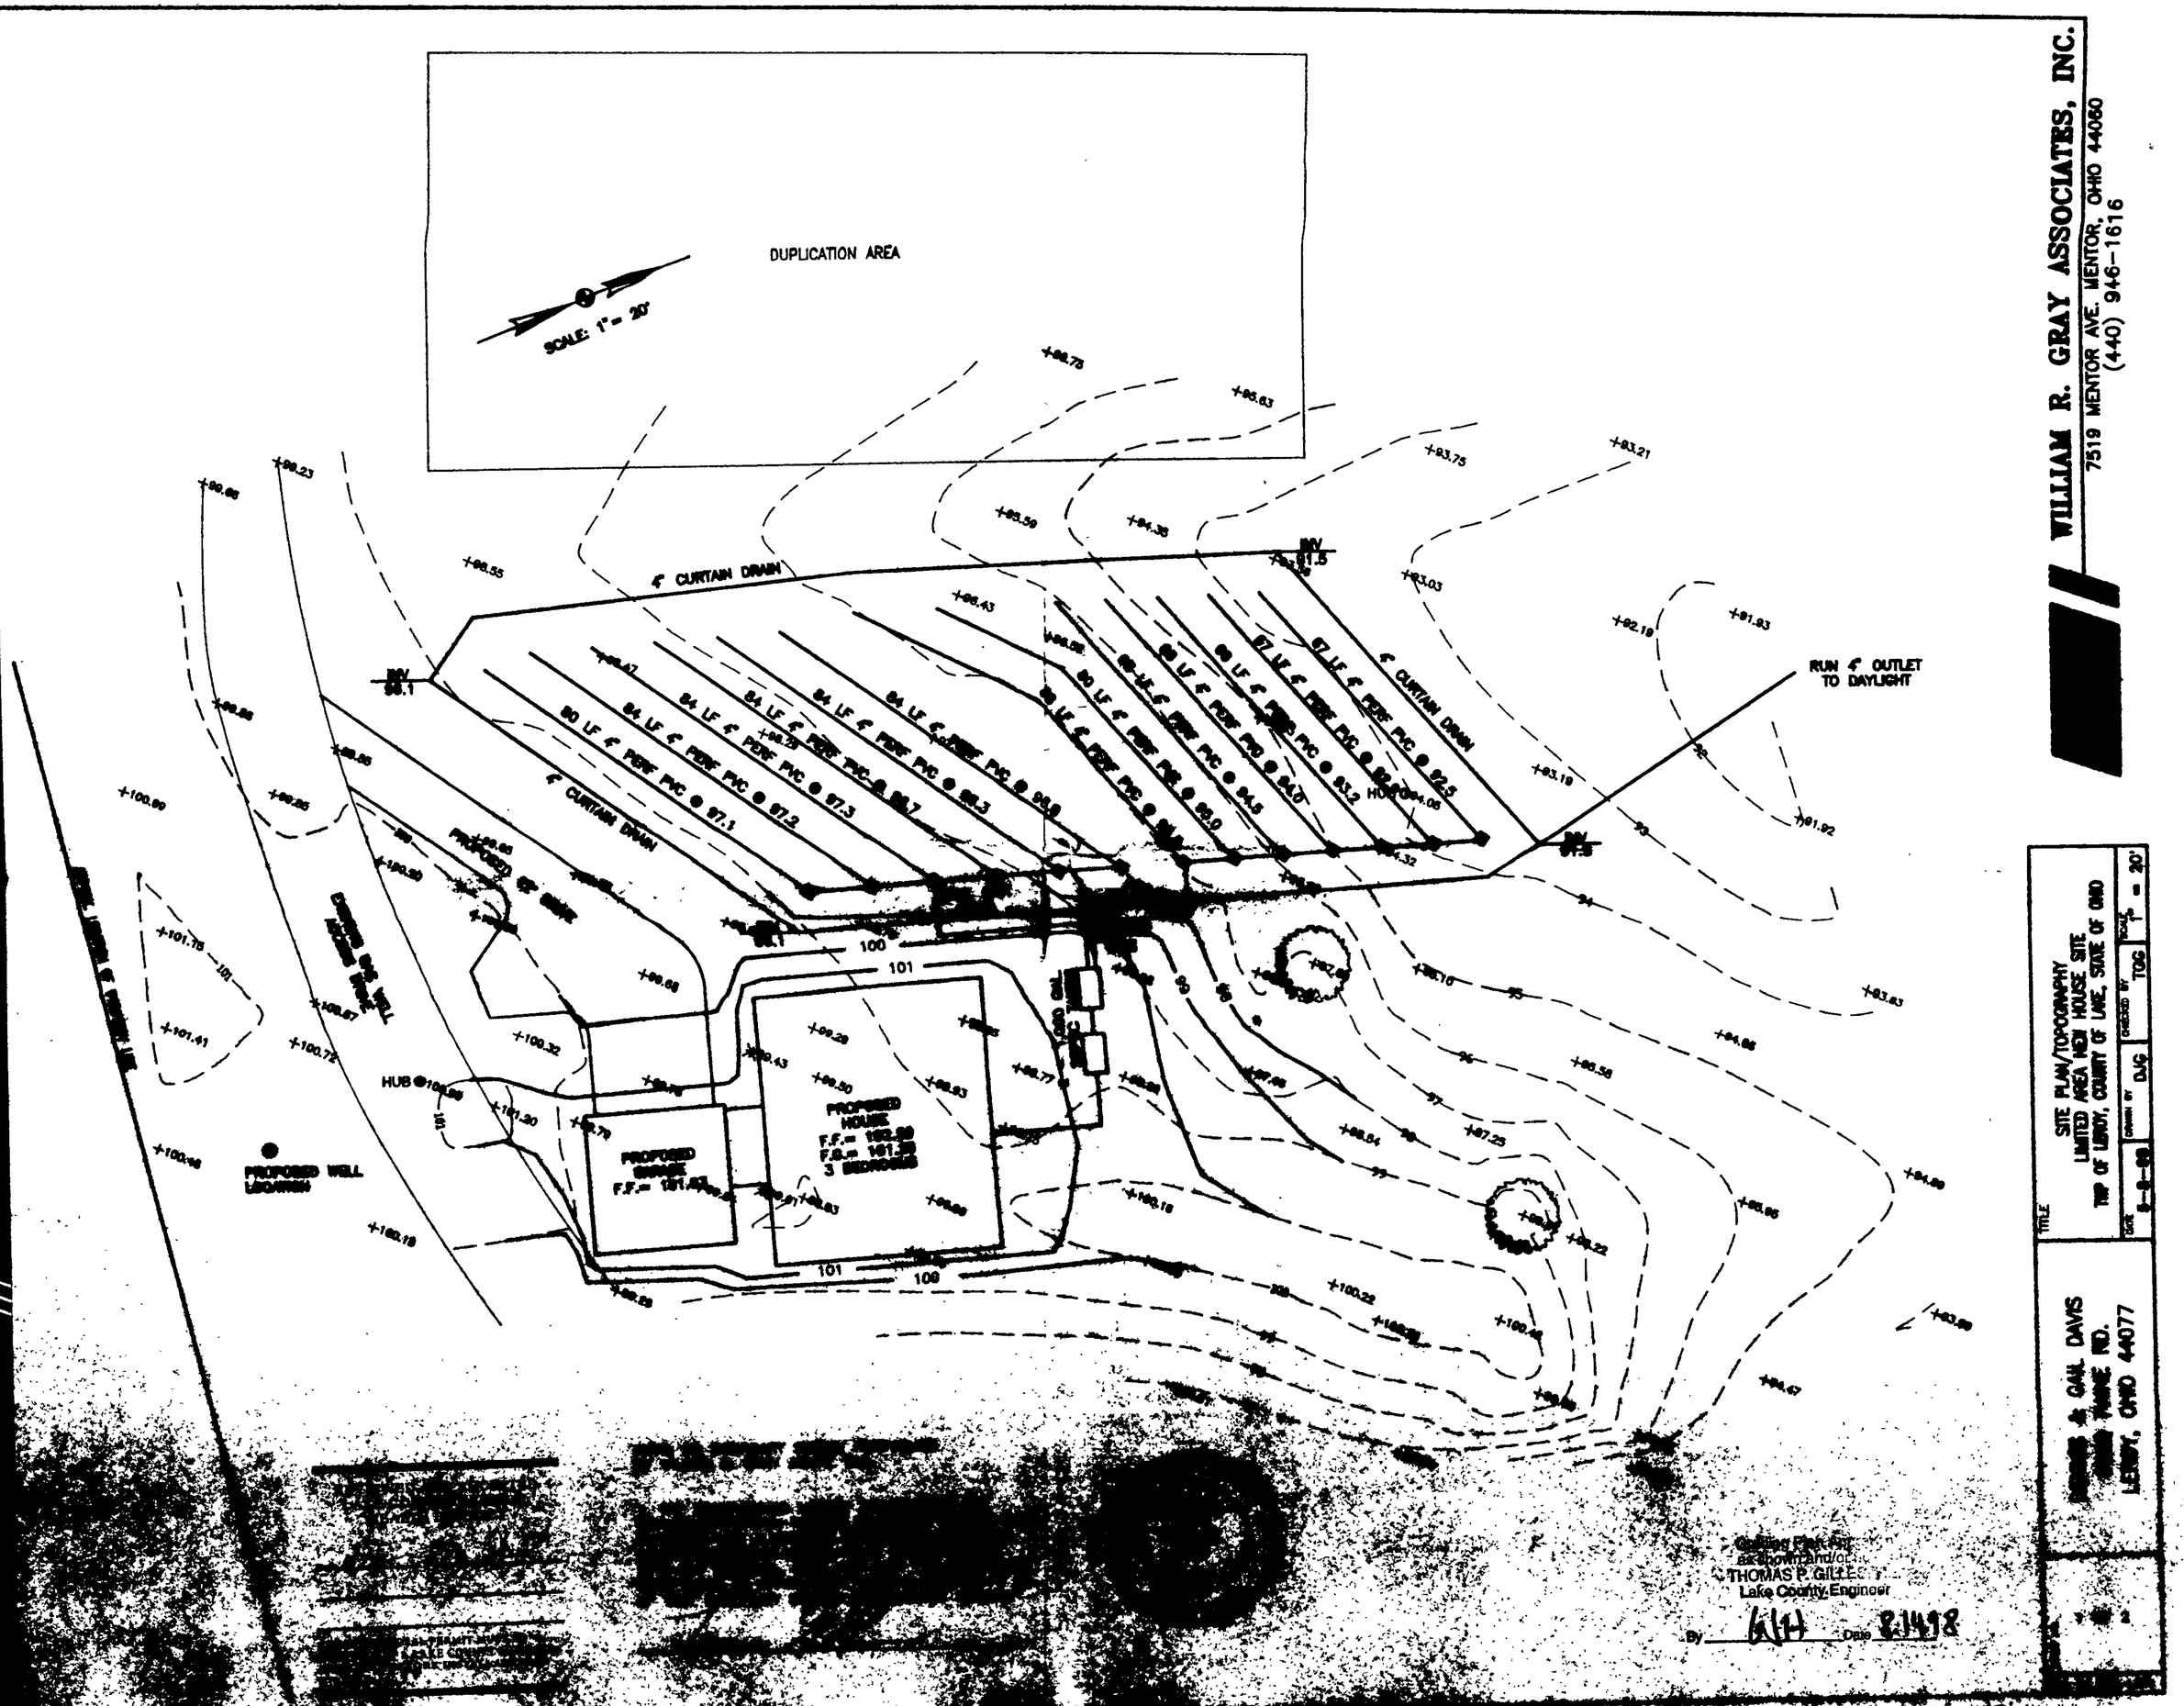

WILLIAM R. GRAY ASSOCIATES, INC.
7519 MENTOR AVENUE MENTOR, OHIO 44060 946-1616
WRG