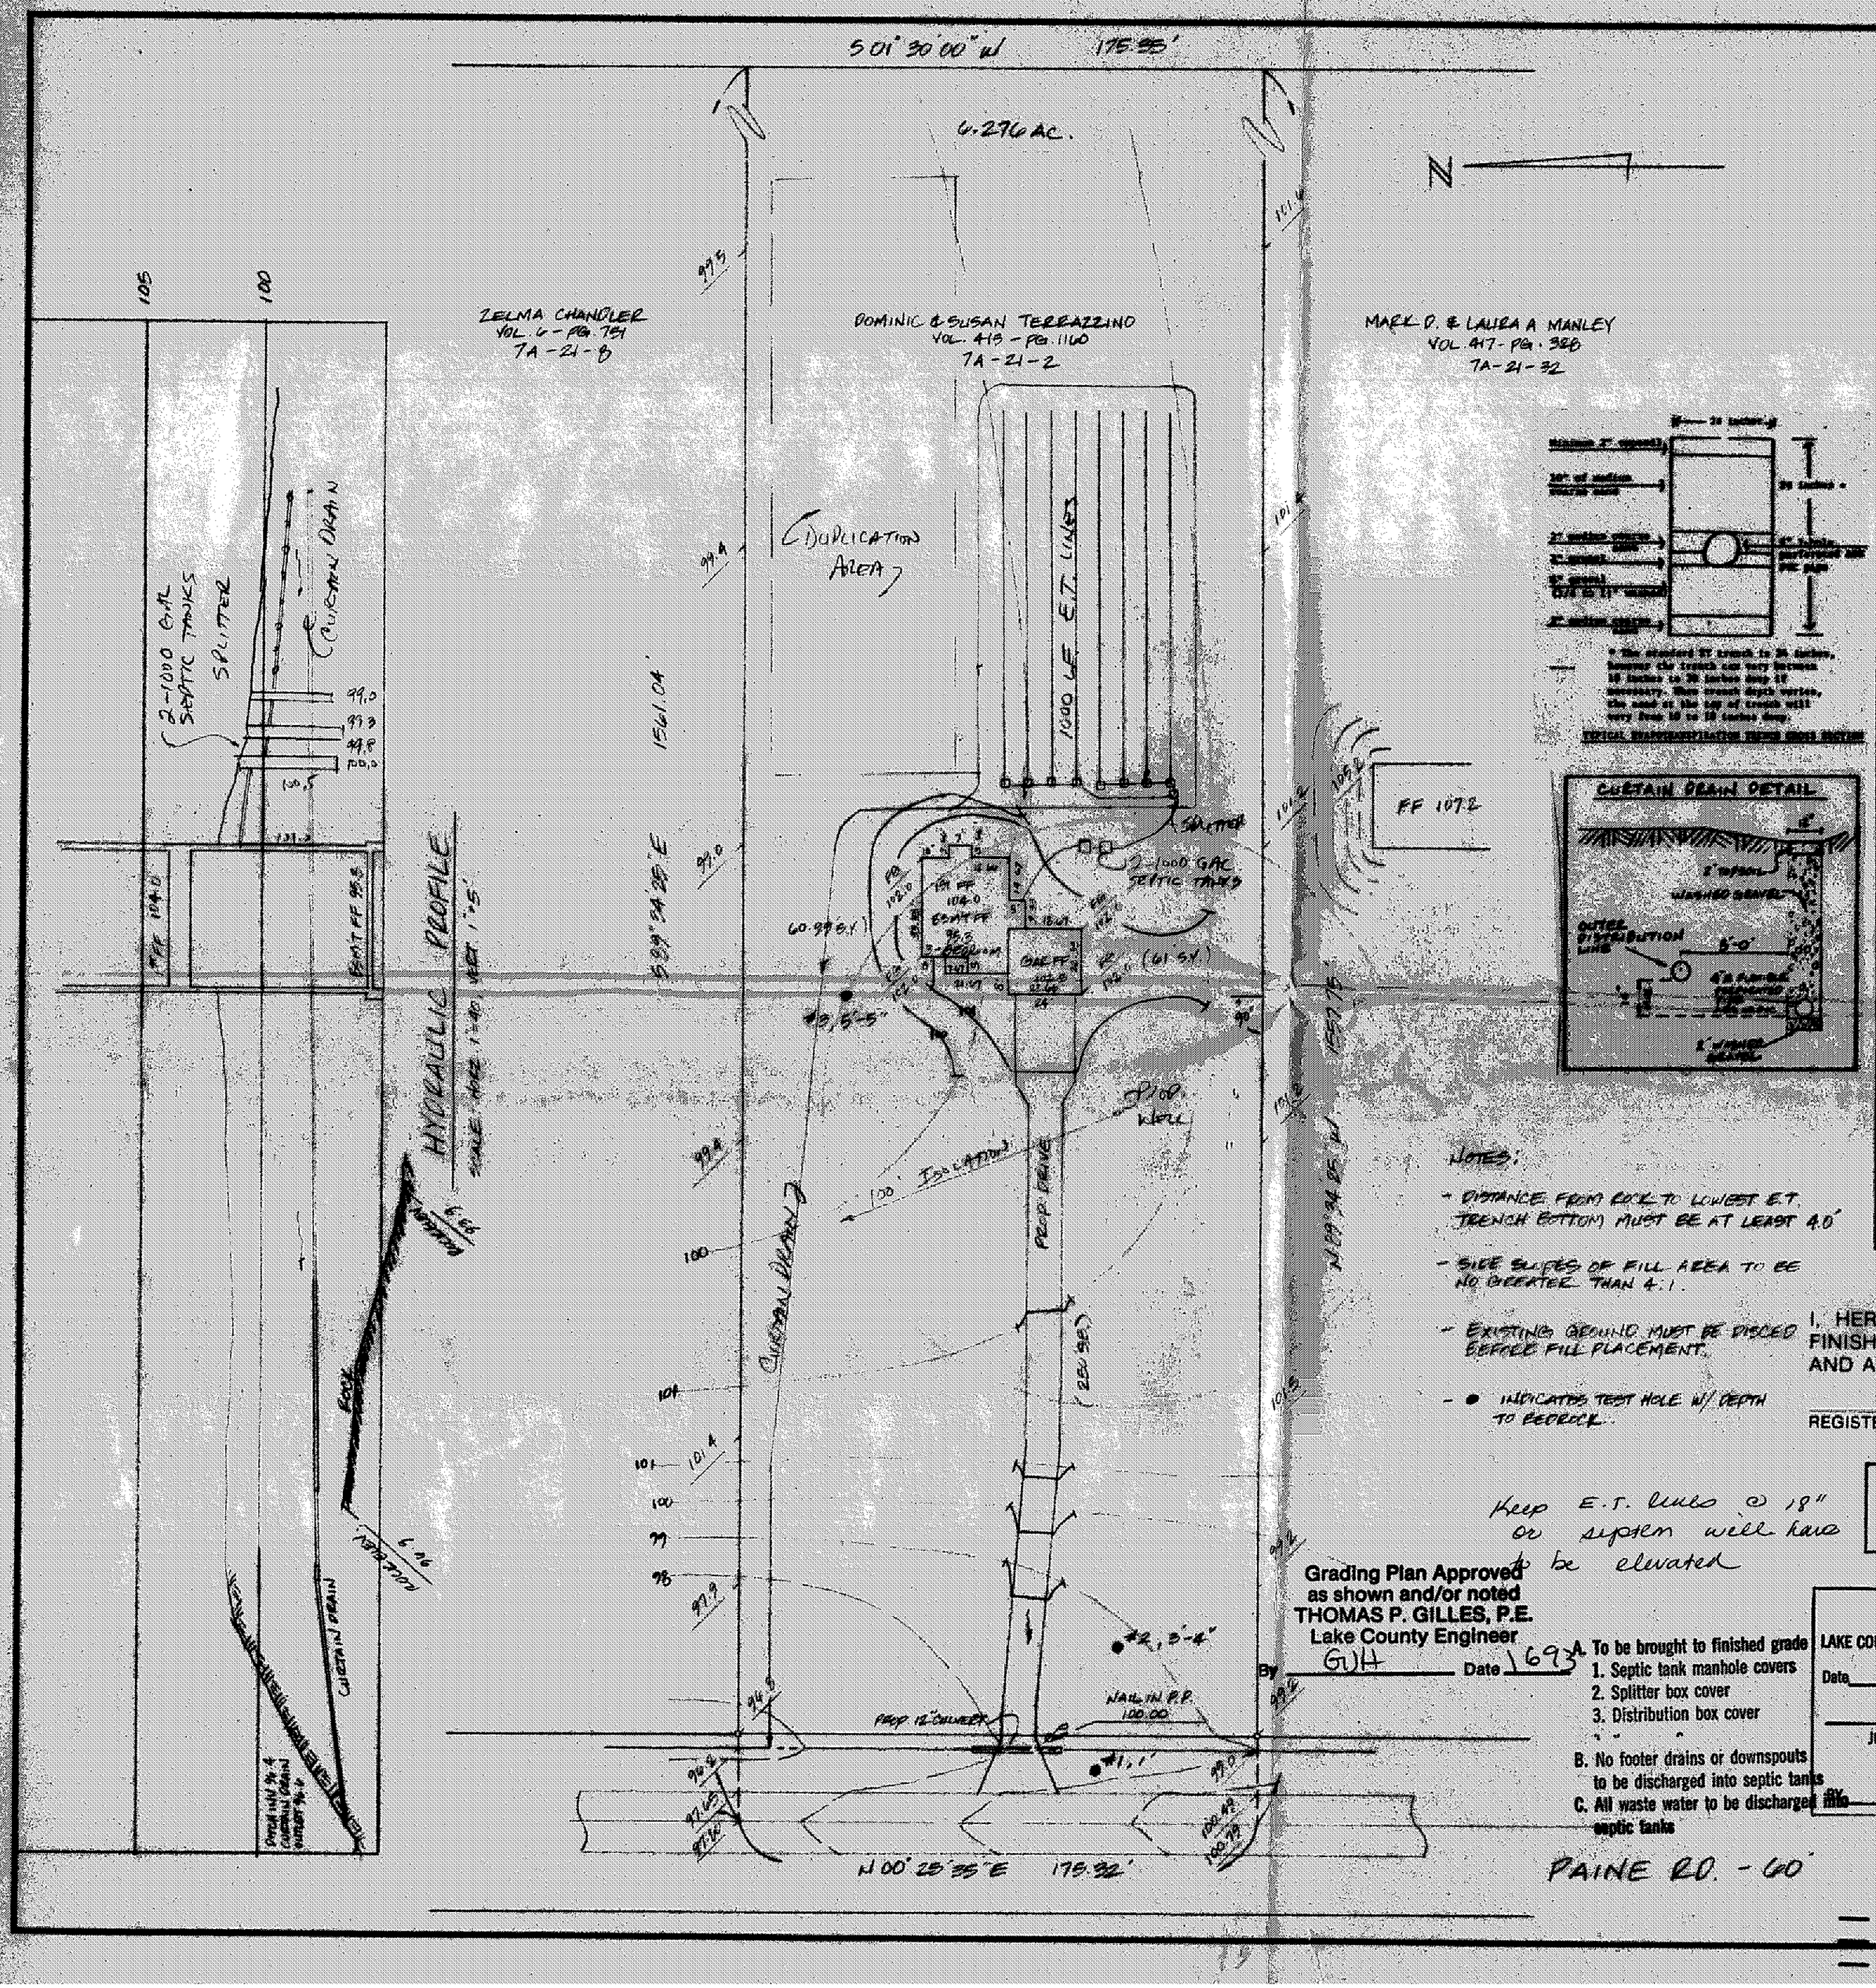

SITE PLAN

LEROY TWP., LAKE COUNTY, OHIO

for: DOMINIC TERRAZZINO 042-0077(W)
CLIENT OWNER

ADDRESS STREET CITY ZIP

SUBDIVISION NAME	LOT 415 / TRACT 1160
VOL. - PG.	VOLUME / PAGE
SUBLOT NO. STREET	PERM. PARCEL NO. 7A-21-2 / STREET PAINE RD

LEGEND

SANITARY MANHOLE
STORM MANHOLE
INLET OR CATCH BASIN
HYDRANT
EXISTING CONTOURS
PROPOSED CONTOURS
EXIST. ELEV. 100.0 / 100.0 PROP. ELEV.
WATER VALVE (GAS)
WATER METER (GAS)
AS BUILT ELEVATION 100.0
INDICATES DIRECTION OF SURFACE DRAINAGE

REMARKS

ALL BOUNDARY DATA SHOWN WAS OBTAINED FROM (DEEDS, RECORDED SUBDIVISION PLAT OR OTHER PUBLIC RECORDS)

LOCATIONS AS SHOWN OF ADJACENT WELLS AND SEPTIC TANKS OBTAINED FROM LAKE COUNTY HEALTH DEPARTMENT

DESIGN CERTIFICATION

THIS PLAT WAS PREPARED BY ME, AND IS CORRECT TO THE BEST OF MY KNOWLEDGE AND BELIEF.

NAME SURVEYOR REGISTRATION NO.

CHECK LIST

NO. OF BEDROOMS
DIMENSIONS
BEARINGS
TIE TO NEAREST STREET
SUBLOT NO. PARCEL NO.
SURROUNDING OWNERS
BLDG. DIMENSIONS FIN. GR.
BLDG. TIES FL'R. GRADES
APRON TYPE WIDTH THICKNESS
SIDEWALK TYPE WIDTH THICKNESS
CULVERT TYPE DIA. LENGTH
ROCK OUTCROPPINGS

WATER MAIN SIZE, LOCATION
SAN. SEWER SIZE % GR. LOC.
SAN. MH. CAST. ELEV. INV. ELEV.
SAN. CONN. SIZE, LOC. DEPTH
STORM SEWER SIZE % GR. LOC.
STORM MH. CAST. ELEV. INV. ELEV.
PAV'T. TYPE GRADE CURBS
GAS LINE LOC. SIZE PRESSURE
SEPTIC TANK LOCATION & DUPLICATION AREA
WELL LOCATION
ISOLATION RADIUS FROM WELL

REVISIONS		
NO.	DATE	BY
1	11-12-92	MP
2		
3		
4		
5		

PLAN PREPARED BY:
BABCOCK • JONES & ASSOCIATES, INC.
PAINESVILLE, OHIO

DRAWN BY	SCALE 1" = 40'	PHONE NO. 357-1811	
CHK'D.	DATE 11-2-92	DRAWING NO. 92-211	
CREW CHIEF	APP'D.		

NOTES:

- DISTANCE FROM ROCK TO LOWEST E.T. TRENCH BOTTOM MUST BE AT LEAST 4.0'
- SIDE SLOPES OF FILL AREA TO BE NO GREATER THAN 4:1.
- EXISTING GROUND MUST BE DISCED BEFORE FILL PLACEMENT.
- ● INDICATES TEST HOLE W/ DEPTH TO BEDROCK.

Keep E.T. lines @ 18" or system will have to be elevated

Grading Plan Approved as shown and/or noted
THOMAS P. GILLES, P.E.
Lake County Engineer
By GJH Date 1693

A. To be brought to finished grade
1. Septic tank manhole covers
2. Splitter box cover
3. Distribution box cover
B. No footer drains or downspouts to be discharged into septic tanks
C. All waste water to be discharged into septic tanks

PAINE RD. - 60'

Reviewed and Accepted
LAKE COUNTY GENERAL HEALTH DISTRICT
Date 11.12.92
JOEL LUCIA, R. S., M. P. H.
Health Commissioner
By Nancy Nieves

LOW YIELD WATER FIXTURES REQUIRED ON ALL:
___ Shower Head
___ Toilet
___

"AS BUILT" CERTIFICATION

I, HEREBY CERTIFY THAT THE CIRCLED GRADES ARE EXISTING FINISH GRADES CHECKED IN THE FIELD ON _____, 19__ AND ARE CORRECT TO THE BEST OF MY KNOWLEDGE AND BELIEF.

REGISTERED SURVEYOR REG. NO.

SEWAGE DISPOSAL PERMIT MUST BE OBTAINED BY A LAKE COUNTY LICENSED INSTALLER BEFORE INSTALLATION IS STARTED.

STATE OF OHIO
HARRY S. JONES, JR.
6343

LEROY TOWNSHIP
Zoning Appr.
1989
Zoning Inspector

"I, the undersigned hereby certify that this topography indicated by 6", 1' or 2' contours, and elevations shown hereon represent an actual field survey made by me on the 3rd day of Oct., 19 92 and that the elevations were taken at appropriate intervals and that as of that date they existed as indicated hereon."

#6343
Reg. No.