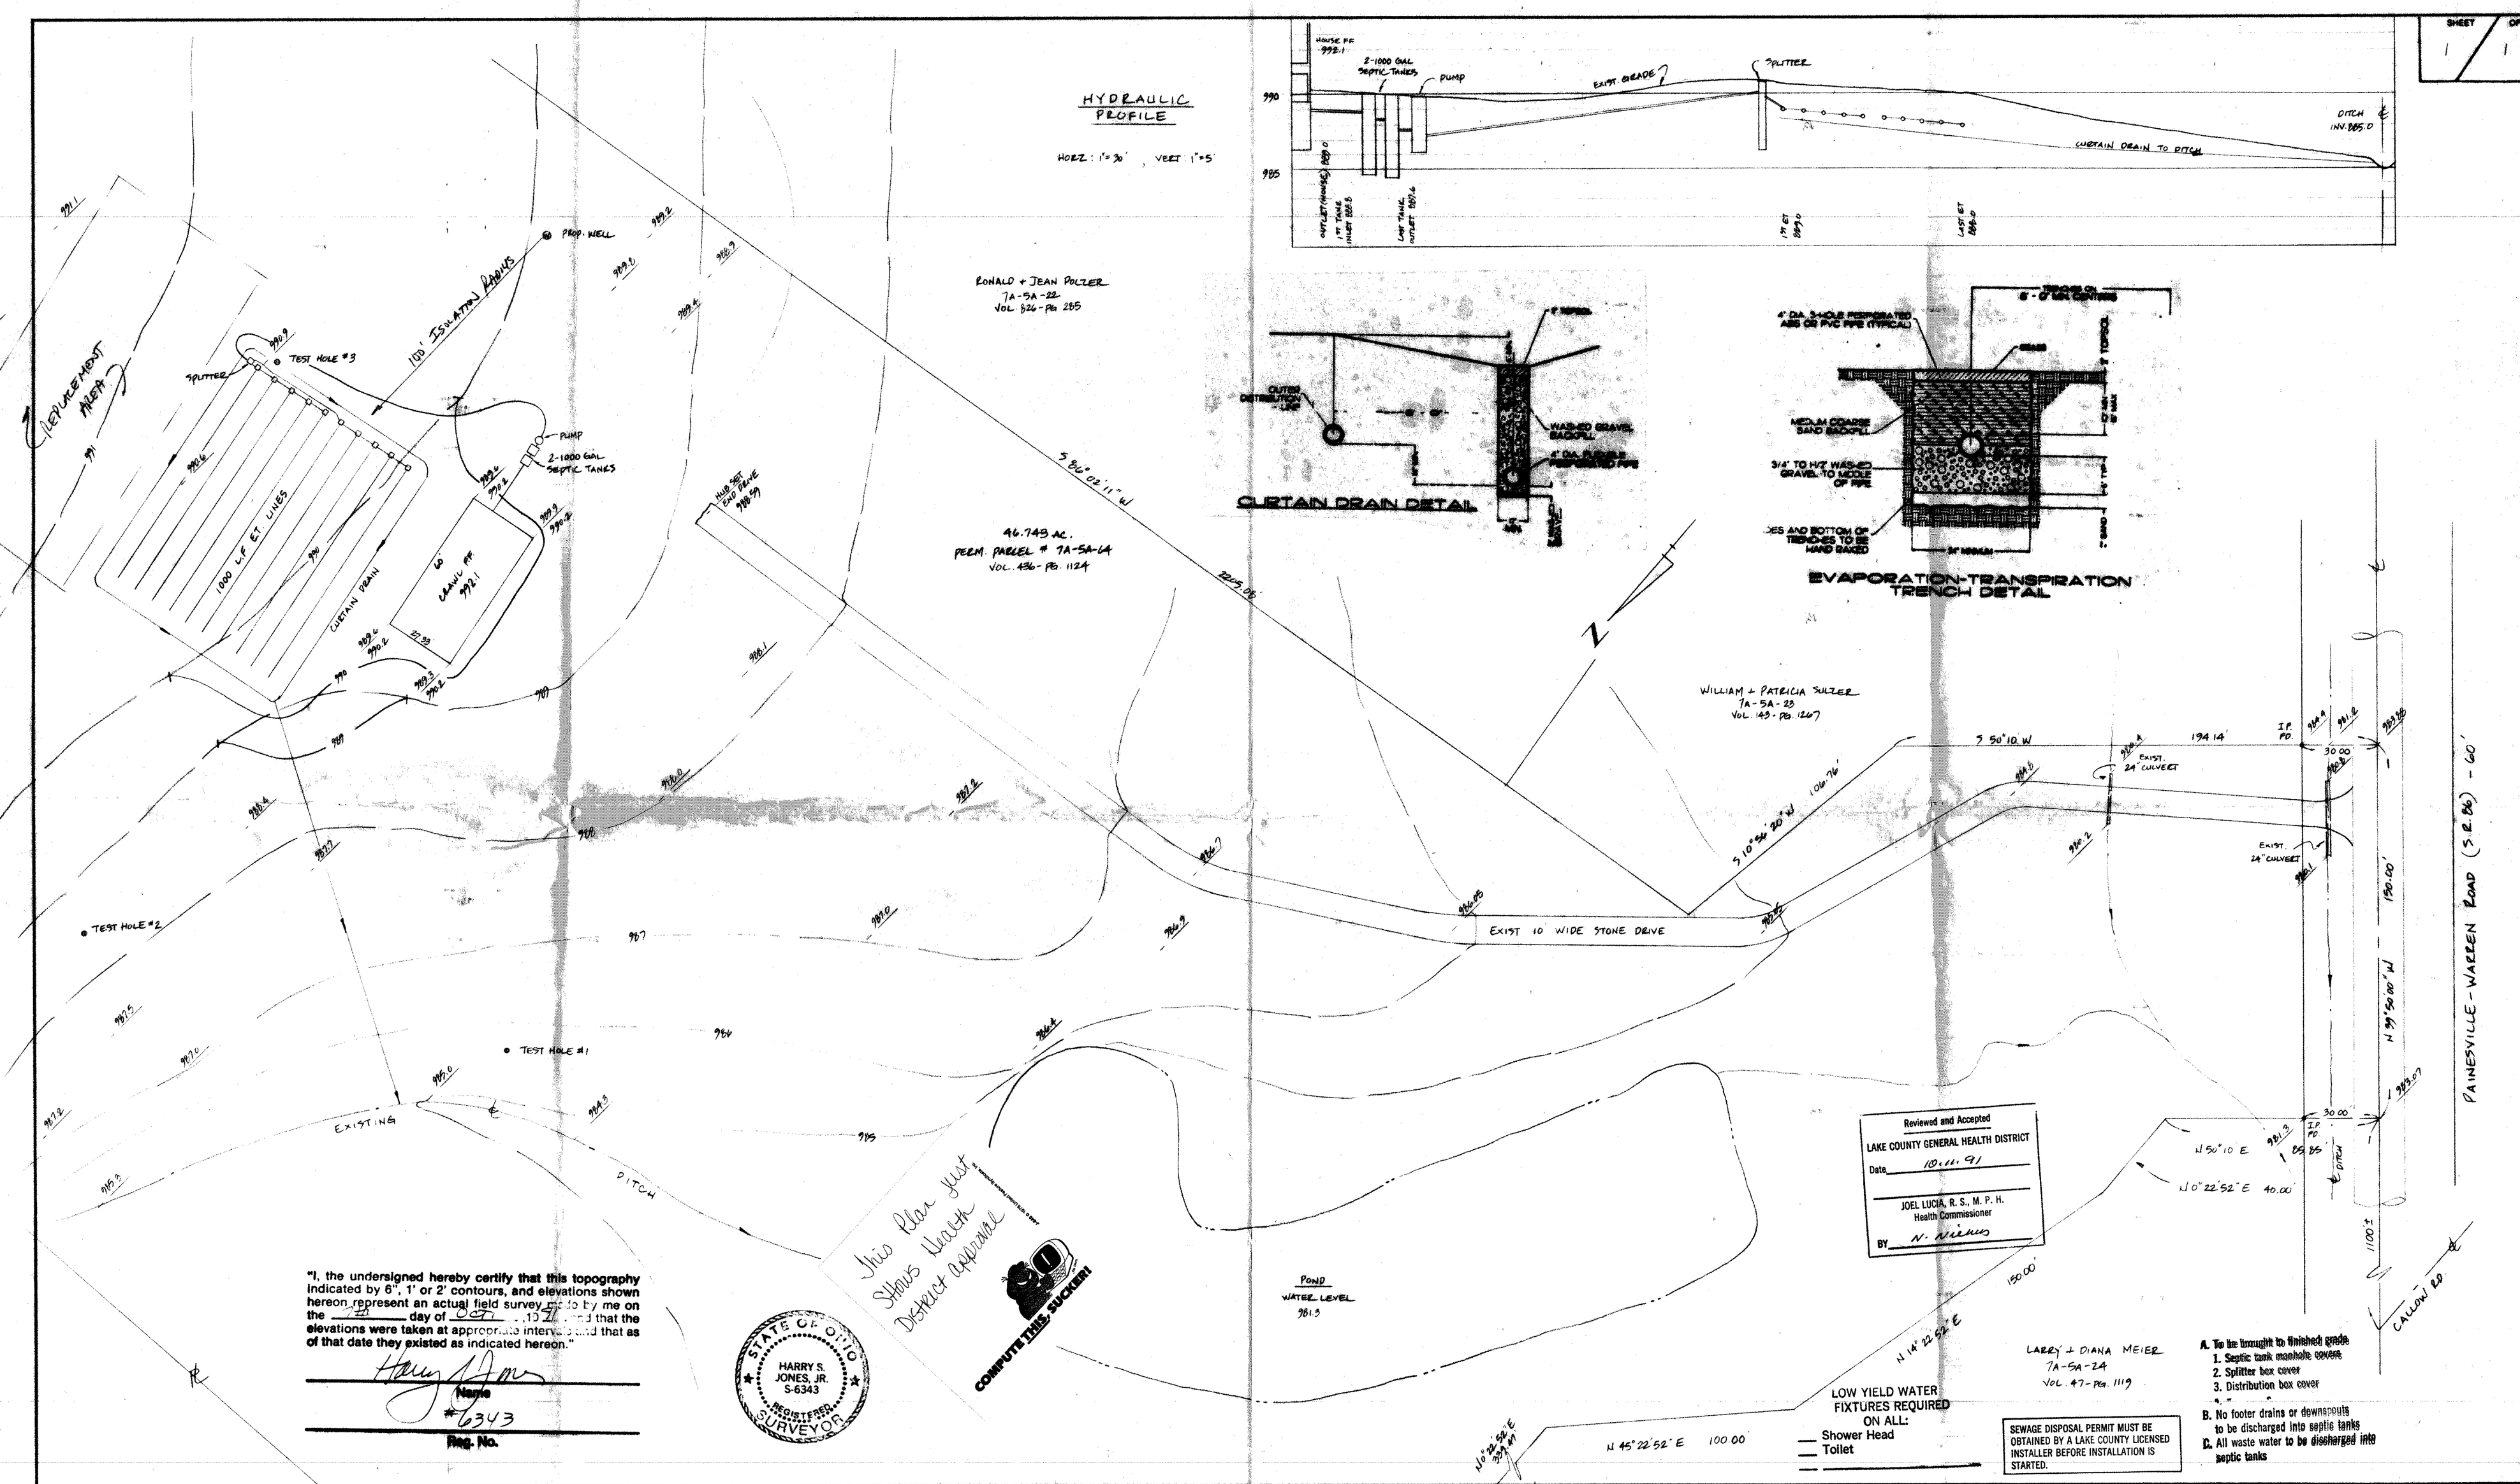

REV NO.	DESCRIPTION	DATE	BY	CHK'D

SITE PLAN
FOR
JAMES KUNSMAN

BABCOCK, JONES AND ASSOCIATES, INC
CIVIL ENGINEERS - SURVEYORS - LAND PLANNERS
PAINESVILLE OHIO 44077

DATE	OCTOBER 1991
DESIGN BY	HJ
DRAWN BY	℄
APPROVED BY	HJ

BEING A PART OF LOT NOS. 21, 22, + 23
PERM. PARCEL # 7A-5A-64 VOL 436 - PG 1124
LEROY TOWNSHIP, LAKE COUNTY, OHIO

SCALE	1"=30'
JOB NO	91-198
SHEET	1 OF 1