SITE PLAN
FOR
QUALITY HOMES

BEING SUBLOT No. 7 IN THE PINEY HOLLOW SUB'D., IN THE TOWNSHIP OF LEROY COUNTY OF LAKE, STATE OF OHIO.

SEWAGE DISPOSAL PERMIT MUST BE OBTAINED BY A LAKE COUNTY LICENSED INSTALLER BEFORE INSTALLATION IS STARTED.
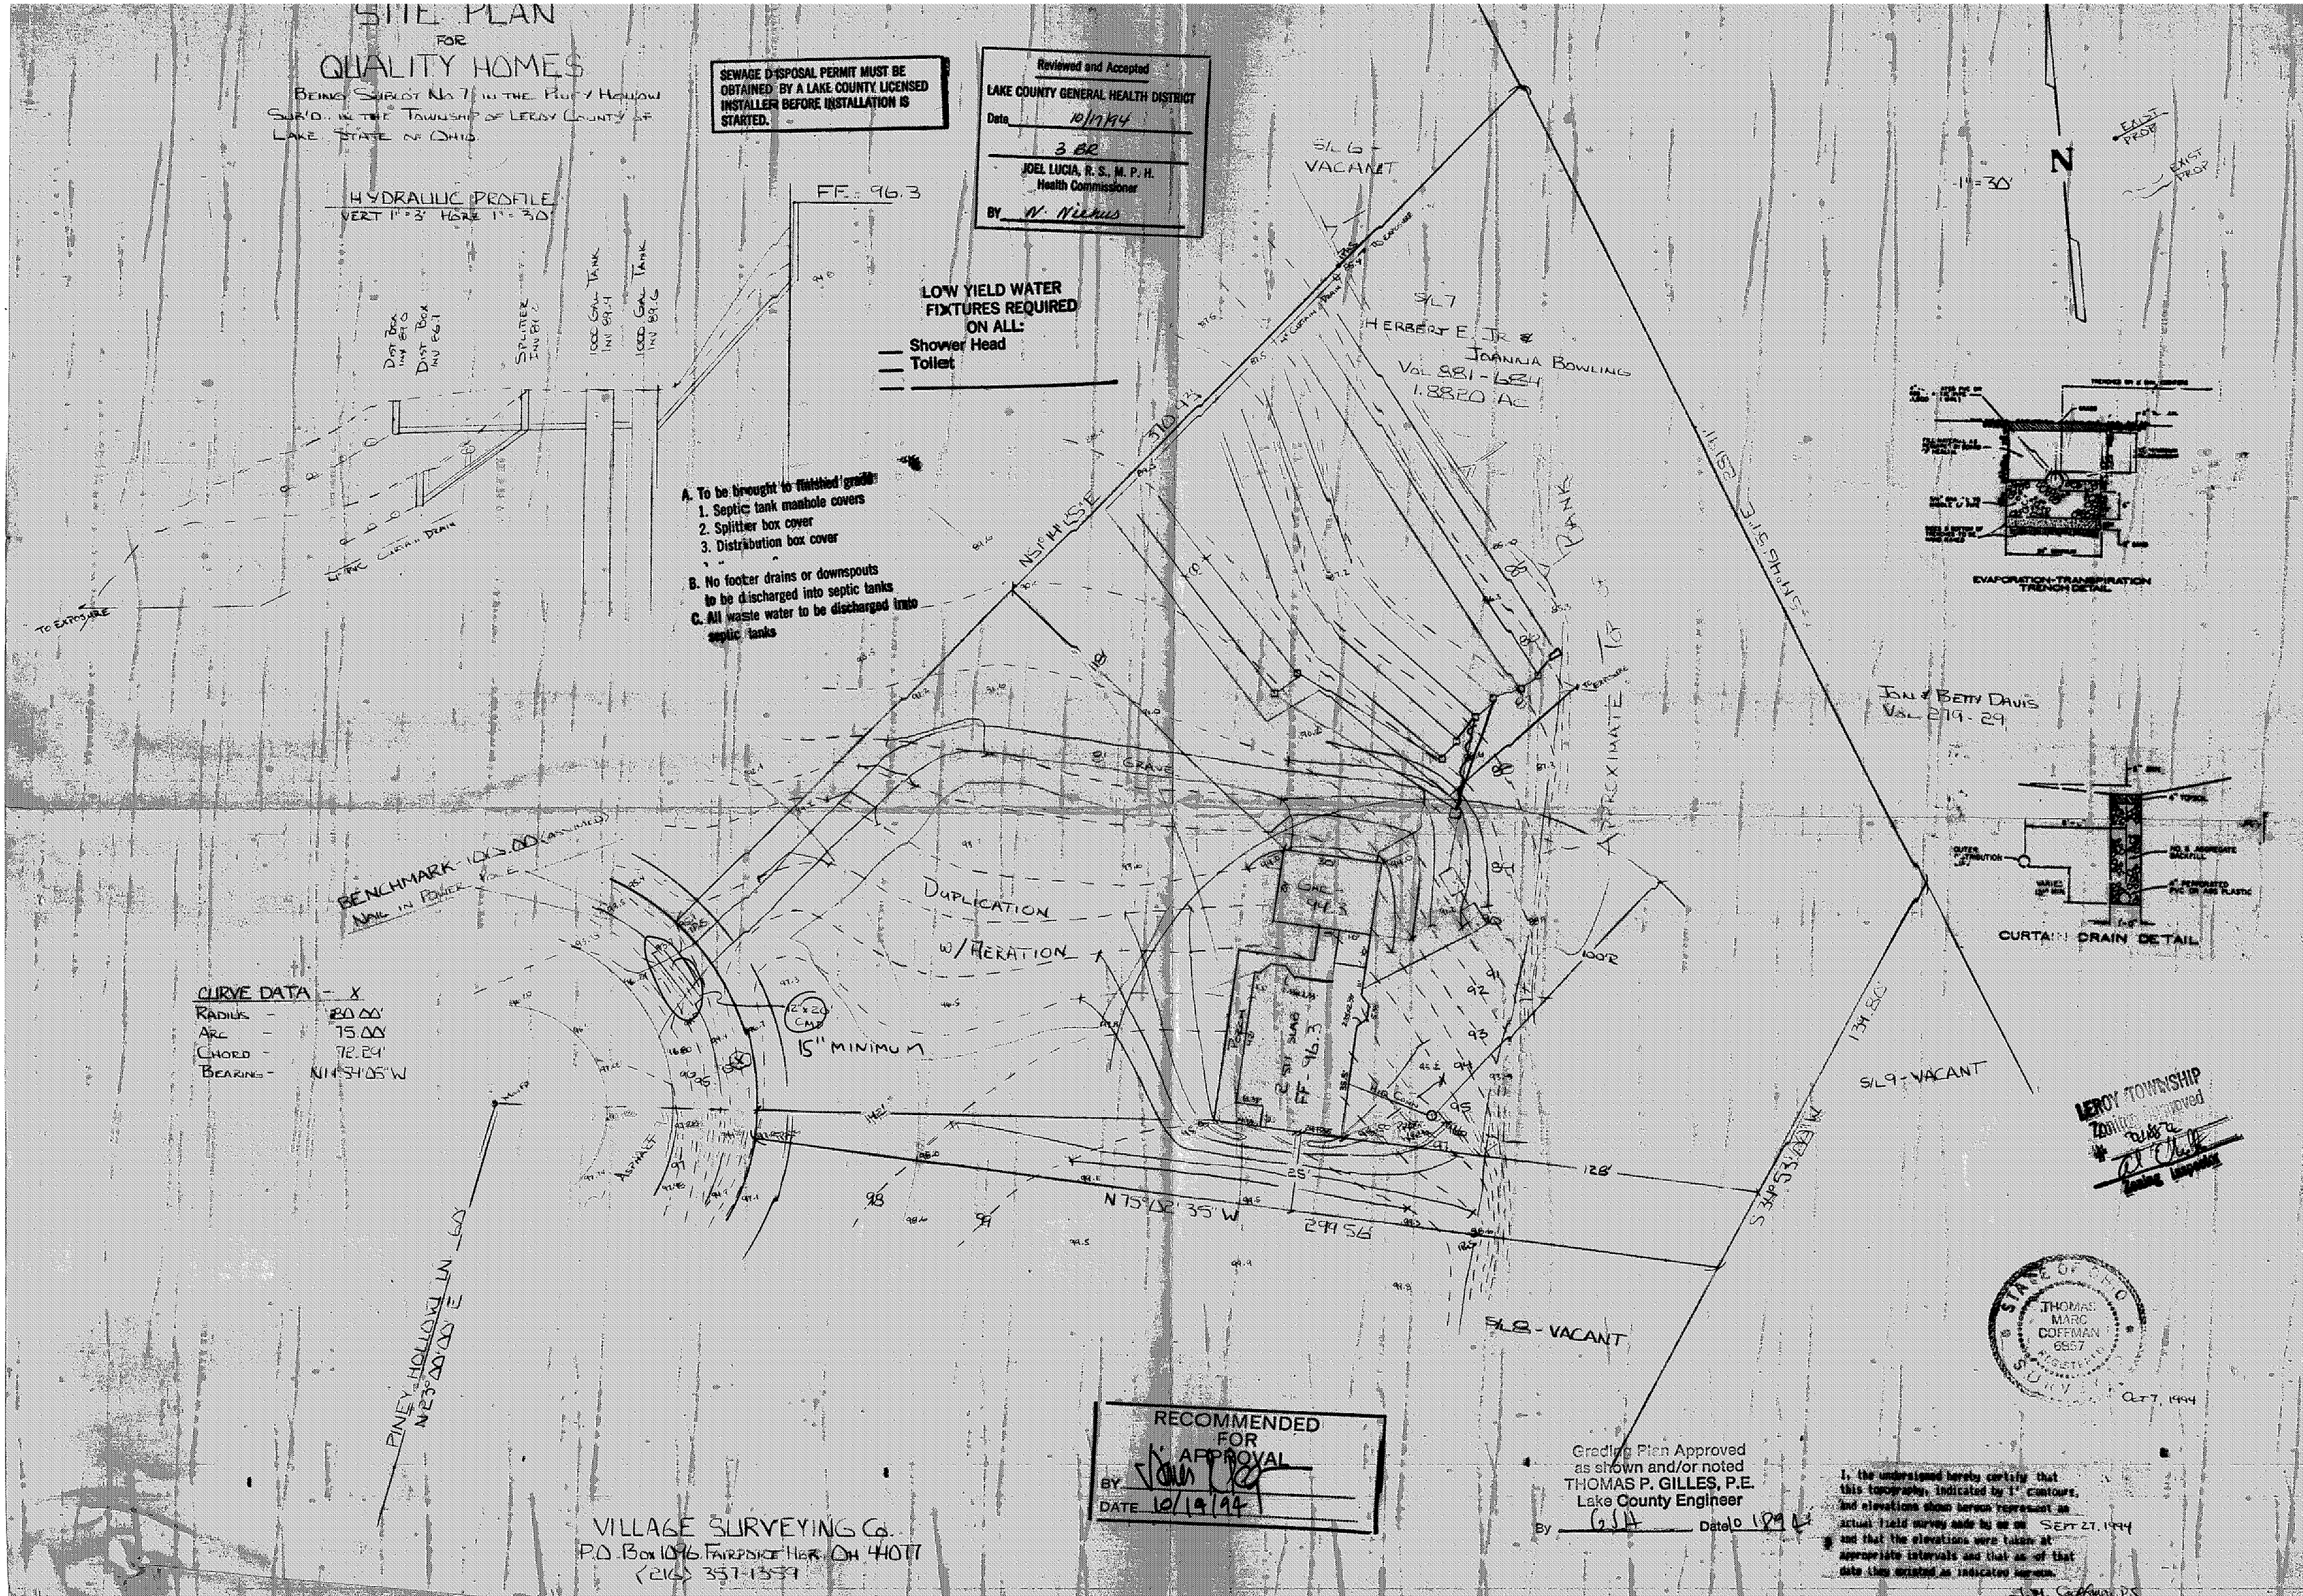
Reviewed and Accepted
LAKE COUNTY GENERAL HEALTH DISTRICT
Date 10/17/94
3 BR
JOEL LUCIA, R.S., M.P.H.
Health Commissioner
BY N. Nichols