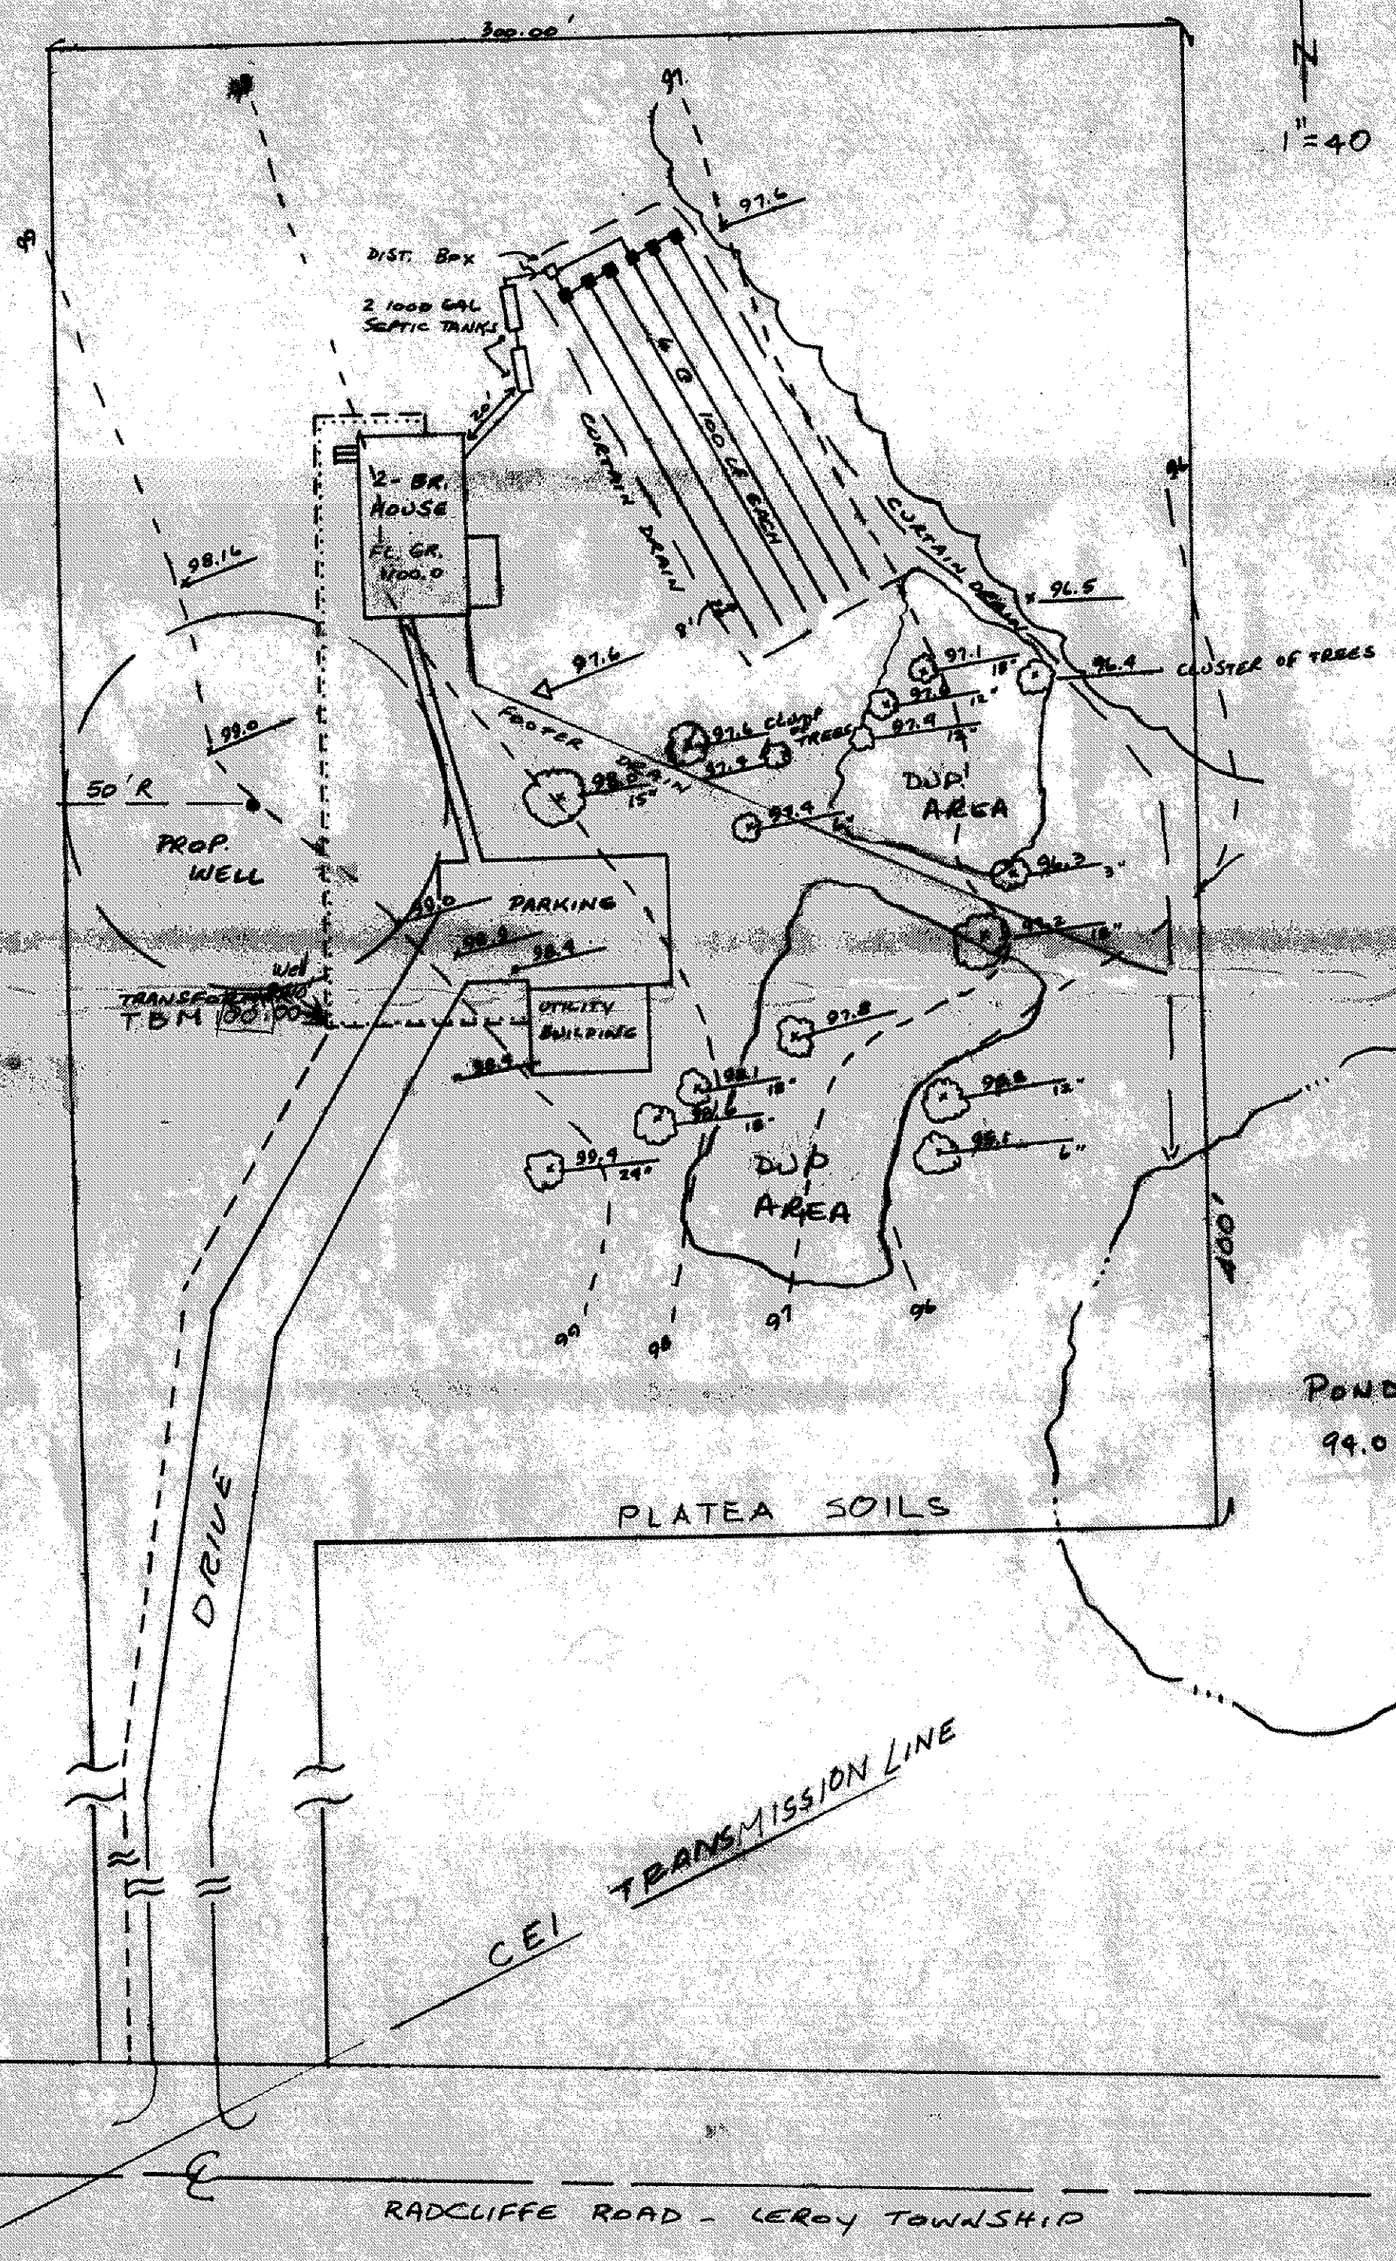

SEWAGE DISPOSAL PERMIT MUST BE OBTAINED BY A LAKE COUNTY LICENSED INSTALLER BEFORE INSTALLATION IS STARTED.

LOW YIELD WATER FIXTURES REQUIRED ON ALL:
— Shower Head
— Toilet
— _____

Reviewed and Accepted
LAKE COUNTY GENERAL HEALTH DISTRICT
Date 10-14-93
JOEL LUCIA, R. S., M. P. H.
Health Commissioner
BY J. Lindsay

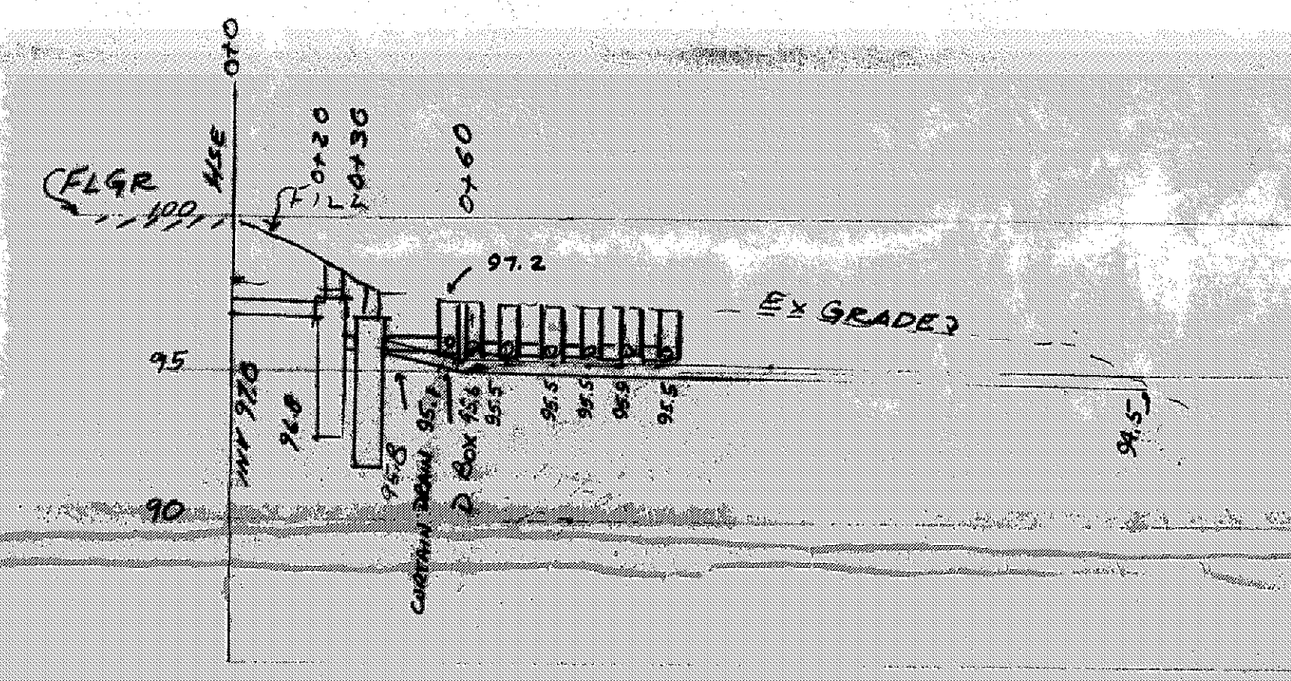

A. To be brought to finished grade
1. Septic tank manhole covers
2. Splitter box cover
3. Distribution box cover
B. No footer drains or downspouts to be discharged into septic tanks
C. All waste water to be discharged into septic tanks

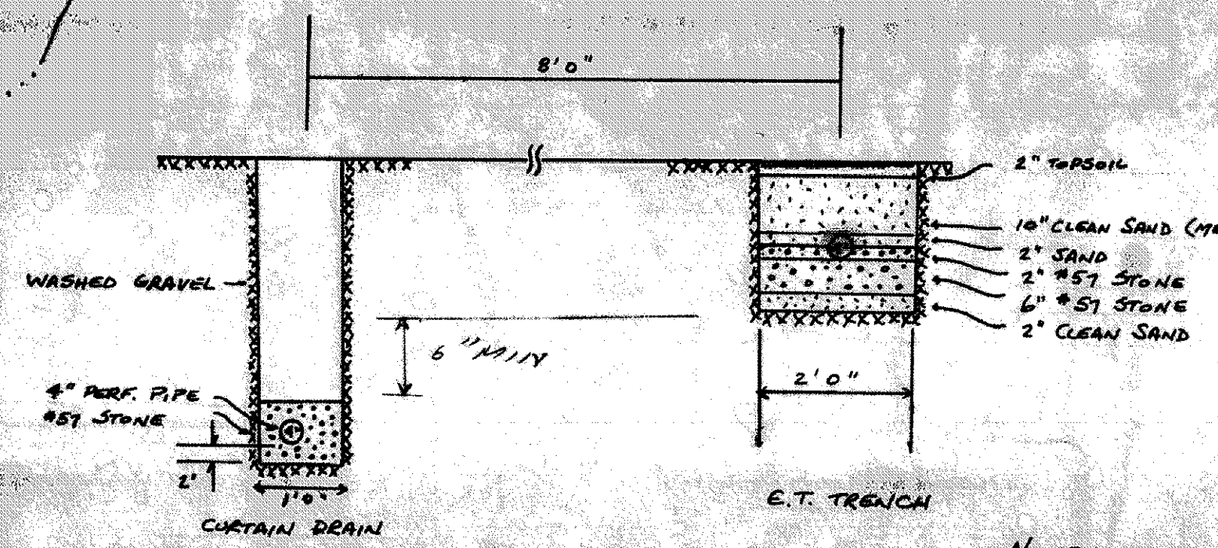

TYPICAL DETAIL
N.T.S.

Grading Plan Approved as shown and/or noted
THOMAS P. GILLES, P.E.
Lake County Engineer
By GLH Date 12-23-93

NOTE:
I, THE UNDERSIGNED ROGER M. NALL, HEREBY CERTIFY THAT THE TOPOGRAPHY SHOWN HEREON REPRESENTS AN ACTUAL FIELD TOPOGRAPHY SURVEY PERFORMED ON NOV. 23, 1993.
Roger M. Nall
CEI 12-9-93 CEI 12-3-93

STATE OF OHIO
ROGER M. NALL
20421
REGISTERED PROFESSIONAL ENGINEER

SITE PLAN for
13440 Radcliffe Rd MICHAEL T GRANTHAM
Rev 11/2/93 LOT #10 RADCLIFFE RD Leroy Twp

NALL & ASSOCIATES
Civil & Municipal Engineering
11993 RAVENNA ROAD • CHARDON, OHIO
216-286-3207