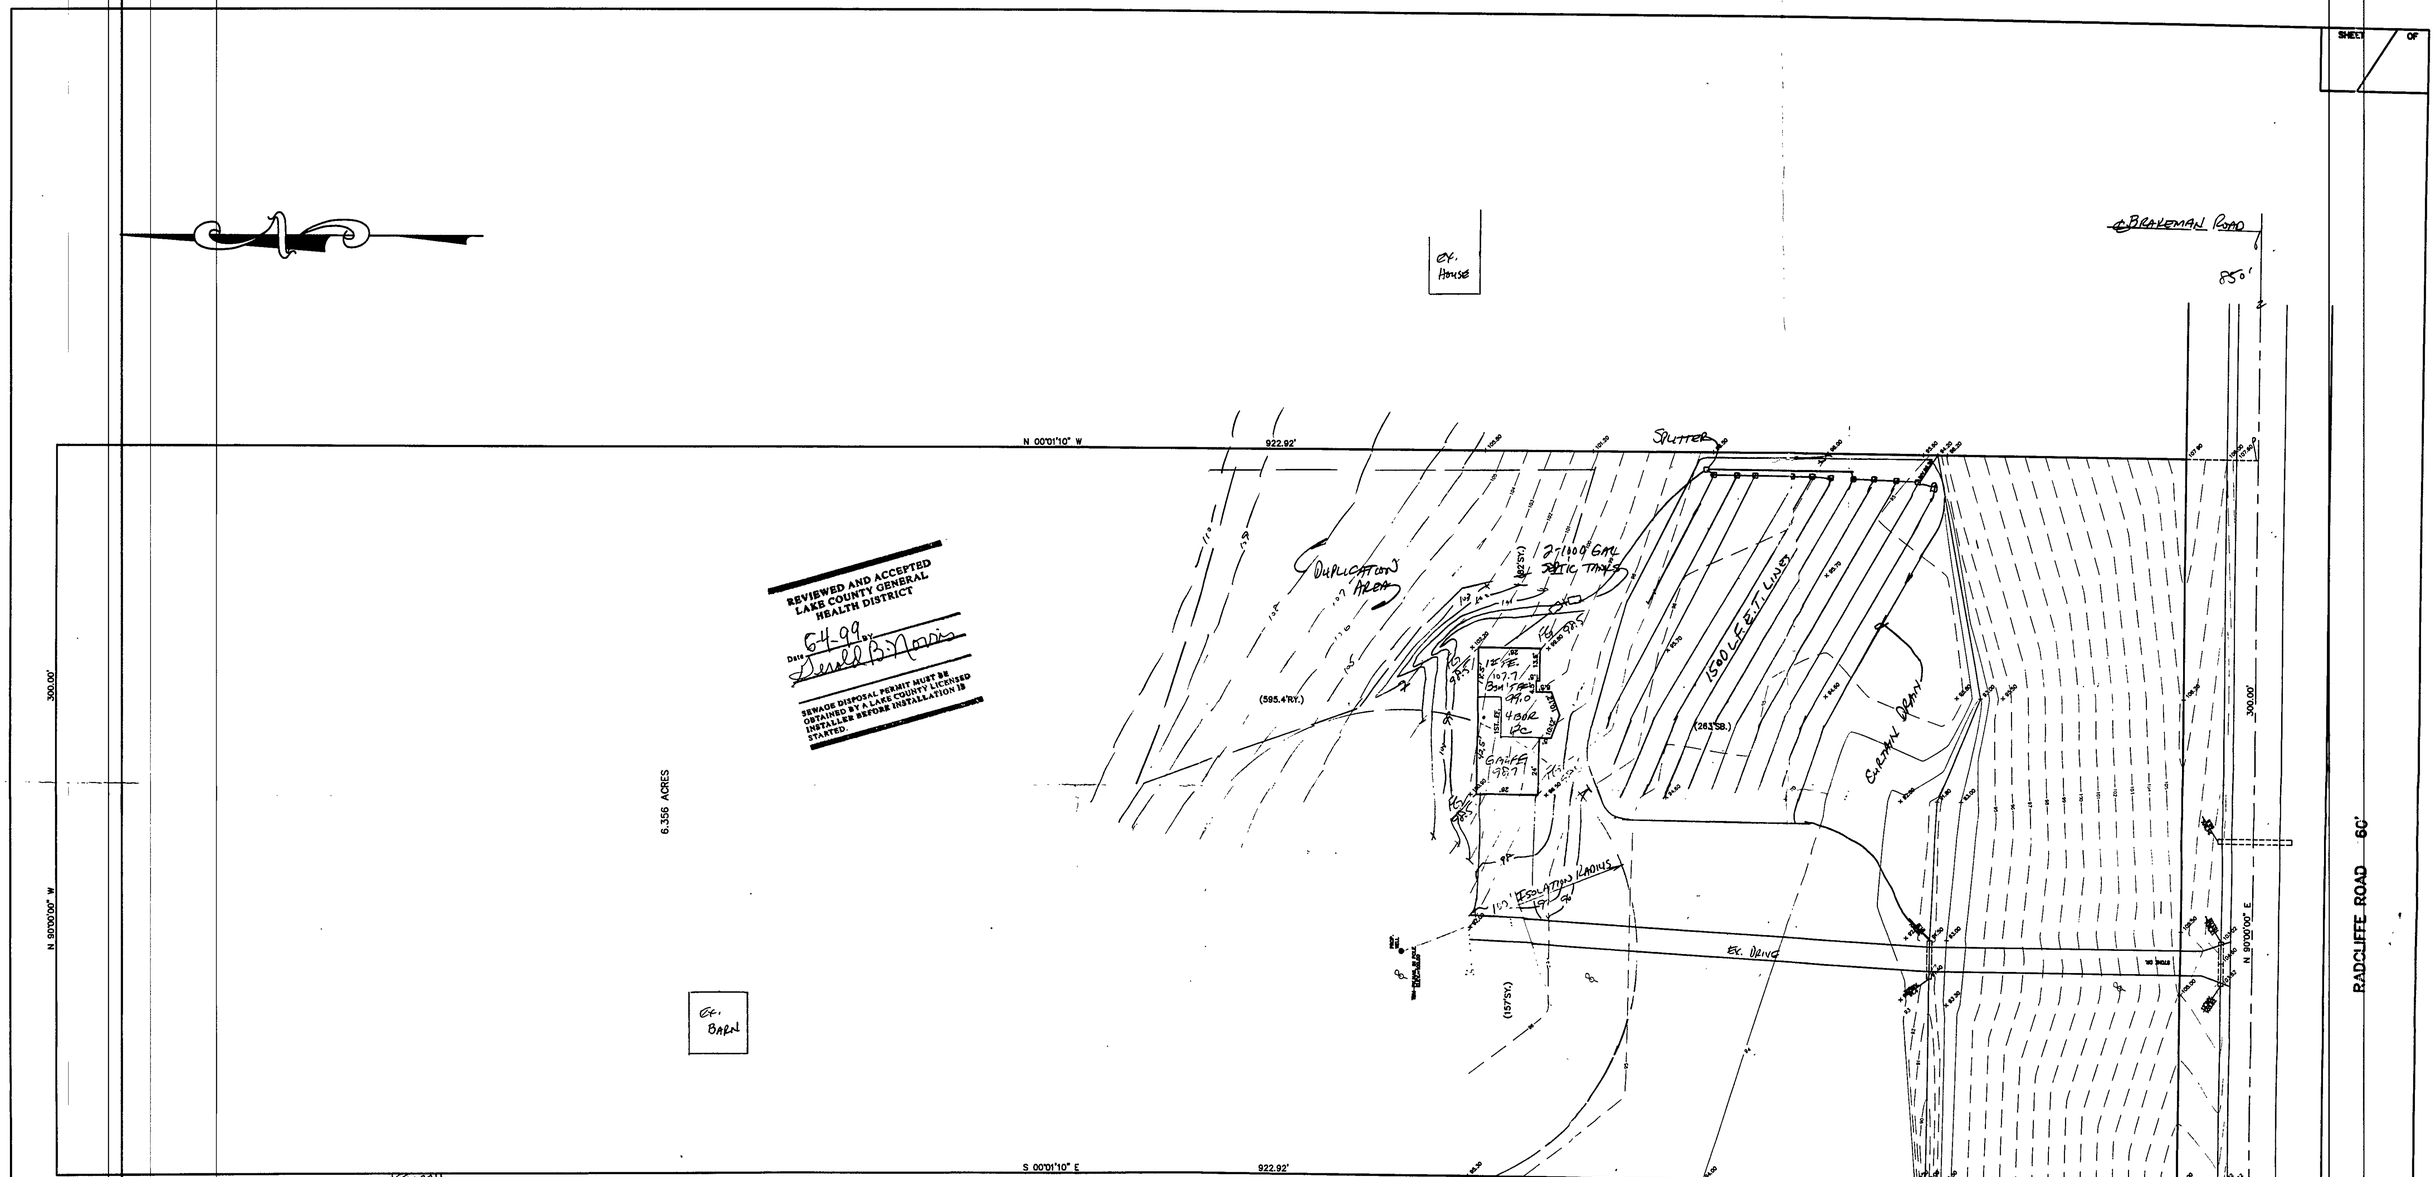


| REV NO. | DESCRIPTION | DATE | BY | CHK'D |
|---|---|---|---|---|
| 1 | REVISED SEPTIC | 6-3-99 | HJ | TR |

BABCOCK, JONES AND ASSOCIATES, INC
CIVIL ENGINEERS – SURVEYORS – LAND PLANNERS
PAINESVILLE OHIO 44077

| | |
|---|---|
| DATE | 7/10/98 |
| DESIGN BY | H.J. |
| DRAWN BY | T.R. |
| APPROVED BY | H.J. |

SITE PLAN
FOR
JOE JANEK
RADCLIFFE RD. LEROY TWP. LAKE COUNTY

| | |
|---|---|
| SCALE | 1"=30' |
| JOB NO | 98-215 |
| SHEET | 1 OF 1 |