SITE PLAN

LEROY TWP., LAKE COUNTY, OHIO

for: CIANFAGLIONE BUILDERS
CLIENT — OWNER

ADDRESS — STREET — CITY — ZIP

HIGHLAND TRAIL SUB. — SUBDIVISION NAME	LOT — TRACT
VOL. 24 VOL. 30	VOLUME — PAGE
10 — SUBLOT NO.	RUSTIC DRIVE — STREET
PERM. PARCEL NO.	STREET

LEGEND

SANITARY MANHOLE
STORM MANHOLE
INLET OR CATCH BASIN
HYDRANT
EXISTING CONTOURS
PROPOSED CONTOURS
EXIST. ELEV. 100.0 — 100.0 PROP. ELEV.
WATER VALVE (GAS)
WATER METER (GAS)
AS BUILT ELEVATION 100.0
INDICATES DIRECTION OF SURFACE DRAINAGE

REMARKS

ALL BOUNDARY DATA SHOWN WAS OBTAINED FROM (DEEDS, RECORDED SUBDIVISION PLAT OR OTHER PUBLIC RECORDS)

LOCATIONS AS SHOWN OF ADJACENT WELLS AND SEPTIC TANKS OBTAINED FROM LAKE COUNTY HEALTH DEPARTMENT

DESIGN CERTIFICATION

THIS PLAT WAS PREPARED BY ME, AND IS CORRECT TO THE BEST OF MY KNOWLEDGE AND BELIEF.

NAME — SURVEYOR — REGISTRATION NO. P.S. 6528

CHECK LIST

NO. OF BEDROOMS
DIMENSIONS
BEARINGS
TIE TO NEAREST STREET
SUBLOT NO. PARCEL NO.
SURROUNDING OWNERS
BLDG. DIMENSIONS FIN. GR.
BLDG. TIES FL'R. GRADES
APRON TYPE WIDTH THICKNESS
SIDEWALK TYPE WIDTH THICKNESS
CULVERT TYPE DIA., LENGTH
ROCK OUTCROPPINGS

WATER MAIN SIZE, LOCATION
SAN. SEWER SIZE % GR. LOC.
SAN. MH. CAST. ELEV. INV. ELEV.
SAN. CONN. SIZE, LOC. DEPTH
STORM SEWER SIZE % GR. LOC.
STORM MH. CAST ELEV. INV. ELEV.
PAV'T TYPE GRADE CURBS
GAS LINE LOC. SIZE PRESSURE
SEPTIC TANK LOCATION & DUPLICATION AREA
WELL LOCATION
ISOLATION RADIUS FROM WELL

REVISIONS		
NO.	DATE	BY
1	8/1/92	HP
2	3/22/93	HP
3	3-26-93	[illegible]
4		
5		

PLAN PREPARED BY:
BABCOCK • JONES & ASSOCIATES, INC.
PAINESVILLE, OHIO

DRAWN BY [illegible]	SCALE 1" = 40'	PHONE NO. 357-1811
CHK'D. HP	DATE 7-31-92	DRAWING NO. 86-133-10
CREW CHIEF WB	APP'D. HP	

 

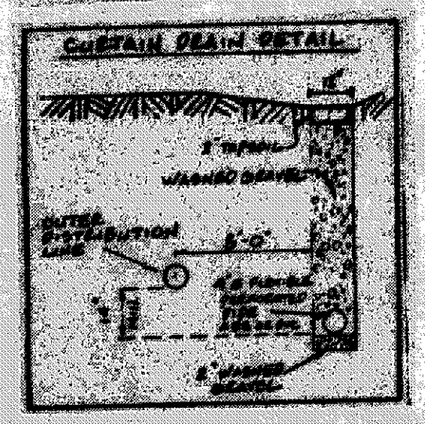

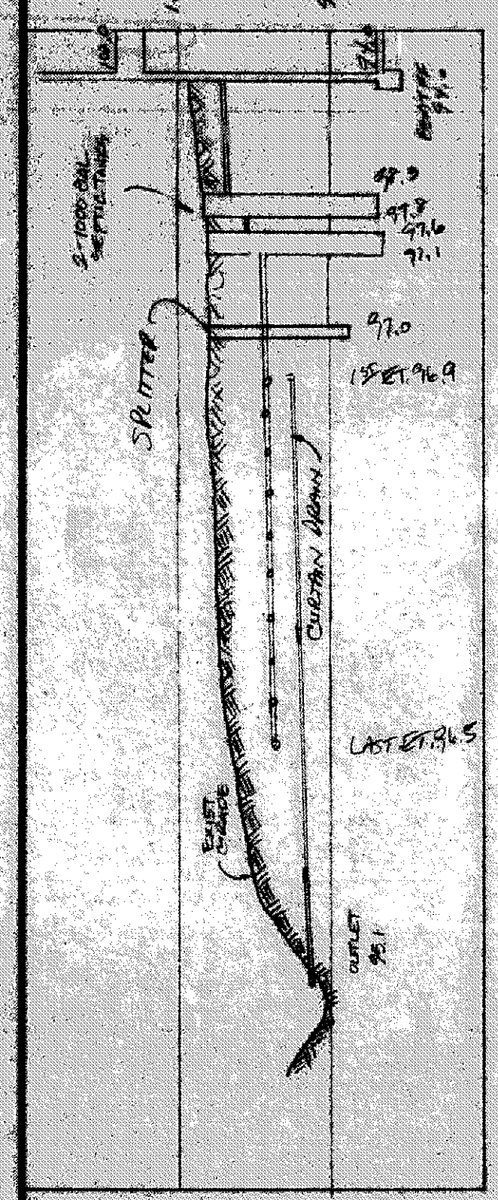

HYDRAULIC PROFILE
SCALE: HORZ. 1"=30', VERT. 1"=5'

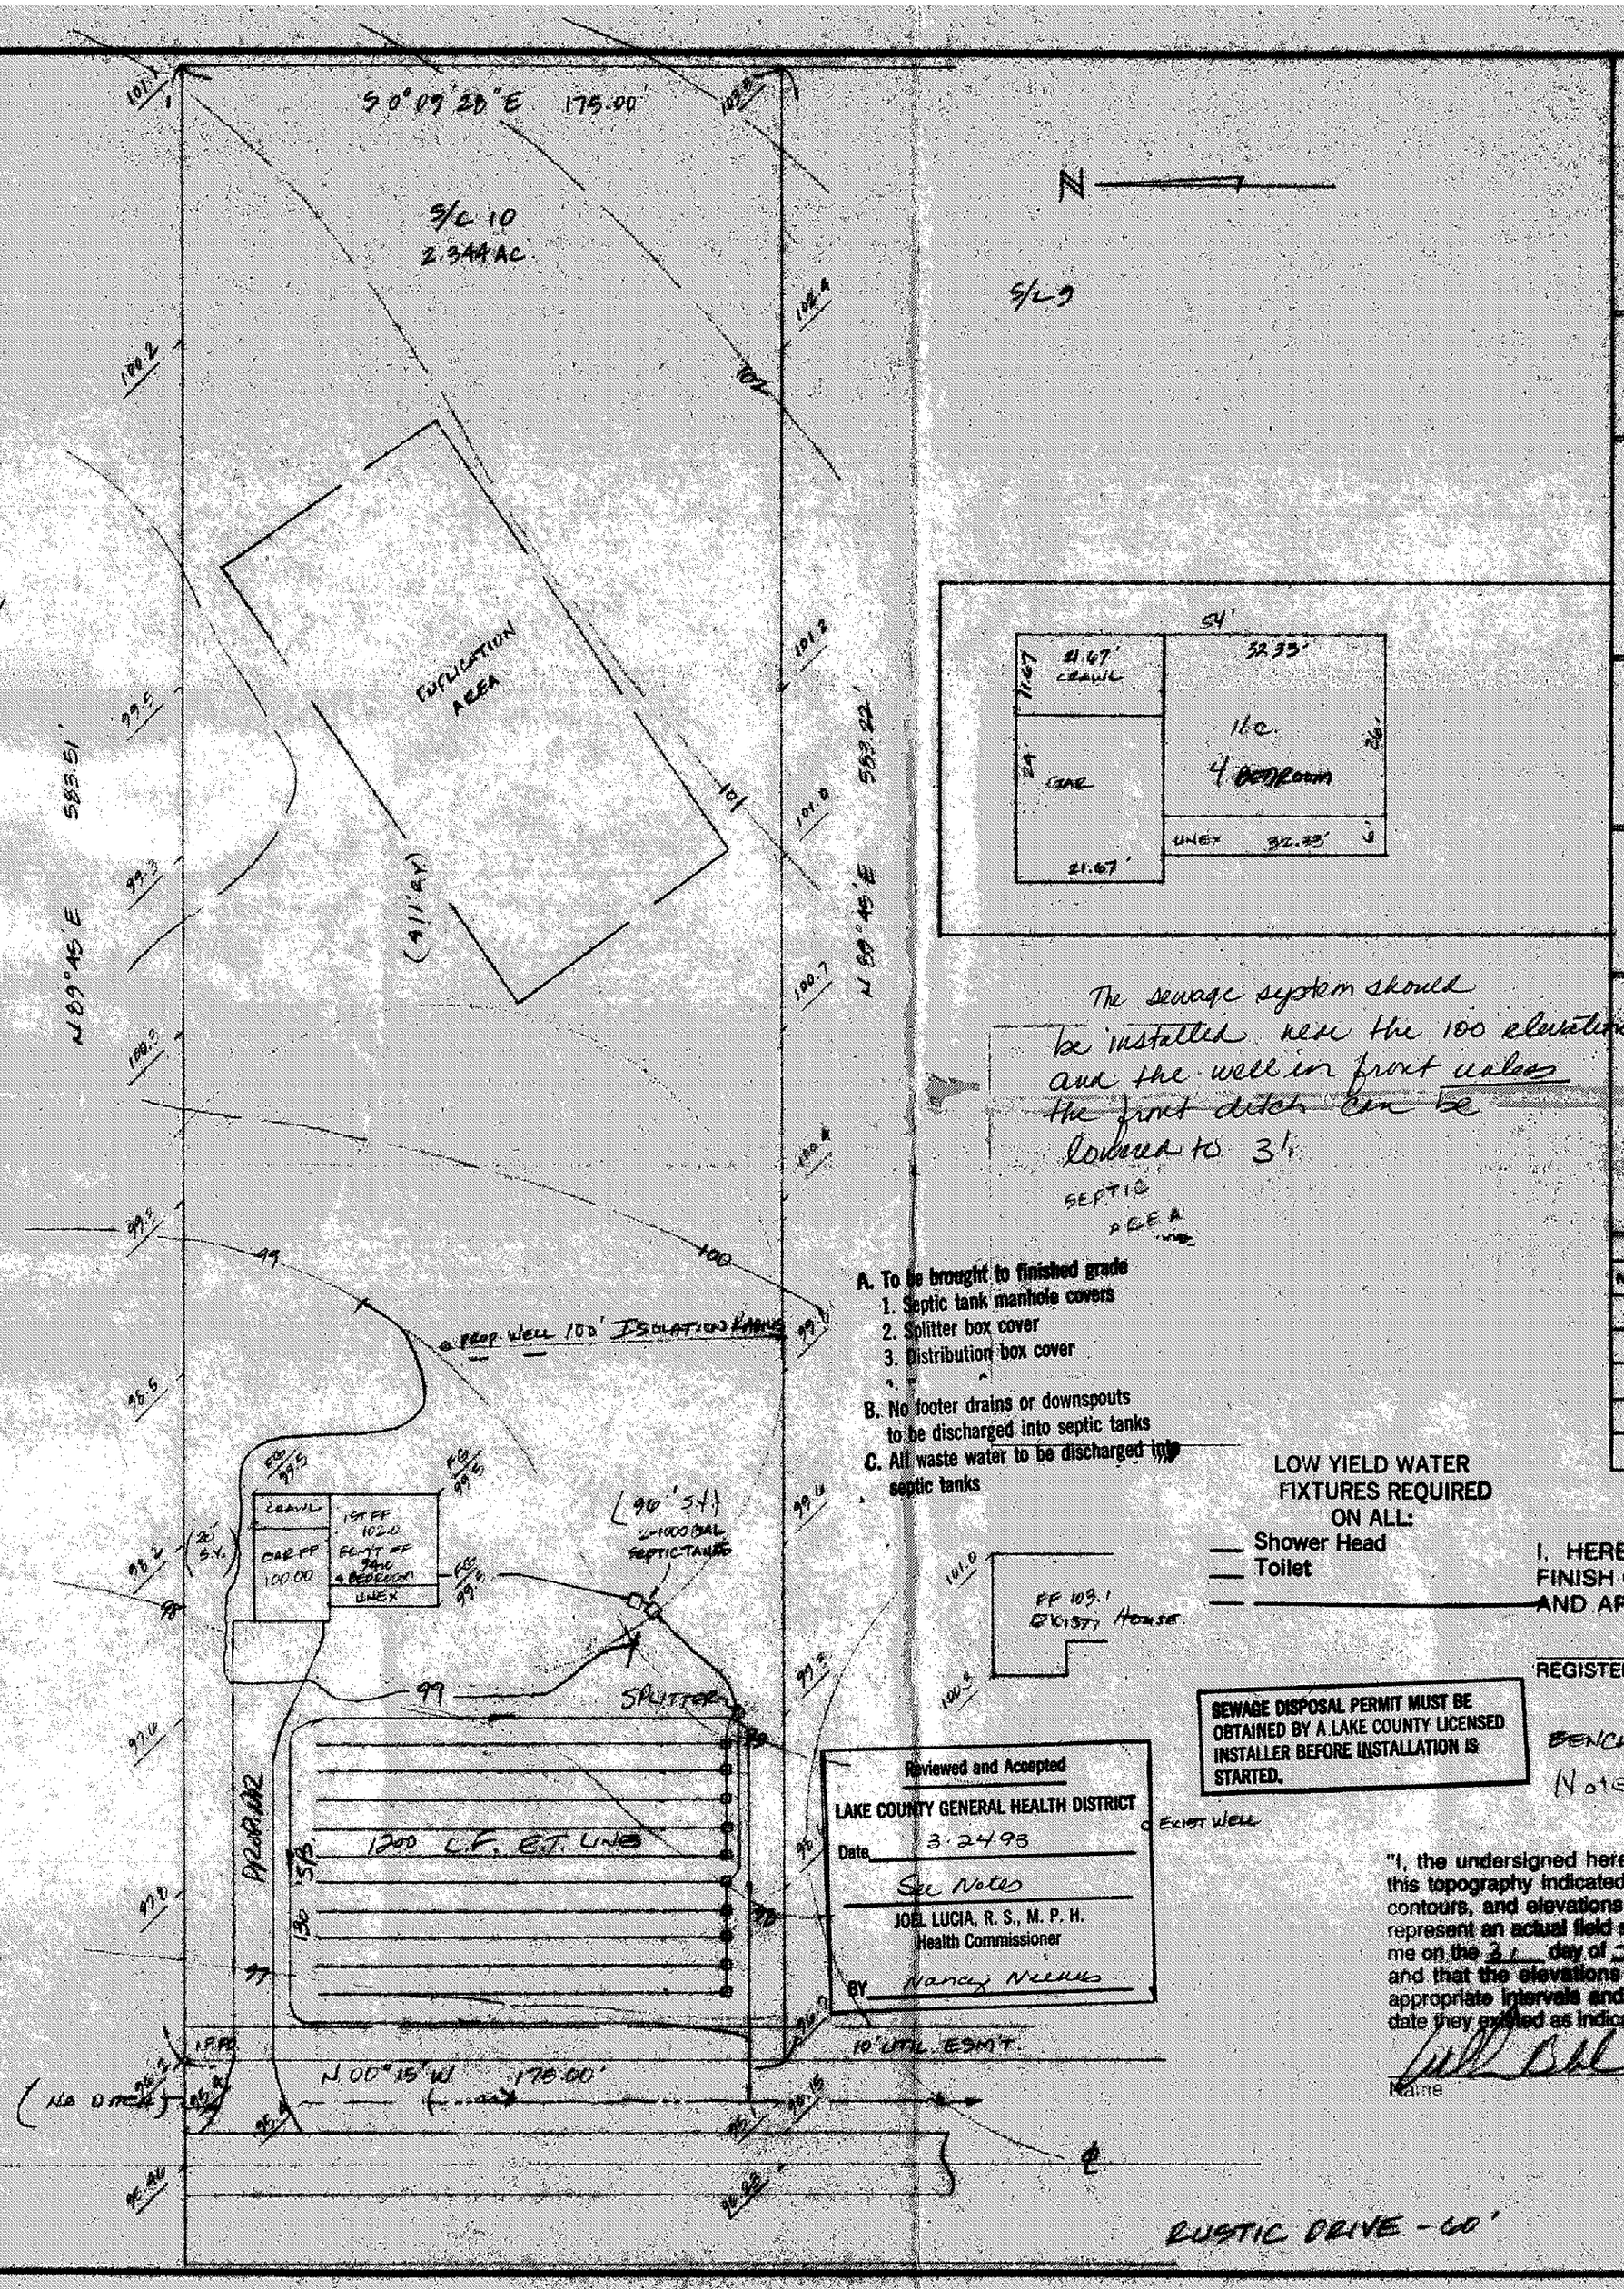

The sewage system should be installed near the 100 elevation and the well in front unless the front ditch can be lowered to 3'.

SEPTIC AREA

A. To be brought to finished grade
1. Septic tank manhole covers
2. Splitter box cover
3. Distribution box cover

B. No footer drains or downspouts to be discharged into septic tanks

C. All waste water to be discharged into septic tanks

LOW YIELD WATER FIXTURES REQUIRED ON ALL:
__ Shower Head
__ Toilet
__ _____

SEWAGE DISPOSAL PERMIT MUST BE OBTAINED BY A LAKE COUNTY LICENSED INSTALLER BEFORE INSTALLATION IS STARTED.

Reviewed and Accepted
LAKE COUNTY GENERAL HEALTH DISTRICT
Date 3-24-93
See Notes
JOEL LUCIA, R. S., M. P. H.
Health Commissioner
BY Nancy Neeus

"AS BUILT" CERTIFICATION

I, HEREBY CERTIFY THAT THE CIRCLED GRADES ARE EXISTING FINISH GRADES CHECKED IN THE FIELD ON _____, 19__ AND ARE CORRECT TO THE BEST OF MY KNOWLEDGE AND BELIEF.

REGISTERED SURVEYOR — REG. NO.

BENCHMARK: ℄-℄ RUSTIC & SPRING DRIVES 100.00'
NOTE: Curtain Drain to R/W Ditch Critical to be verified by Septic Installer

"I, the undersigned hereby certify that this topography indicated by 6", 1' or 2' contours, and elevations shown hereon represent an actual field survey made by me on the 31 day of July, 1992 and that the elevations were taken at appropriate intervals and that as of that date they existed as indicated hereon."

Name — Reg. No. P.S. 6528

LEROY TOWNSHIP
Zoning Approved
2000
Zoning Inspector

STATE OF OHIO — WILLIAM C. BABCOCK — REGISTERED SURVEYOR

Grading Plan Approved as shown and/or noted
THOMAS P. GILLES, P.E.
Lake County Engineer
By GJH Date 3-24-93