TAYLOR ROAD 60'

N. 01°30'43" E. 132.00'

950.00

30.03'

I.P. FND.

946.7 DIT.

950.2

951.3

951.3

951.7

951.6

249.18'

I.P. FND.

890.00'
S. 88°47'19" W.

950.

940.

930.

930

940

NORTH

132.00'
S 01°30'43" W.

950.0

951

6" P.V.C. FTG. DRAIN @ ±0.50%

20' S.E.

952.

953

954

692' REAR

100' ± ELEVATION

20' WIDE DRIVE GRAVEL

POLE BARN
F.F.
951.33
40'

F.L. 949.0

953.43

953.43

GAR. SLAB 954.67
16'0"

#6061

FIN. 1 ST. FL. 956.67
BSMT 947.67
3 BED RM.

17'3"

14'9"

11'8"

65'

4" PVC 1.0% MIN

954.8

951.58

1000 GAL. SEPTIC TANKS

SPLASH BLOCK ROOF DRAIN TYP.

EXISTING WELL

DUPLICATION AREA

THERESA-MICHAEL KOCH
P.P.# 7A-020-015
3.9184 AC.

150' S/B

1000 LIN FT EVT.
10 EA @ 100'

LINES TO FOLLOW CONTOURS

10
9
8
7
6
5
4
3
2
1

948.8
949.1
949.0
949.1
949.3
949.4
950.1
950.4
950.7
951.0
951.3

F.L. 952.8

DIST. BOX (TYP.)
SPLITTER
100' ISOLATION

F.L. 951.0'

F.L. out 948.2

F.L. out 954.4

953.65

953.5

955.2

955.0

954.3

257.18'

I.P. FND.

950

890.00'
S. 88°47'19" W.

PROFILE HOR. 1" = 30'
VERT. 1" = 5'

960

955

950

LINE 1

CURTAIN DRAIN

C.O. OUT 952.2

C.O. 952.0

1¼" DISCHARGE

BSMT 947.67

PROP. HOUSE

956.67 F.F.

F.L. 952.8

INV 952.2

INV 953.1

F.L. OUT 953.8

SPLITTER

2 EA 1000 GAL. SEPTIC TANKS

GRINDER PUMP TO BE INSTALLED IF BATHROOM IS CONSTRUCTED IN BASEMENT PUMP AS PER L.C.D.H.

"I, the undersigned hereby certify that this topography, indicated by 6", (1') or 2' contours, and elevations shown hereon represent an actual field survey made by me on the 10 day of OCTOBER, 1995 and that the elevations were taken at appropriate intervals and that as of that date they existed as indicated hereon."

John C. Skonieczny — R.S. 6056
Name — Reg. No

2 WORKING DAYS BEFORE YOU DIG
CALL TOLL FREE 800-362-2764

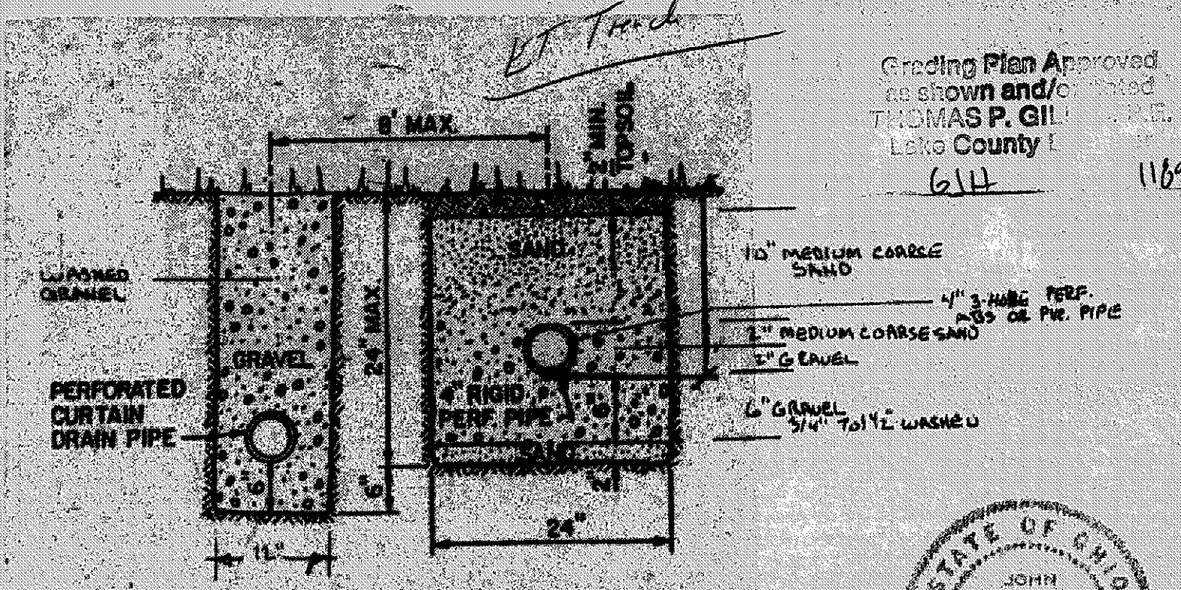

TRENCH DETAIL

Grading Plan Approved as shown and/or noted
THOMAS P. GILL
Lake County E.
6/17

Reviewed and Accepted
LAKE COUNTY GENERAL HEALTH DISTRICT
Date 11-6-95
see adjustments
JOEL LUCIA, R.S., M.P.H.
Health Commissioner
BY J. Lindsay

11695

I CERTIFY THAT THIS PLAN WAS PREPARED BY ME AND IS CORRECT TO THE BEST OF MY KNOWLEDGE AND BELIEF
John C. Skonieczny
REG. SURVEYOR 6056

STATE OF OHIO
JOHN CLOUD SKONIECZNY
6056
REGISTERED SURVEYOR

JOHN C. SKONIECZNY
7739 VIEWMOUNT DR.
PAINESVILLE, OHIO 44077
PH. 352-7742

— — — EXISTING GRADES
——— PROPOSED GRADES
~~~~~ SWALE

REVISIONS
⚠ NOV-1-95 DELETE PUMP CHAMBER MAKE TNKS. SHOW ELEV. C. DRAINS. FTG. DRAINS STATION OUT

SEWAGE DISPOSAL PERMIT MUST BE OBTAINED BY A LAKE COUNTY LICENSED INSTALLER BEFORE INSTALLATION IS STARTED.

A. To be brought to finished grade
1. Septic tank manhole covers
2. Splitter box cover
3. Distribution box cover
B. No footer drains or downspouts to be discharged into septic tanks
C. All waste water to be discharged into septic tanks

LOW YIELD WATER FIXTURES REQUIRED ON ALL:
— Shower Head
— Toilet

SITE PLAN FOR: MIKE & TERRY KOCH
45 MELROSE DR. PAINESVILLE, OHIO 357-8251

SCALE: 1"=30'	APPROVED BY	DRAWN BY DTS
DATE: OCT. 1995		

DRAWING NUMBER
~~~~~