TOPOGRAPHY & IMPROVEMENT PLAN FOR

NORTHERN INDUSTRIES

MADISON TOWNSHIP ÷ LAKE COUNTY ÷ OHIO

SUBLOT 102 IN THE MADISON GOLF LAKELANDS SUBDIVISION

VOLUME E PAGE 68

SCALE: 1"=20'

APRIL 1977

CIVIL ENGINEER

STATE OF OHIO

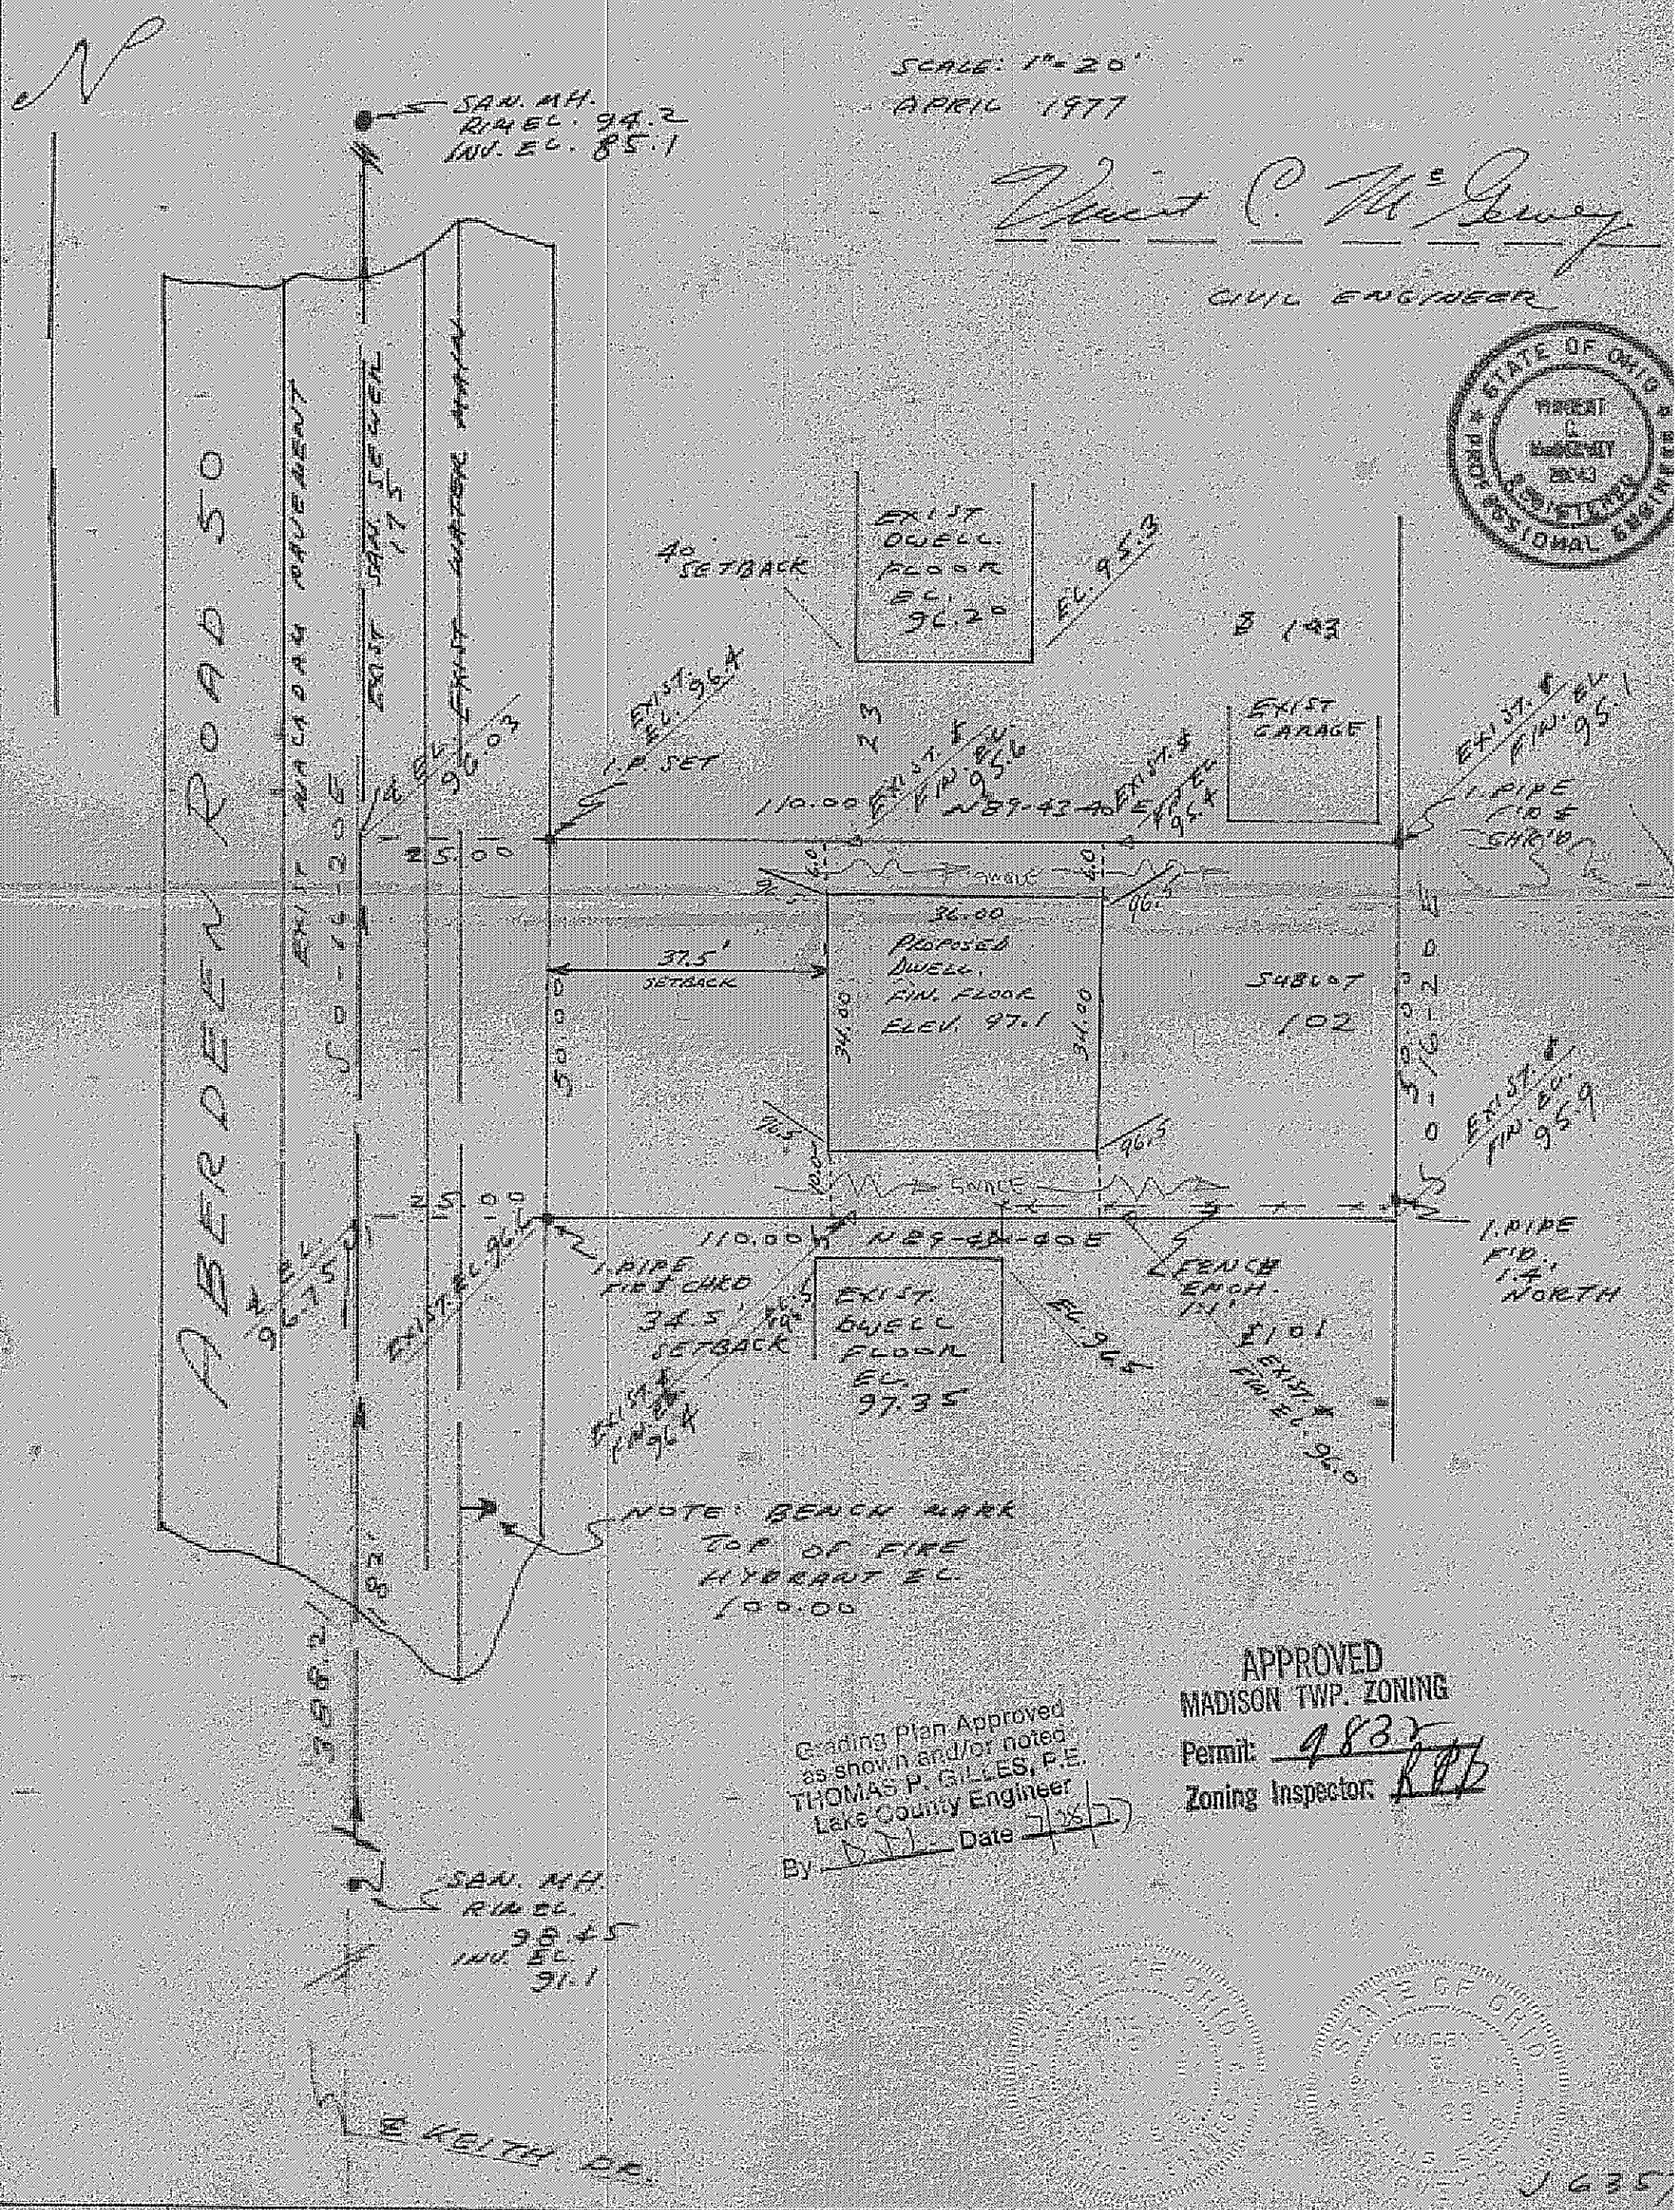

Grading plan Approved as shown and/or noted
THOMAS P. GILLES, P.E.
Lake County Engineer
By _____ Date _____

APPROVED
MADISON TWP. ZONING
Permit: 9832
Zoning Inspector: KPB

STATE OF OHIO