SITE PLAN
for
JOE WELCH
#L52853 MADISON BEACH SUB.
MADISON TOWNSHIP
LAKE CO. OHIO
1" = 30' Mar 1979

Milton A. Boomhower
Reg. Surveyor 4247

APPROVED
MADISON TWP. ZONING
Permit 10389
Zoning Inspector
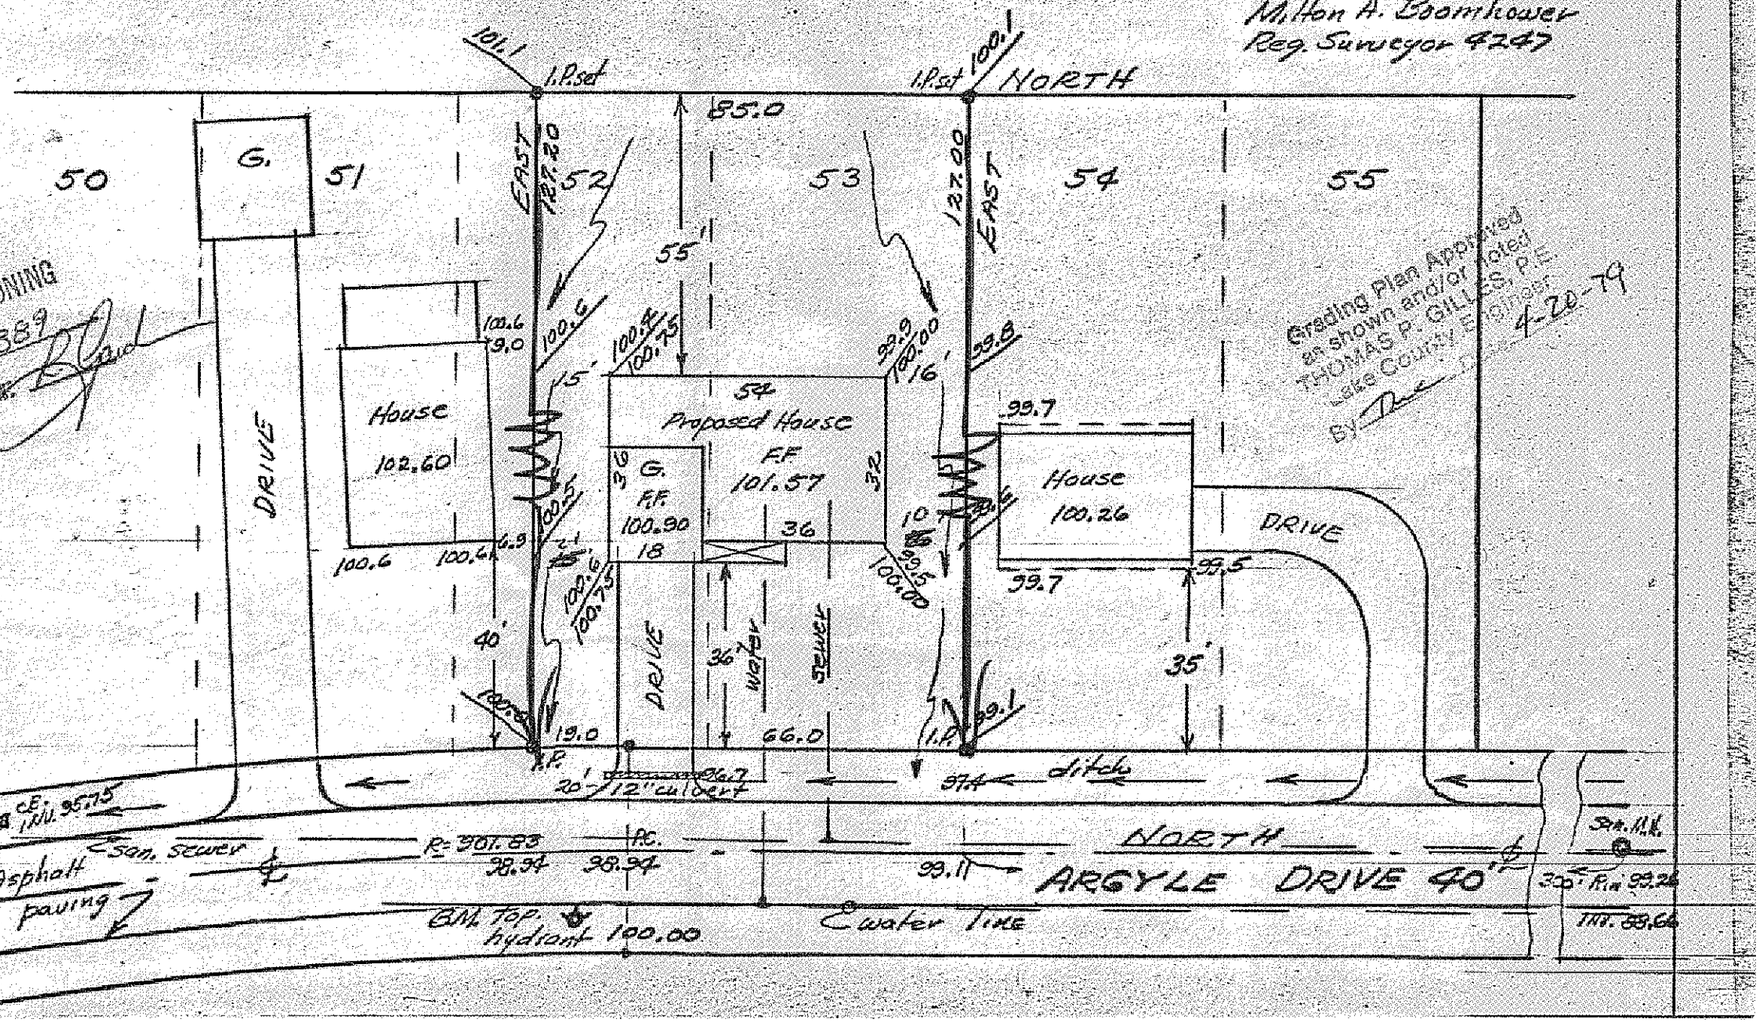
Grading Plan Approved as shown and/or noted
THOMAS P. GILLESS, P.E.
Lake County Engineer
By 4-20-79