APPROVED
MADISON TWP. ZONING
Permit: 8449
Zoning Inspector: NS

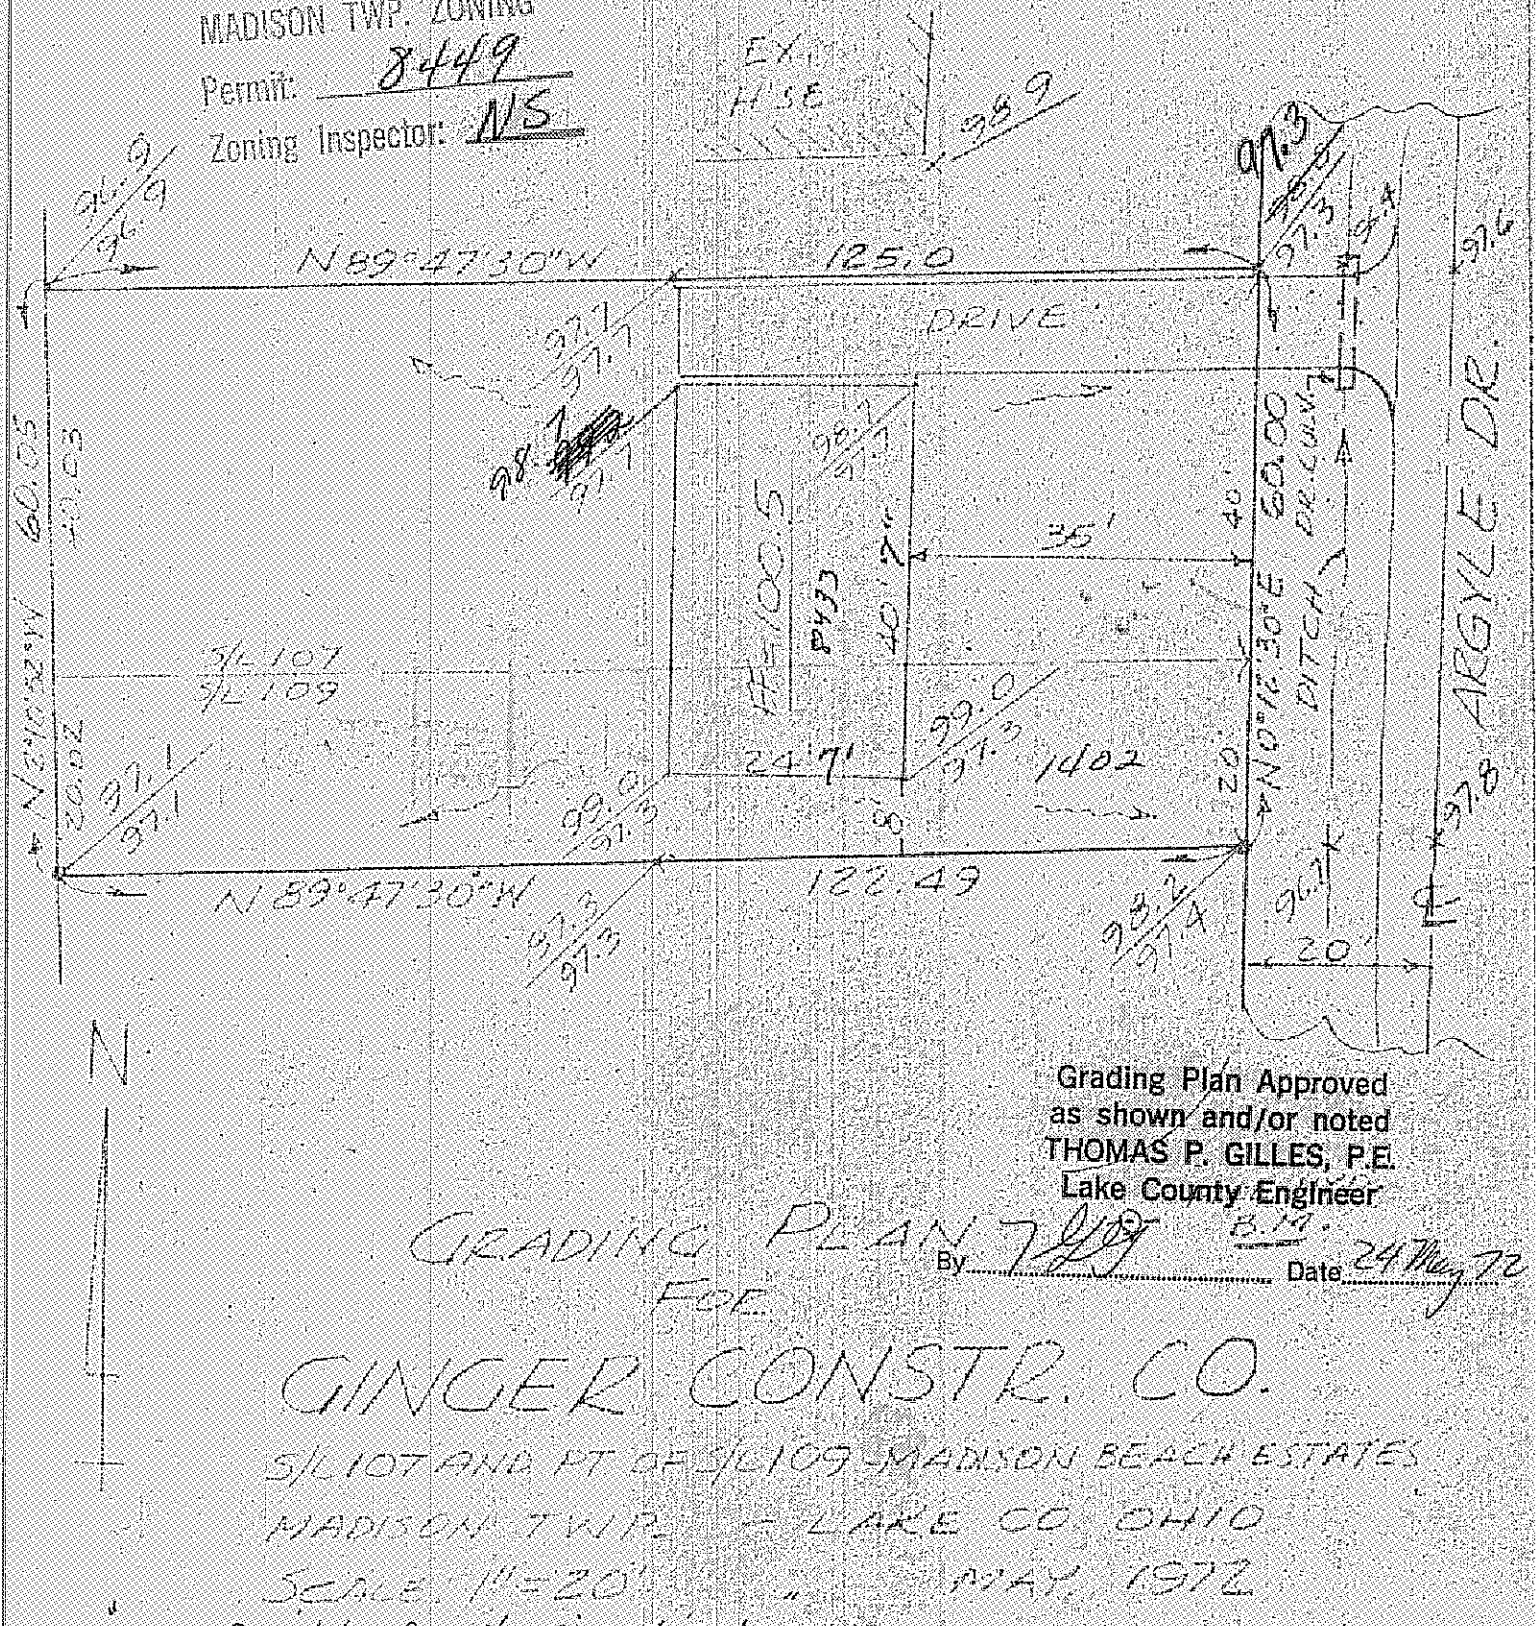

Grading Plan Approved
as shown and/or noted
THOMAS P. GILLES, P.E.
Lake County Engineer
By [signature] B.M. Date 24 May 72

GRADING PLAN
FOR
GINGER CONSTR. CO.
S/L 107 AND PT OF S/L 109 - MADISON BEACH ESTATES
MADISON TWP. - LAKE CO. OHIO
SCALE 1" = 20' " MAY 1972

AS. Built Certification
I HEREBY certify that the circled GRADES ARE EXISTING Finish GRADES checked in the Field on 197 BY Survey is correct to the Best of My Knowledge And Belief.

Registered Surveyor No.

FULLERTON-KERR AND ASSOCIATES
REGISTERED ENGINEERS AND SURVEYORS
PAINESVILLE, OHIO

NOTE: UNDERLINED EL. ARE FINISHED GRADE.
B.M. - TOP FIRE HYD. EL. 100.00

1402 ARGYLE DR