SITE PLAN
FOR
KEN JANIK

KNOWN AS BEING SUBLOT 53 OF THE ARCOLE ESTATES SUBDIVISION No. 2 AS RECORDED IN VOLUME J, PAGE 87 OF THE LAKE COUNTY PLAT RECORDS

TOWNSHIP OF MADISON
COUNTY OF LAKE - STATE OF OHIO

NOTES: TEMPORARY STONE TO BE INSTALLED AT DRIVE ENTRANCE.

SEWER AND WATER CONNECTIONS ARE TO BE VERIFIED AT TIME OF CONSTRUCTION.

SPLASHBLOCKS ARE TO BE INSTALLED AT ALL DOWNSPOUTS.

EXISTING ELEVATIONS
PROPOSED ELEVATION

590 EXISTING CONTOUR

(590) (PROPOSED CONTOUR)

"I, THE UNDERSIGNED HEREBY CERTIFY THAT THE TOPOGRAPHY SHOWN HEREON, INDICATED BY 1 FOOT CONTOURS AND ELEVATIONS REPRESENTS AN ACTUAL FIELD TOPOGRAPHIC SURVEY MADE BY ME ON SEPTEMBER 19, 2011 AND THAT THE ELEVATIONS WERE TAKEN AT APPROPRIATE INTERVALS AND THAT AS OF THAT DATE THEY EXISTED AS INDICATED WEREON."

JAMES A. ZIEMBA, PROFESSIONAL SURVEYOR #7094
BENCHMARK SURVEY COMPANY
5964 SOUTH RIDGE ROAD
MADISON, OHIO 44057
SEPTEMBER 19, 2011
440-428-8599

STATE OF OHIO
JAMES A. ZIEMBA
7094
REGISTERED
PROFESSIONAL SURVEYOR

This Site Plan is APPROVED AS SHOWN AND/OR NOTED
LAKE COUNTY
STORMWATER MANAGEMENT DEPT.
By L.S. Date 9/26/2011

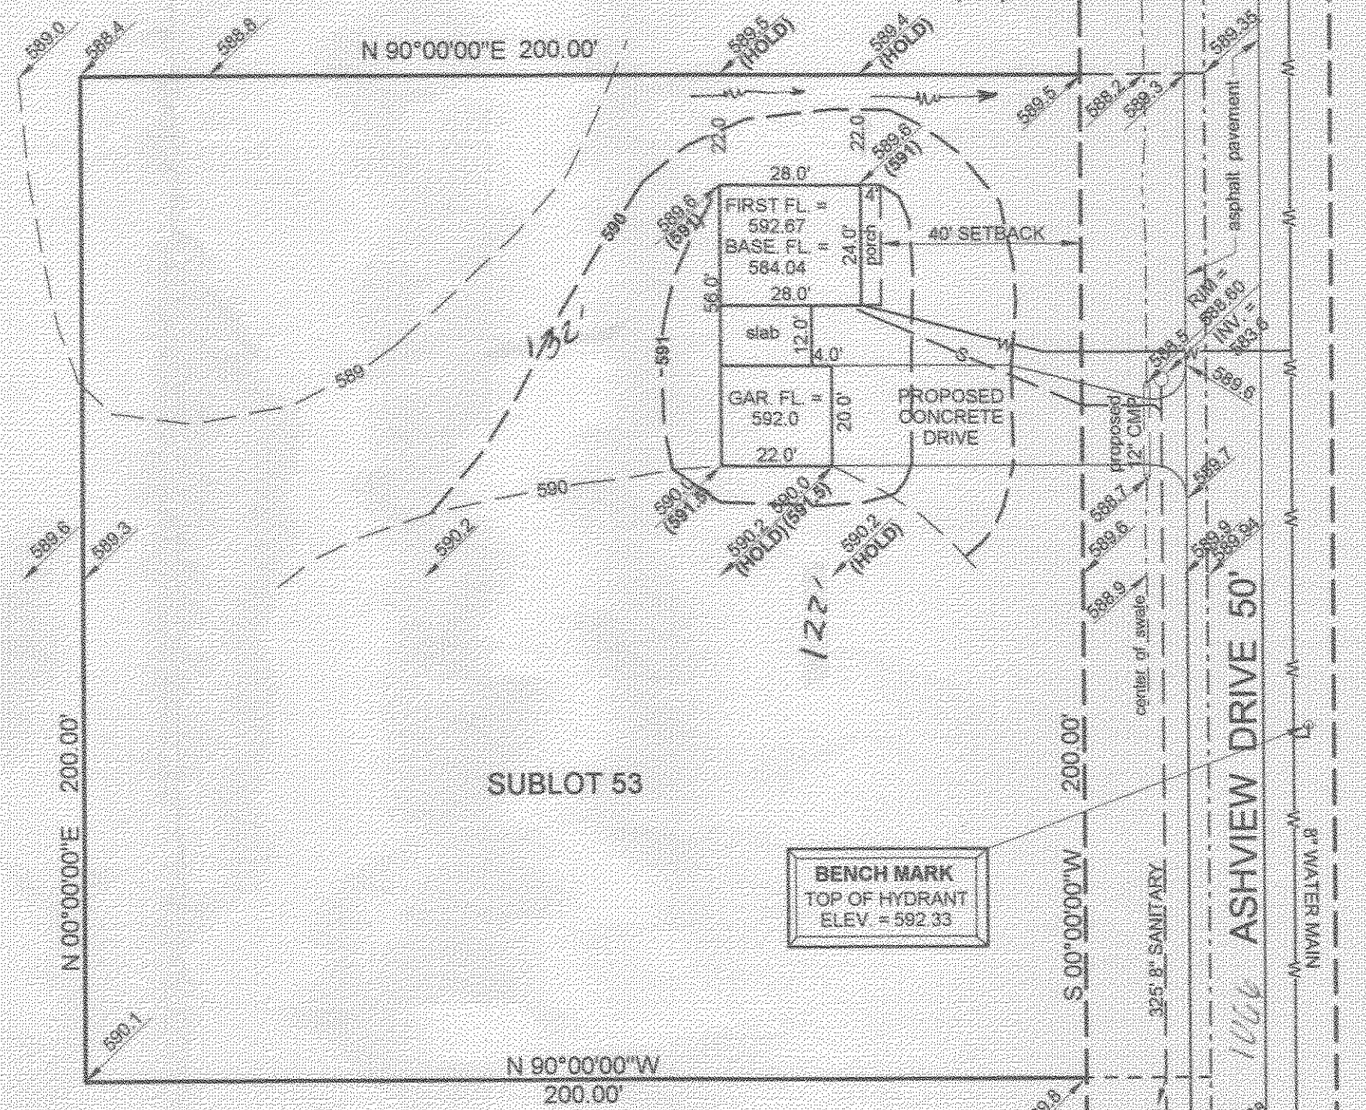

APPROVED
MADISON TOWNSHIP ZONING
DATE 9/2/11
BY JK Z-3808