# SITE PLAN
# SUBLOT 37
# LAKESHORE FARMS SUB.
Vol. X Pg. 17-1

Madison Twp. Lake Co.

1" = 20' 6-25-89


DEVELOPER
PENFIELD, Inc.
BILL SNIDER
BOX 488
MADISON, OHIO 44057
216-428-6662


APPROVED
MADISON TWP. ZONING
Permit: 12538
Zoning Inspector: JAL
JUN. 28 1989

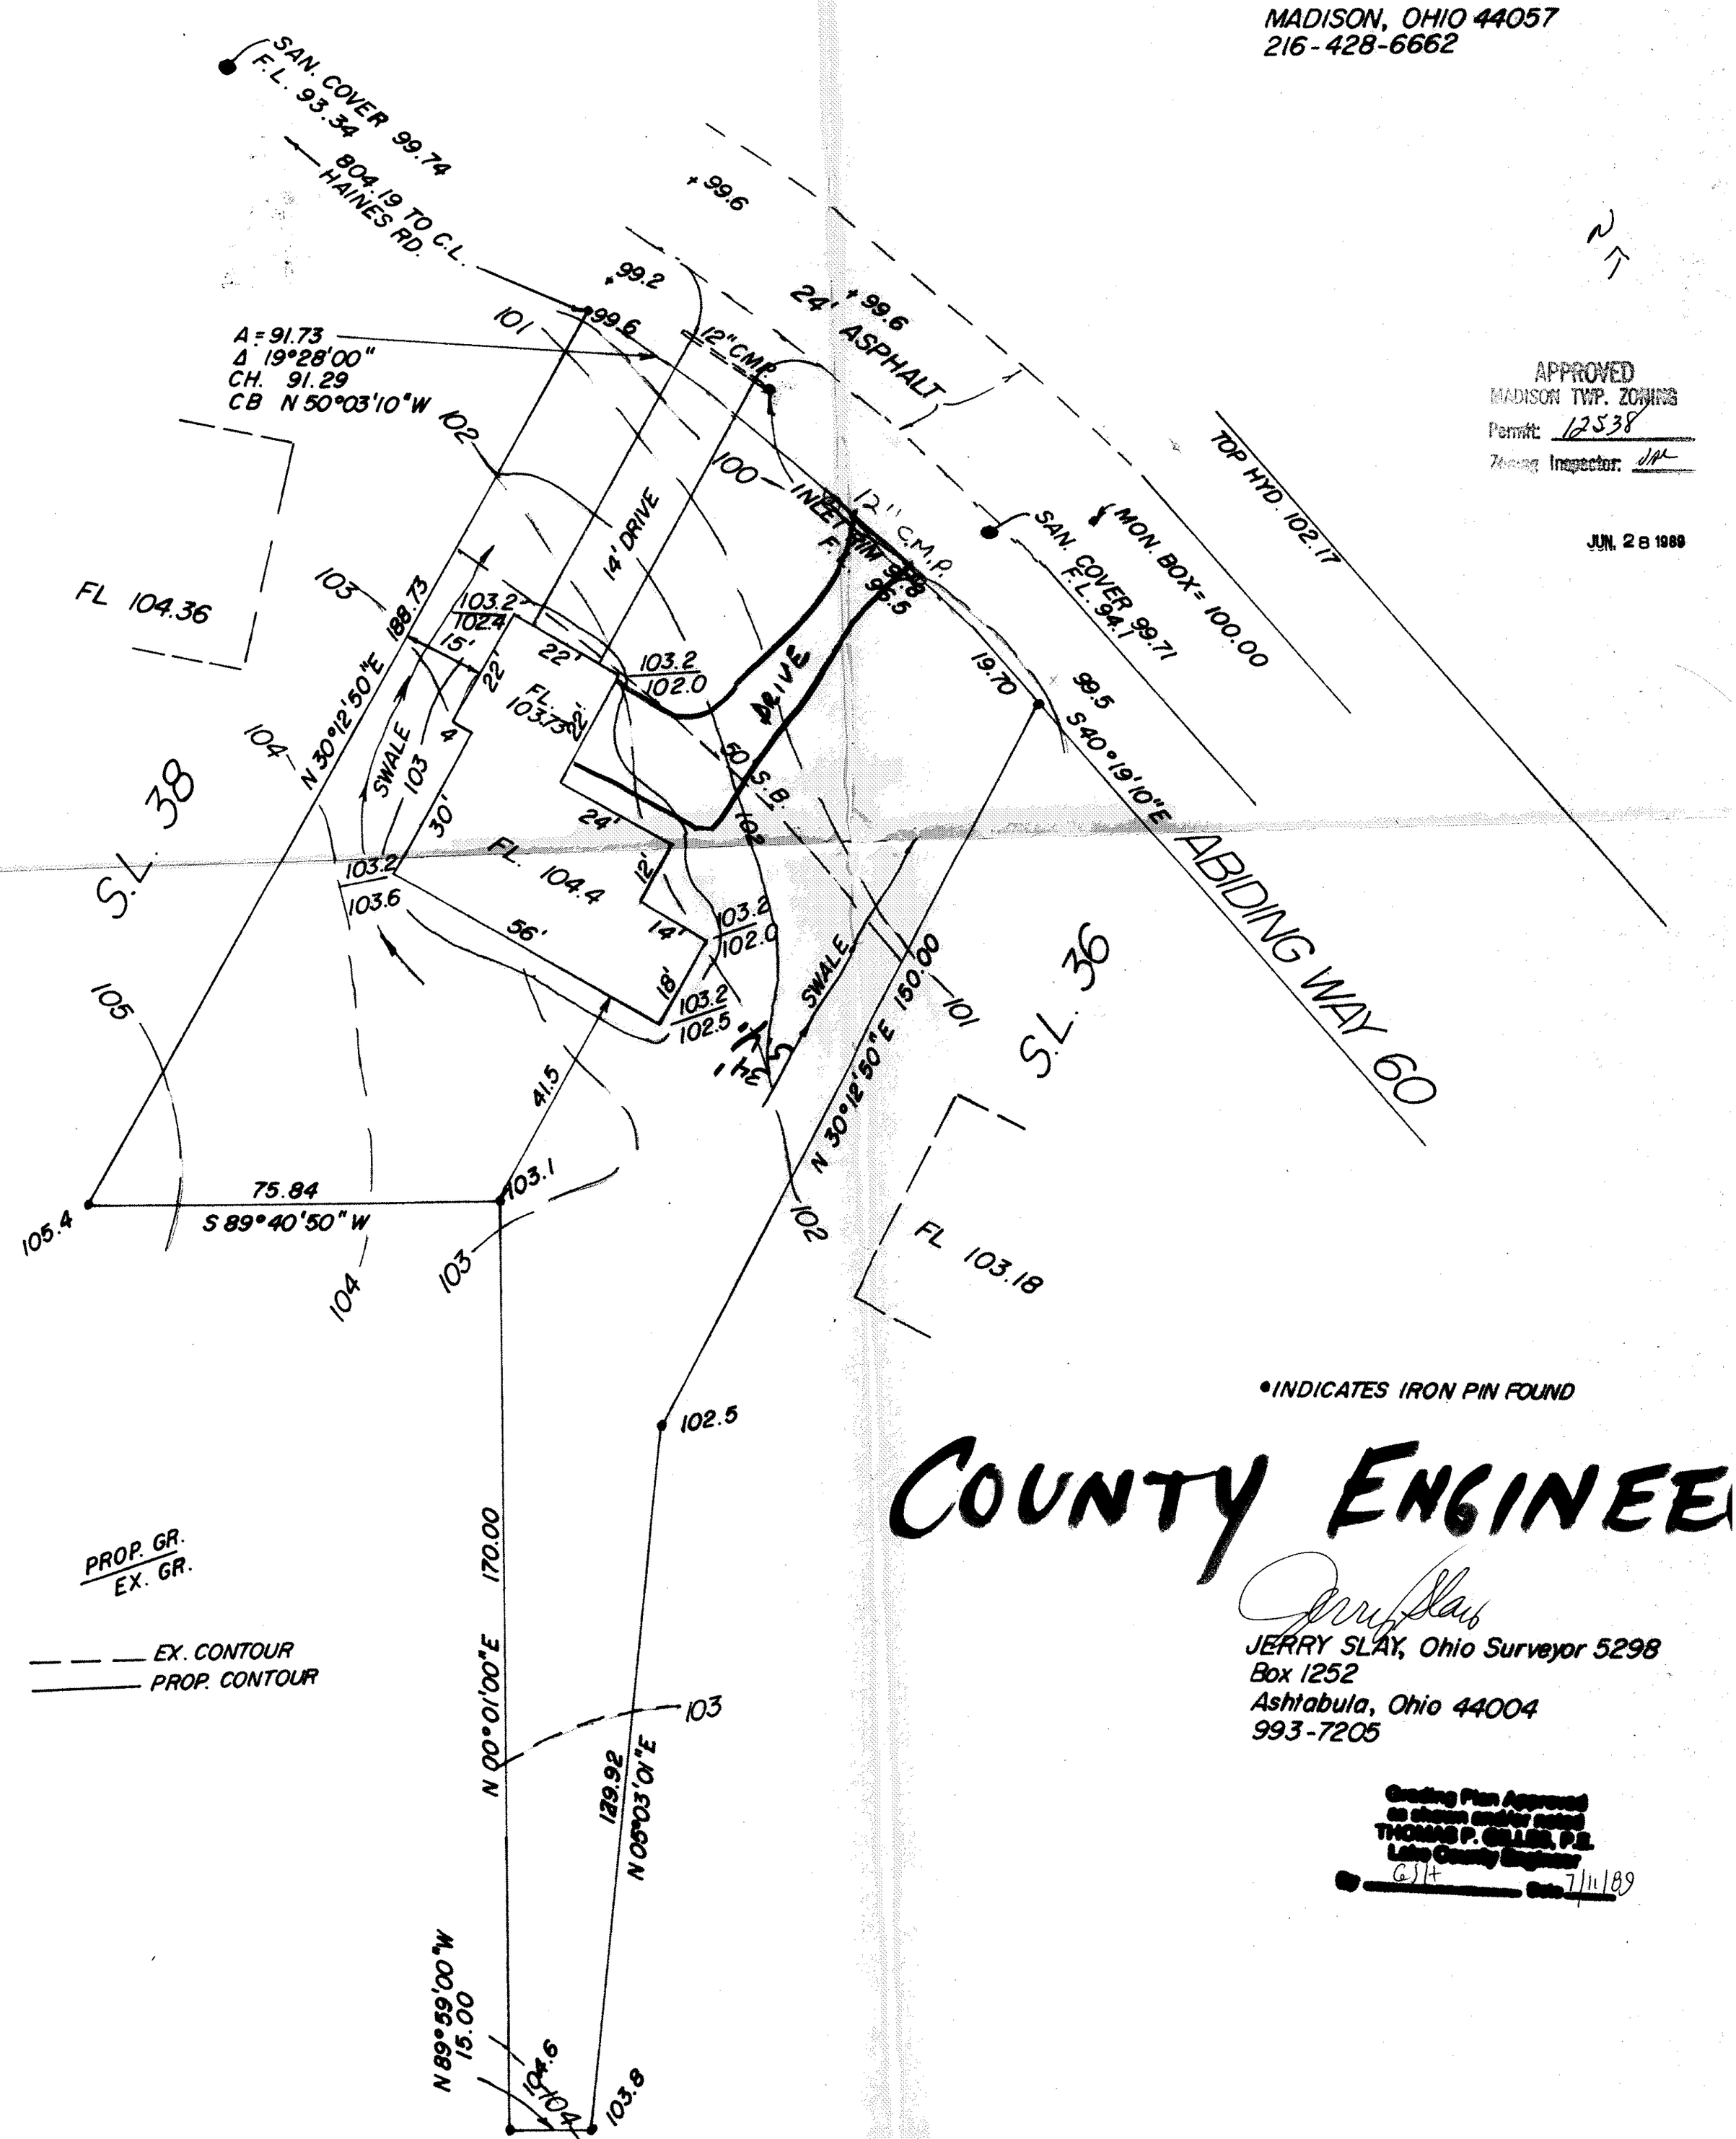


COUNTY ENGINEE


JERRY SLAY, Ohio Surveyor 5298
Box 1252
Ashtabula, Ohio 44004
993-7205


Grading Plan Approved as shown and/or noted
THOMAS P. GILLIS, P.E.
Lake County Engineer
By 6)1+ Date 7/11/89